

7.5chs.


JCO PROPERTIES INC.
4-9-06

LOT 2
37.16 Ac.
37.10

CREEK VIEW SECOND ADD.
Filed 4-25-74
Transfer Page 1462 T4

8-17-71

17
8

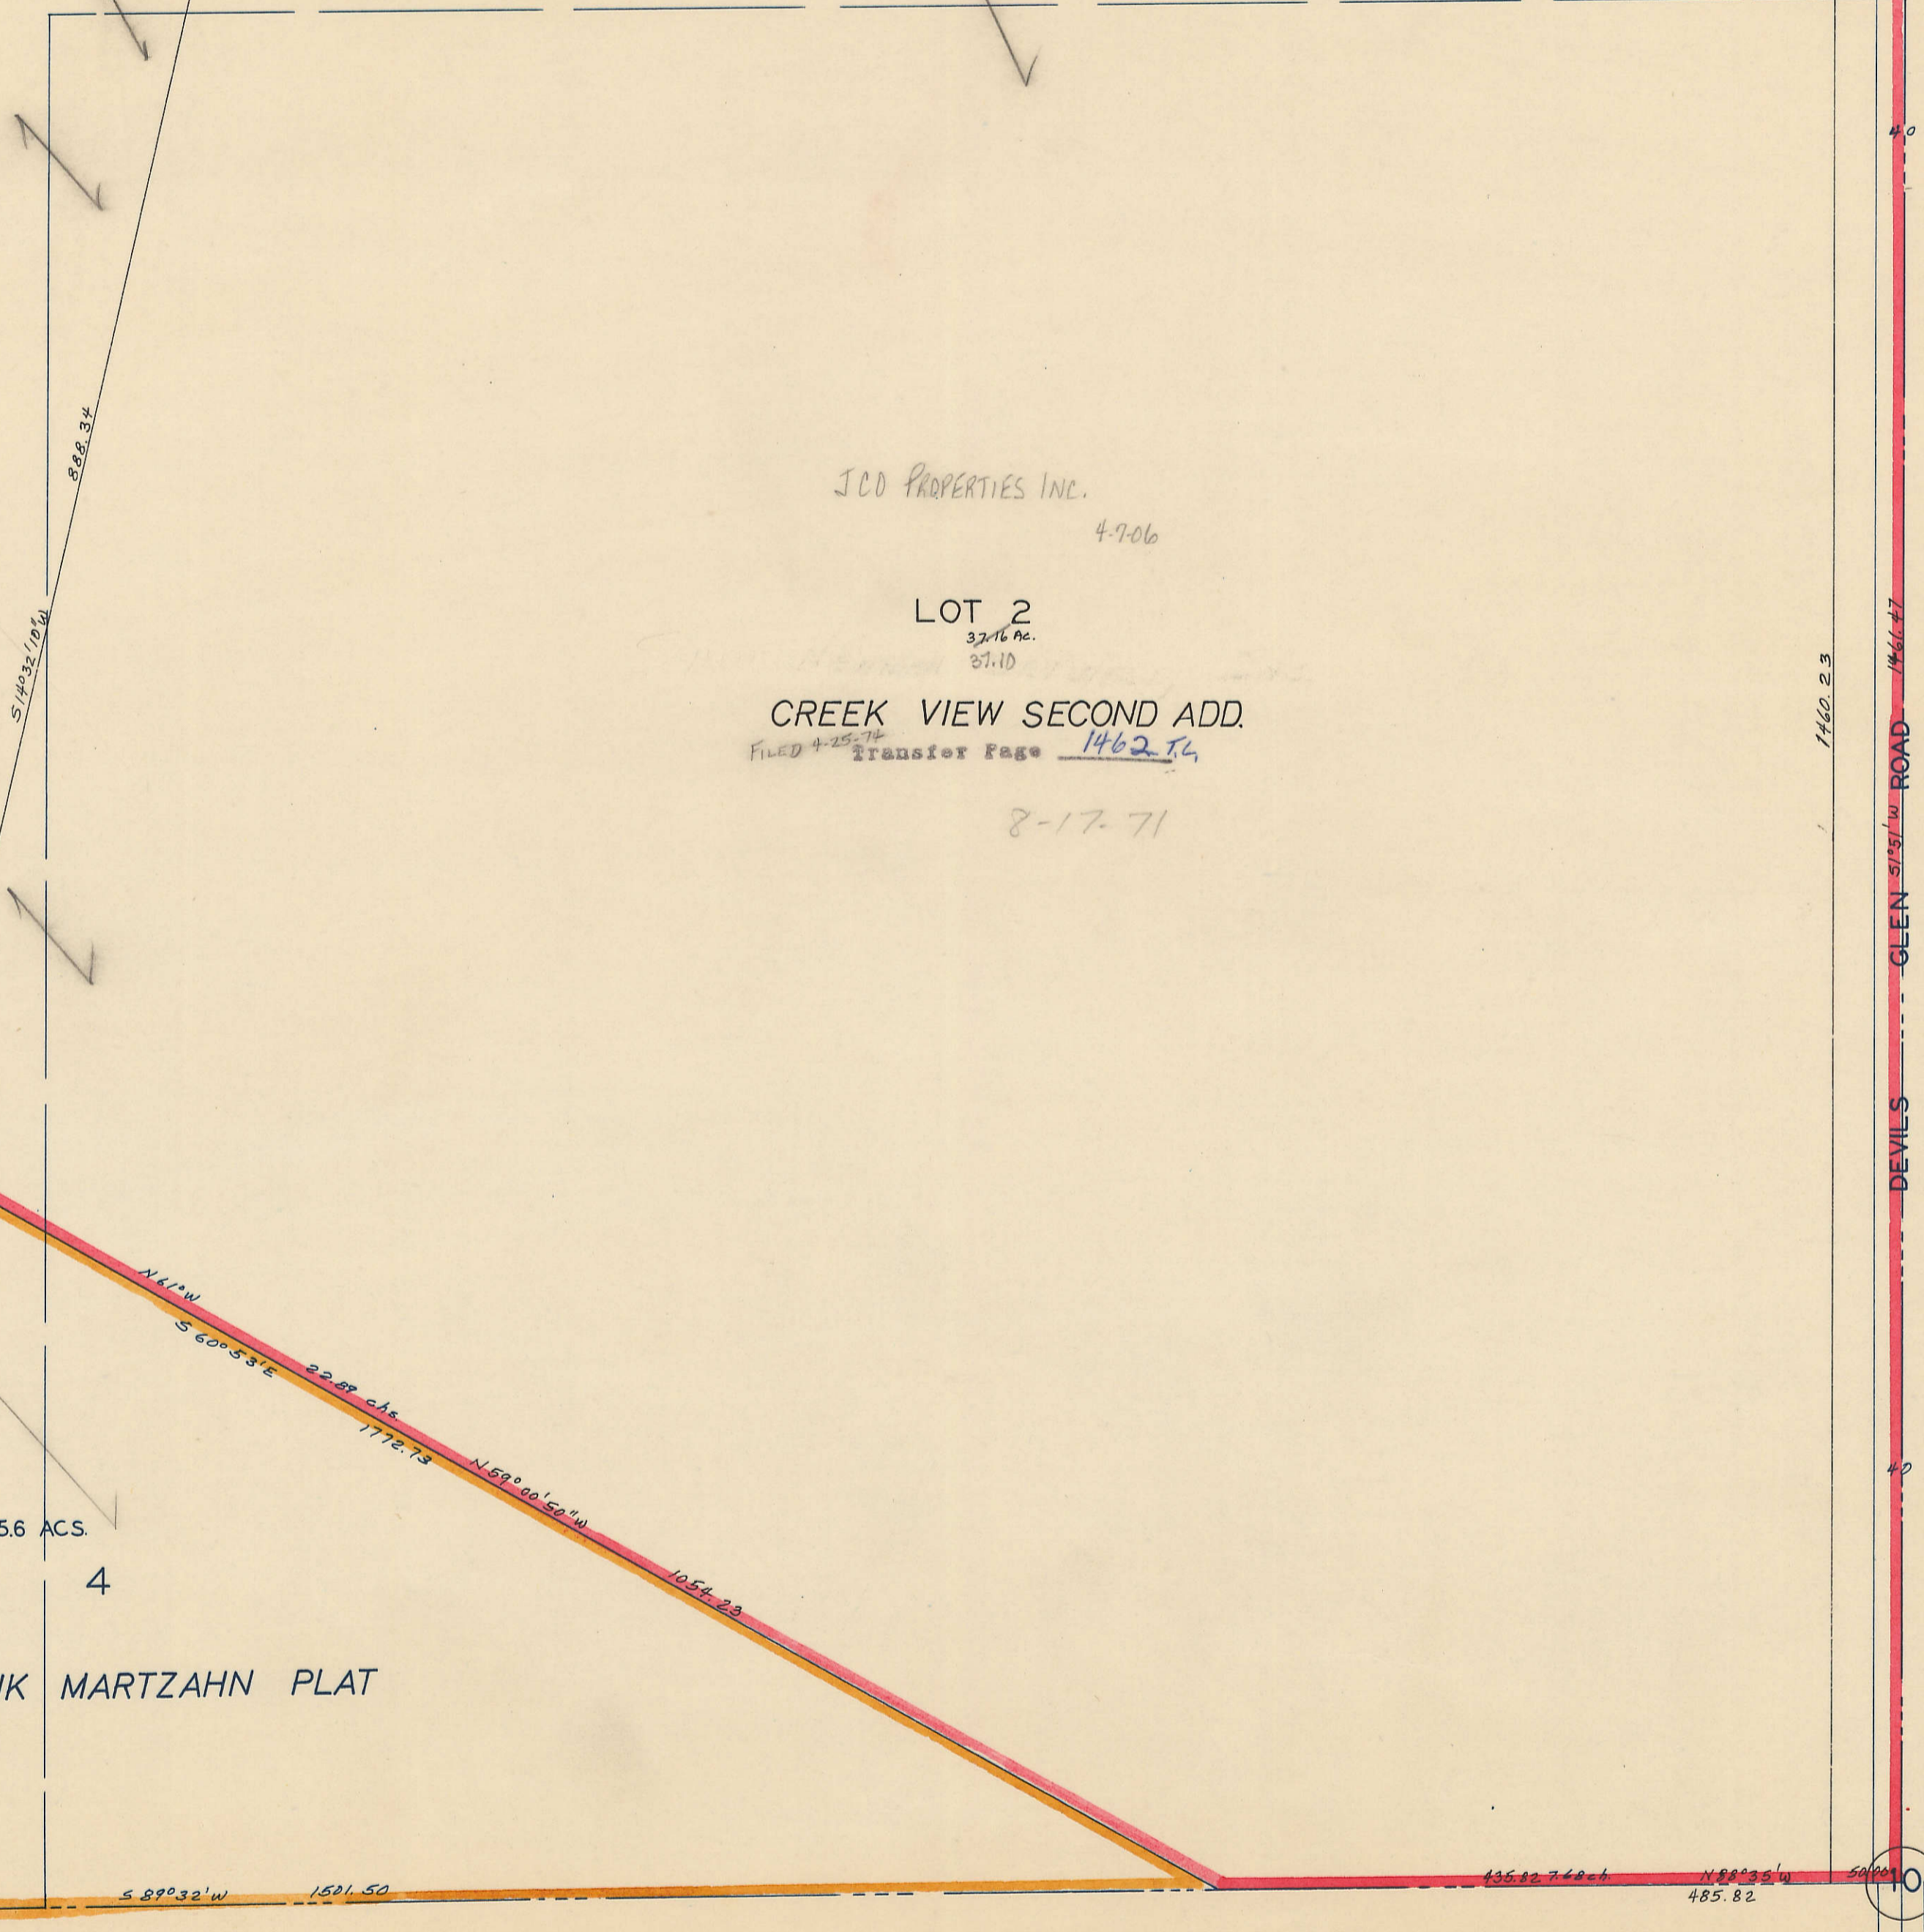

10

35

33