

26 25


25

25 30

ANNEXATIONS

I INCORP. 56
182 Misc. 456
201 Misc. 420
209 Misc. 76
10,561-74

SCALE: 1"=500'

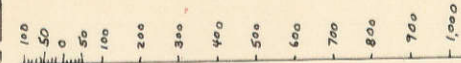

26 25
35 36

25 30
36 31

4.9 AC.
Lagoon

03

05

19

21

37


51

53

35 36

36 31

SEVENTH STREET WEST

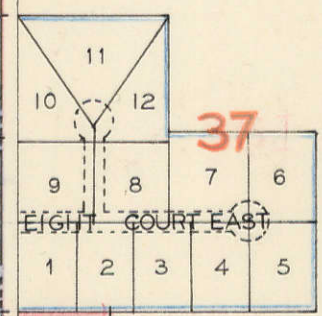

35 36
2 1

36 31
1 6

Donahue

I Inc. 56
182 Misc. 456
201 Misc. 420
209 Misc. 76
10,561-74

36 G

SEE NEW INDEX PAGE

6160.12
596.12

1774.4

267.49

1774.4

54

DONAHUE


Allens Grove Township
SCALE 200 FEET TO 1 INCH

SEE ALSO PAGE 36 ALLENS GROVE TWP.
7-2-74 ANNEX (VARIES FROM PREVIOUS
CORP. BOUNDARY LINES)

CORPORATION LINE

N-5162.55

SEE ALSO PAGE 36 ALLENS GROVE TOWNSHIP

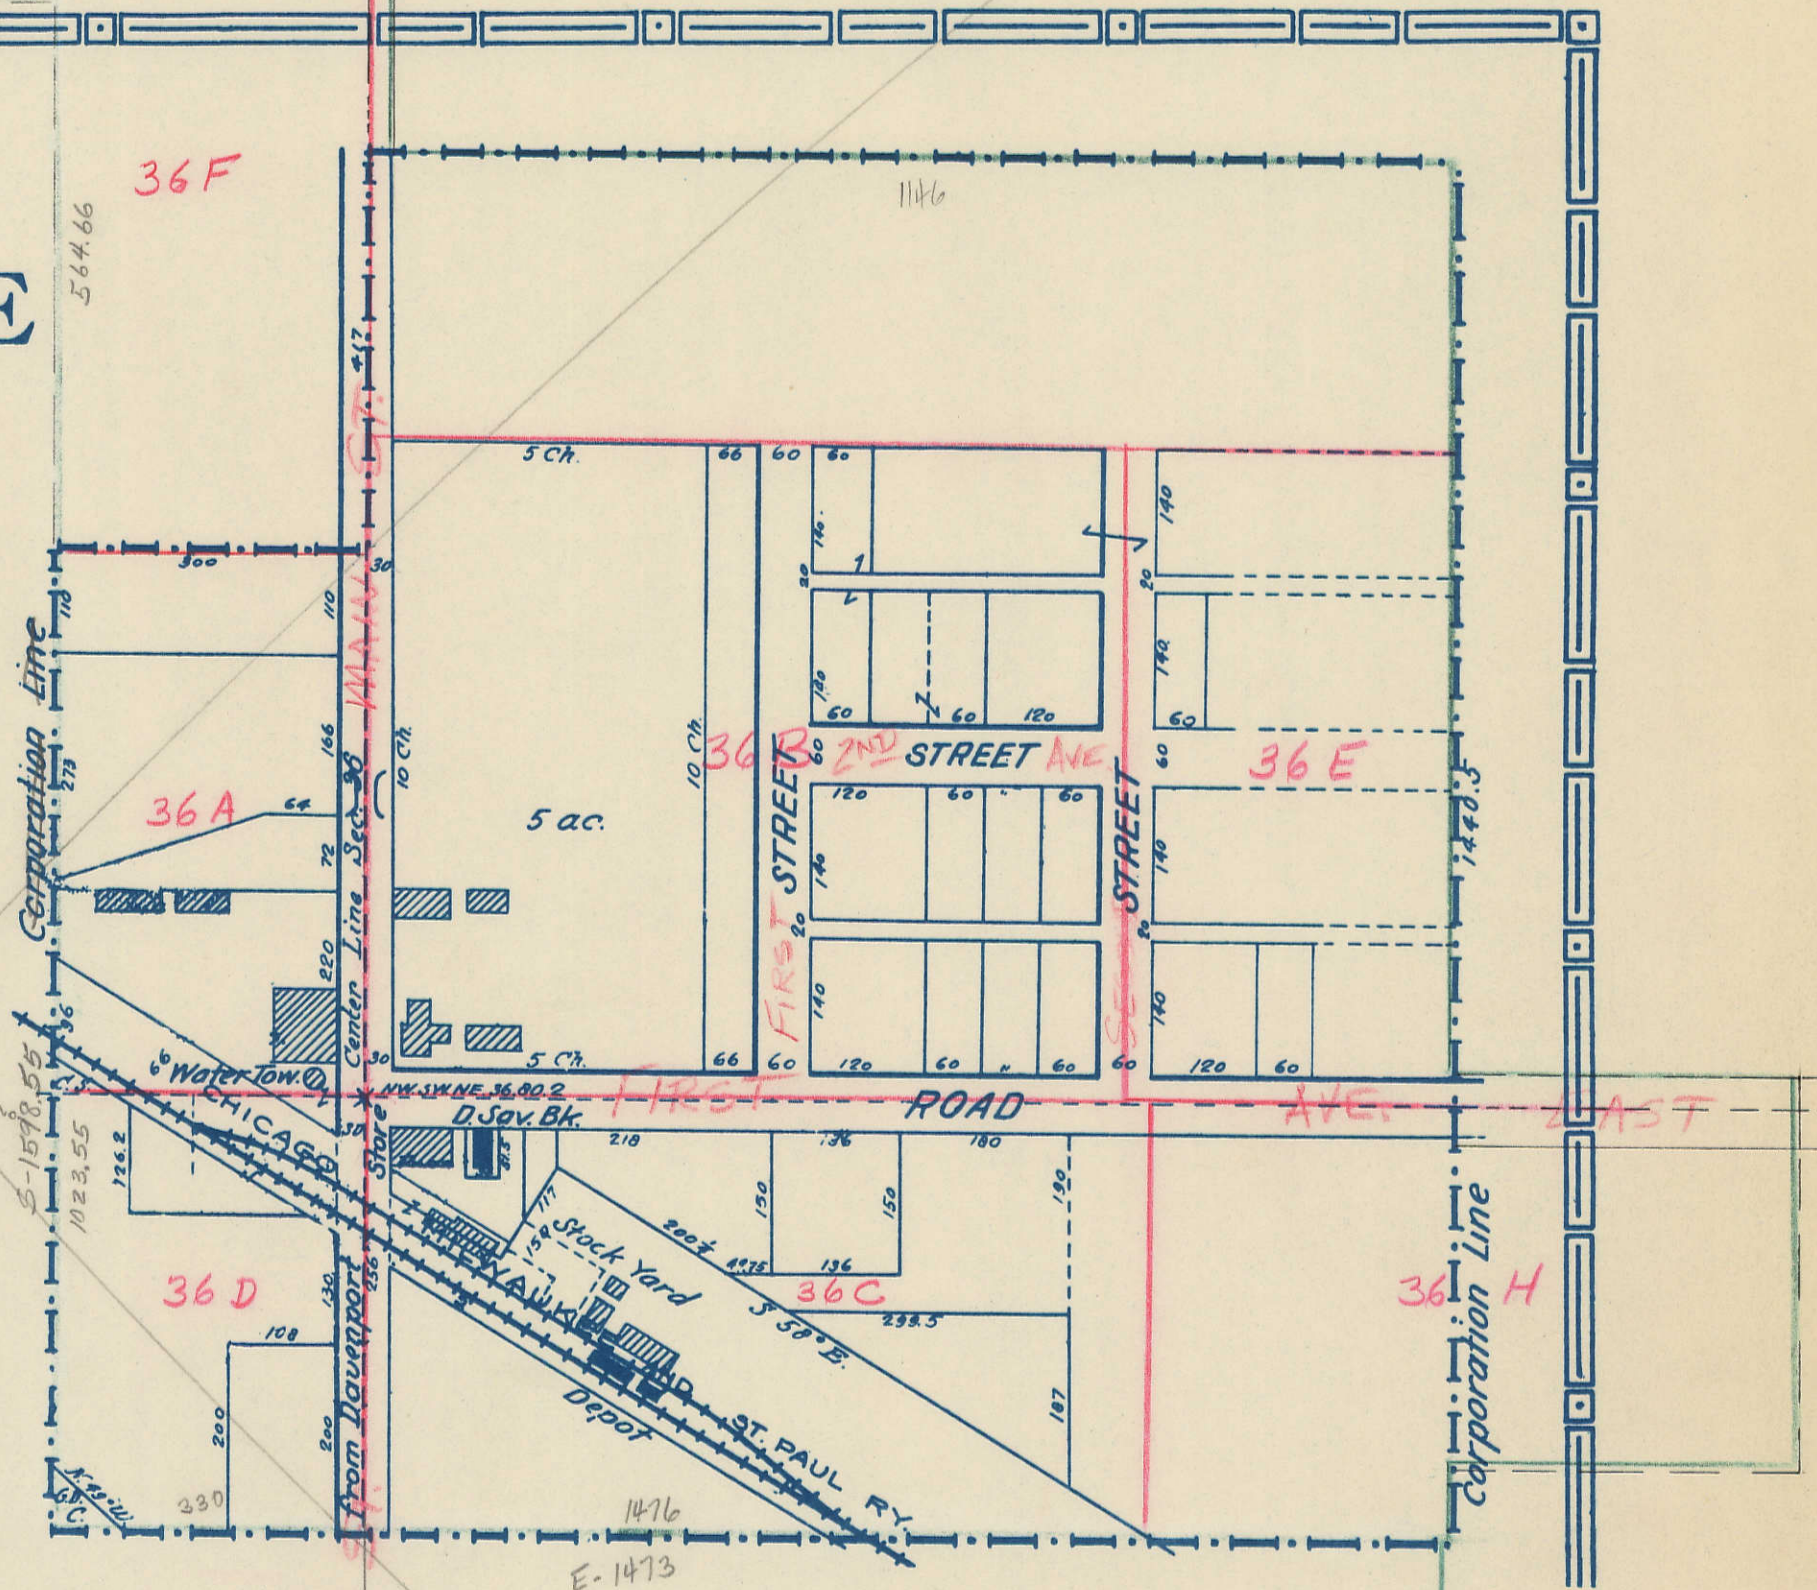

36 F

36 A

36 B

36 E

36 D

36 C

36 H

36 L

36 I

N-1743

S-3564

36