


Transfer Page 7lds: 363

Center SEC 24-78-4
214

see pages 19 and
35 for owner

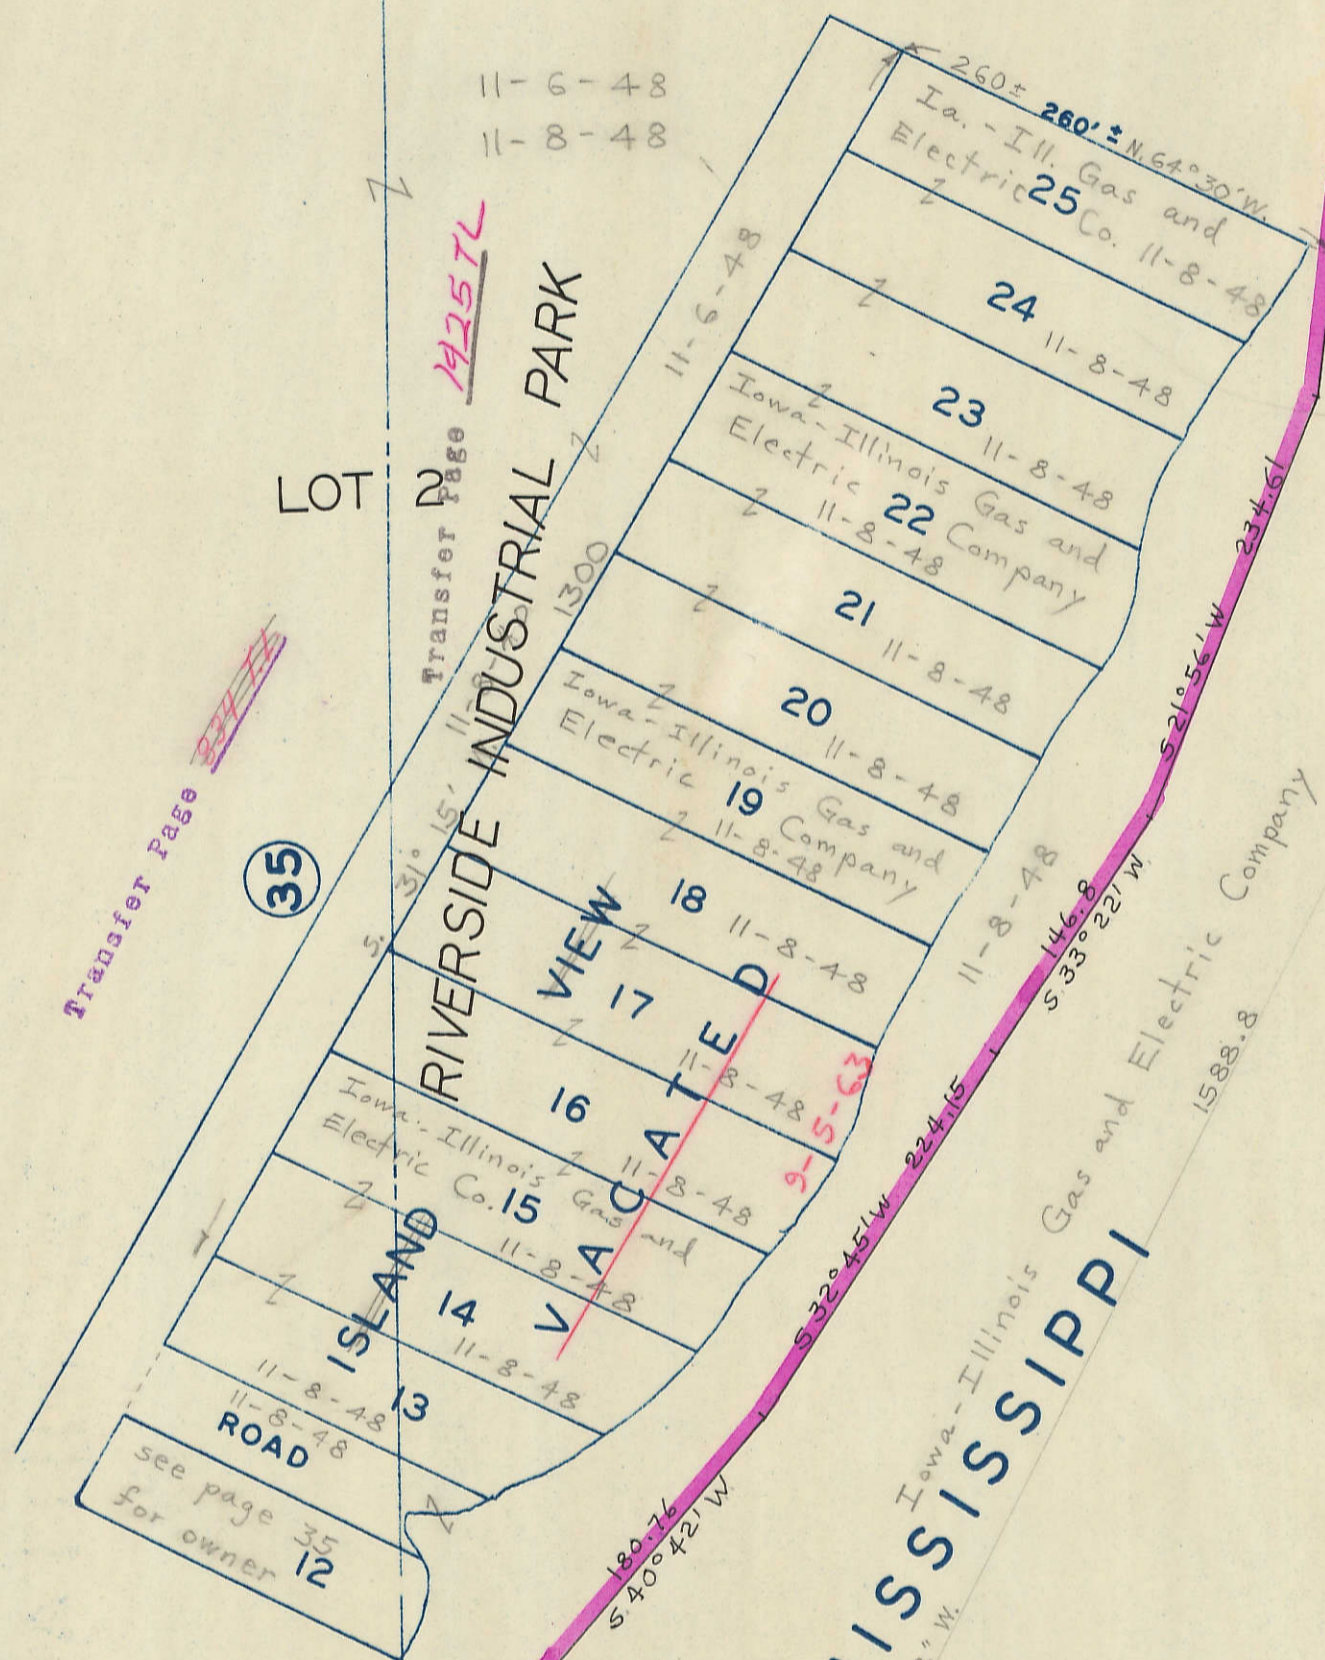

Transfer Page 35

Transfer Page 425 TL

LOT 2

RIVER

21

