


NE. 1/4 NE. 1/4 SE. 1/4 SEC. 22-78-3
SCALE: 1=50

(5)

Transfer Page 623

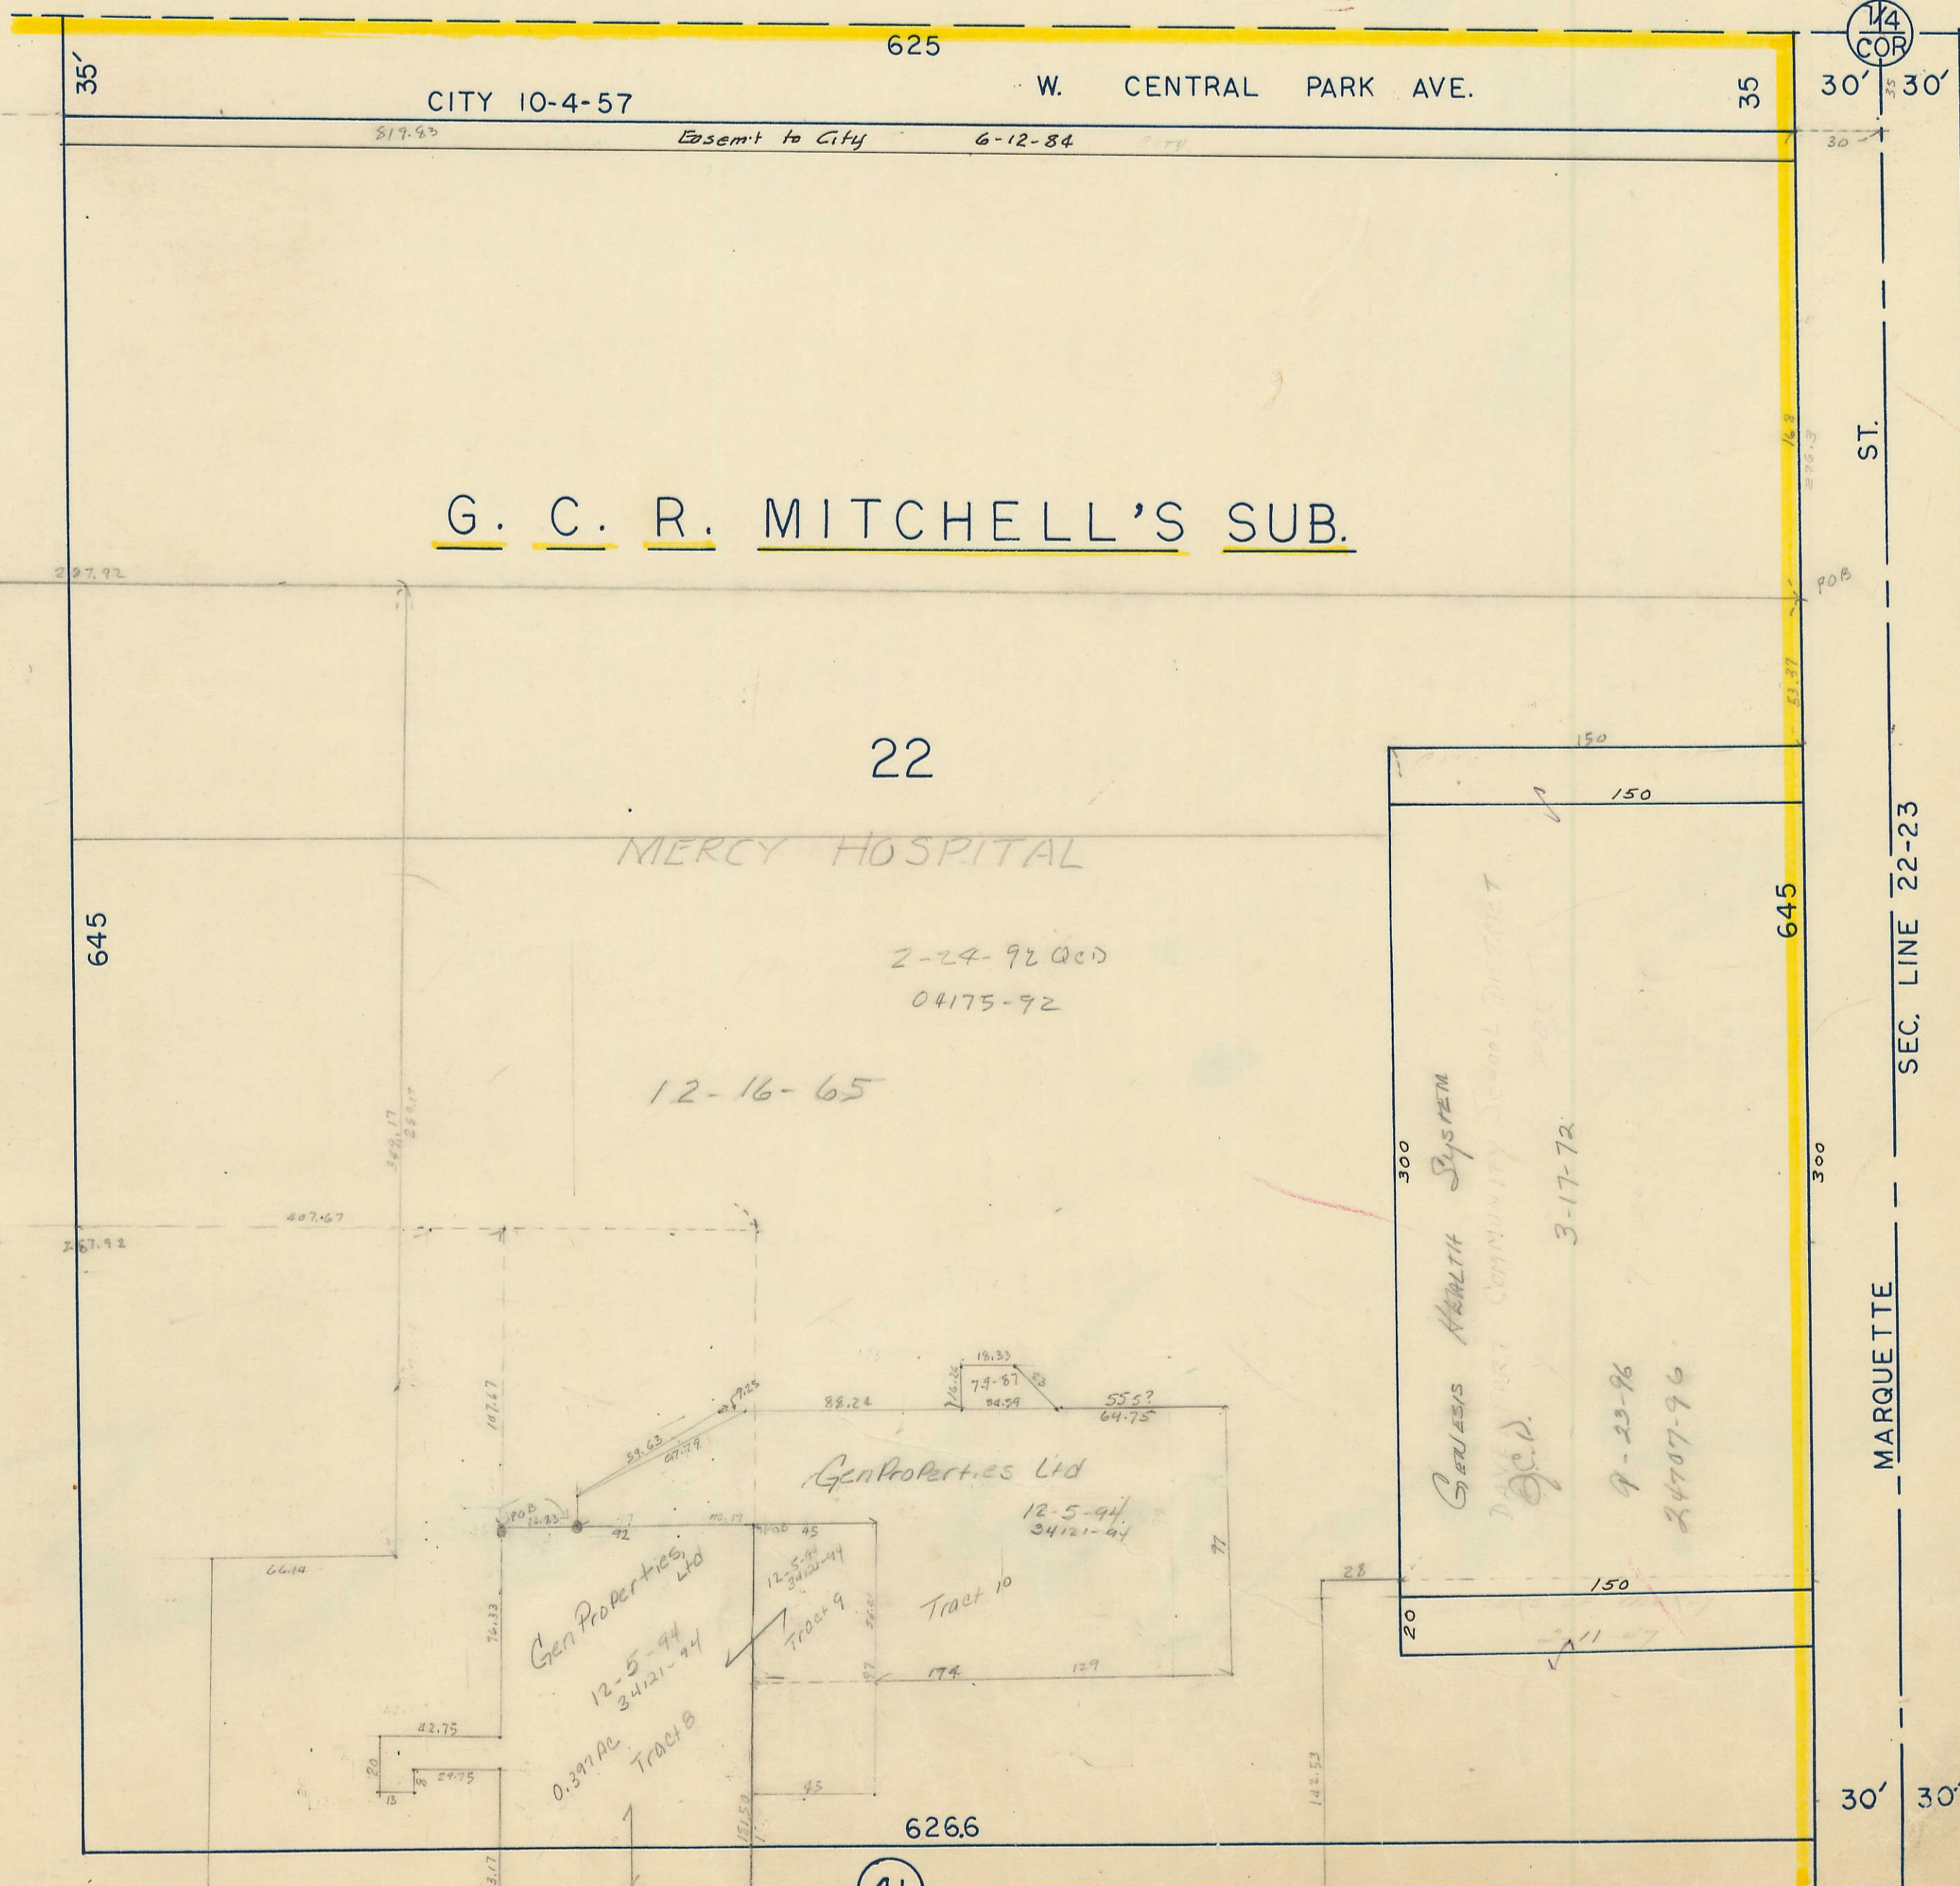

G. C. R. MITCHELL'S SUB.

22

MERCY HOSPITAL

2-24-92 QCD
04175-92

12-16-65

Gen Properties Ltd

12-5-94
34121-94

Gen Properties Ltd
12-5-94
34121-94

0.397AC
TRACT B

TRACT 9

TRACT 10

GENESIS HEALTH SYSTEM
1975 DIST. COMMUNITY SCHOOL DISTRICT
G.C.R.
3-17-72

9-23-96
24707-96

6266

(41)

(39)

(B)
(33)