



Transfer Page 6 lds-195

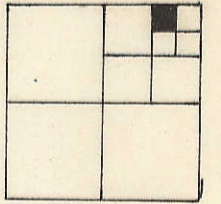


LOCUST STREET

N. line Sec 26-78-3

STREET

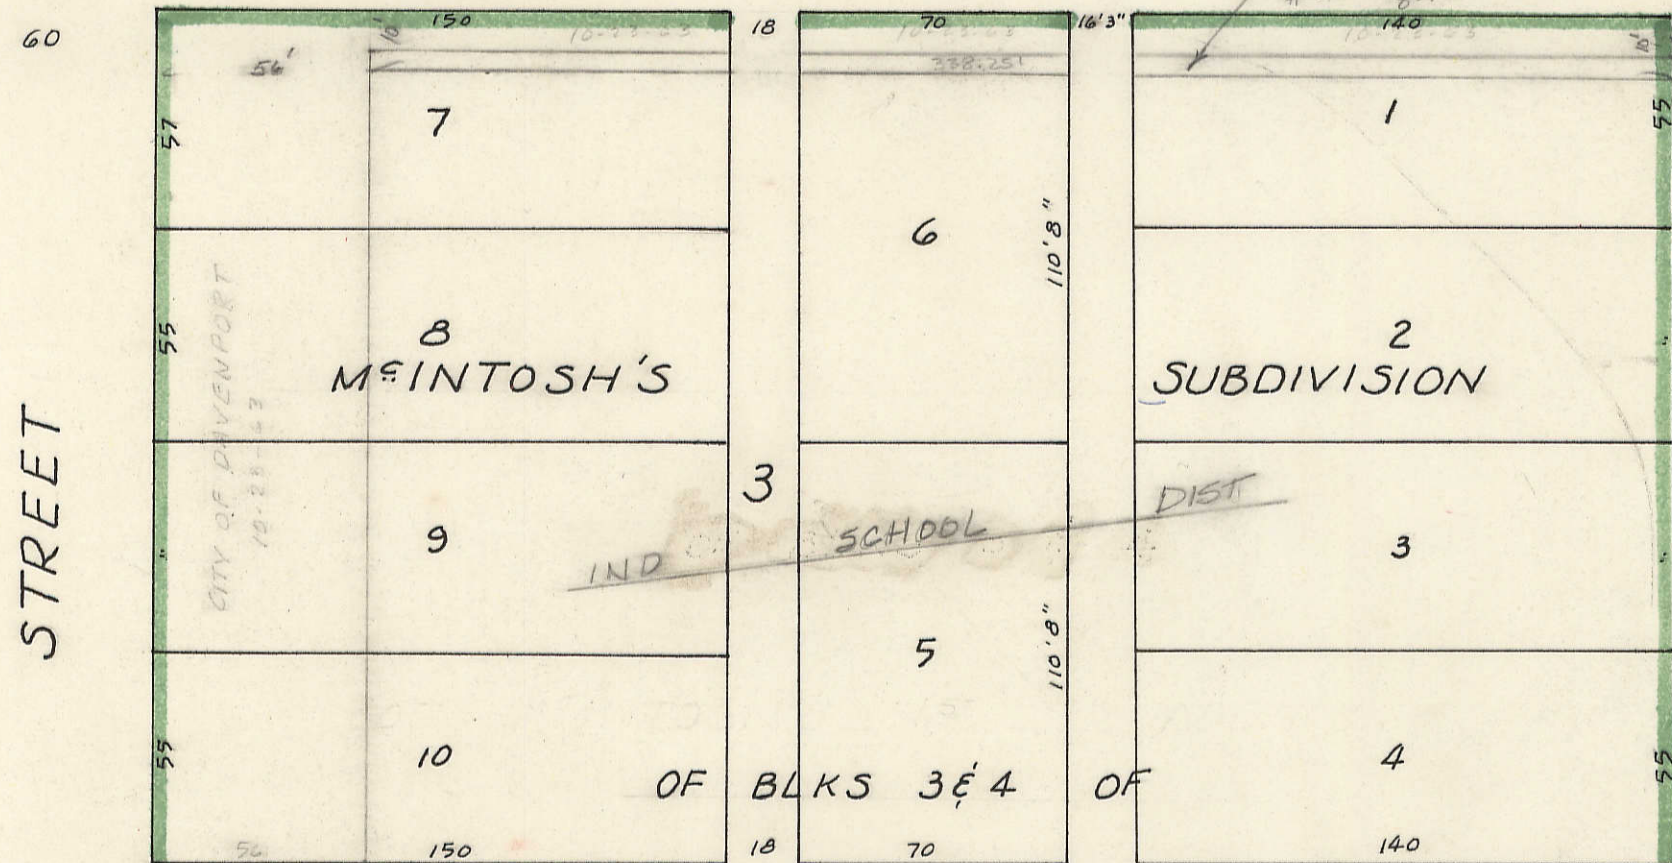

STREET

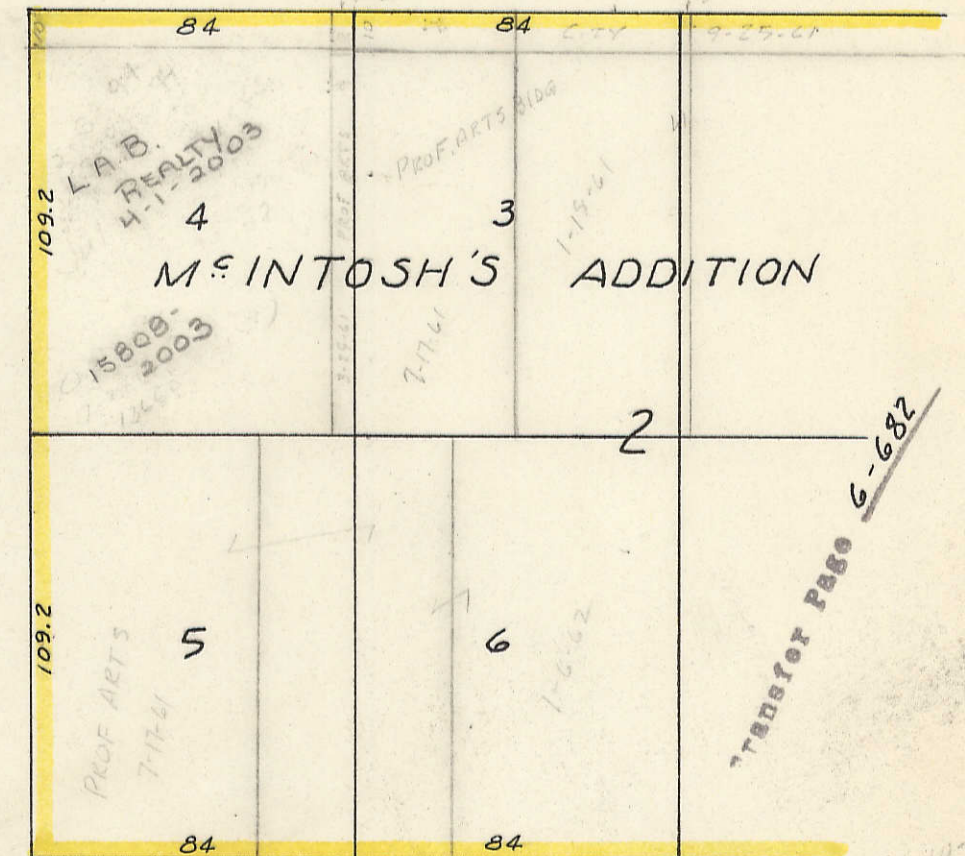

STREET

Transfer Page 6-683

DAV COMMUNITY SCHOOL DIST

18TH


VACATED 9-18-63

10-23-63

(CLAY)

6

HARRISON

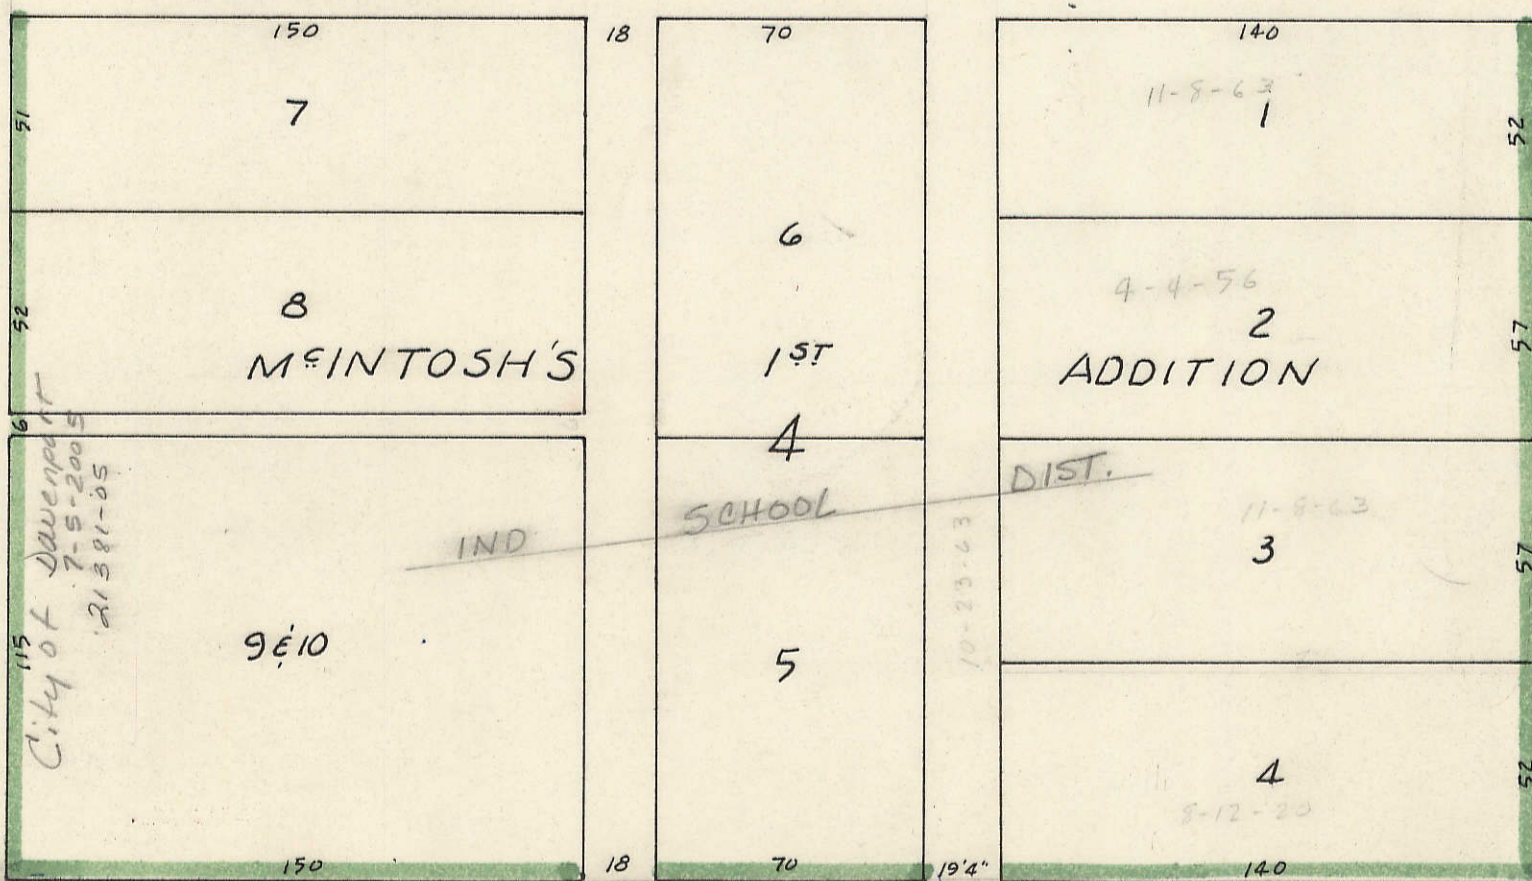


MAIN

17TH

Transfer Page 6-684

VACATED #3075-83

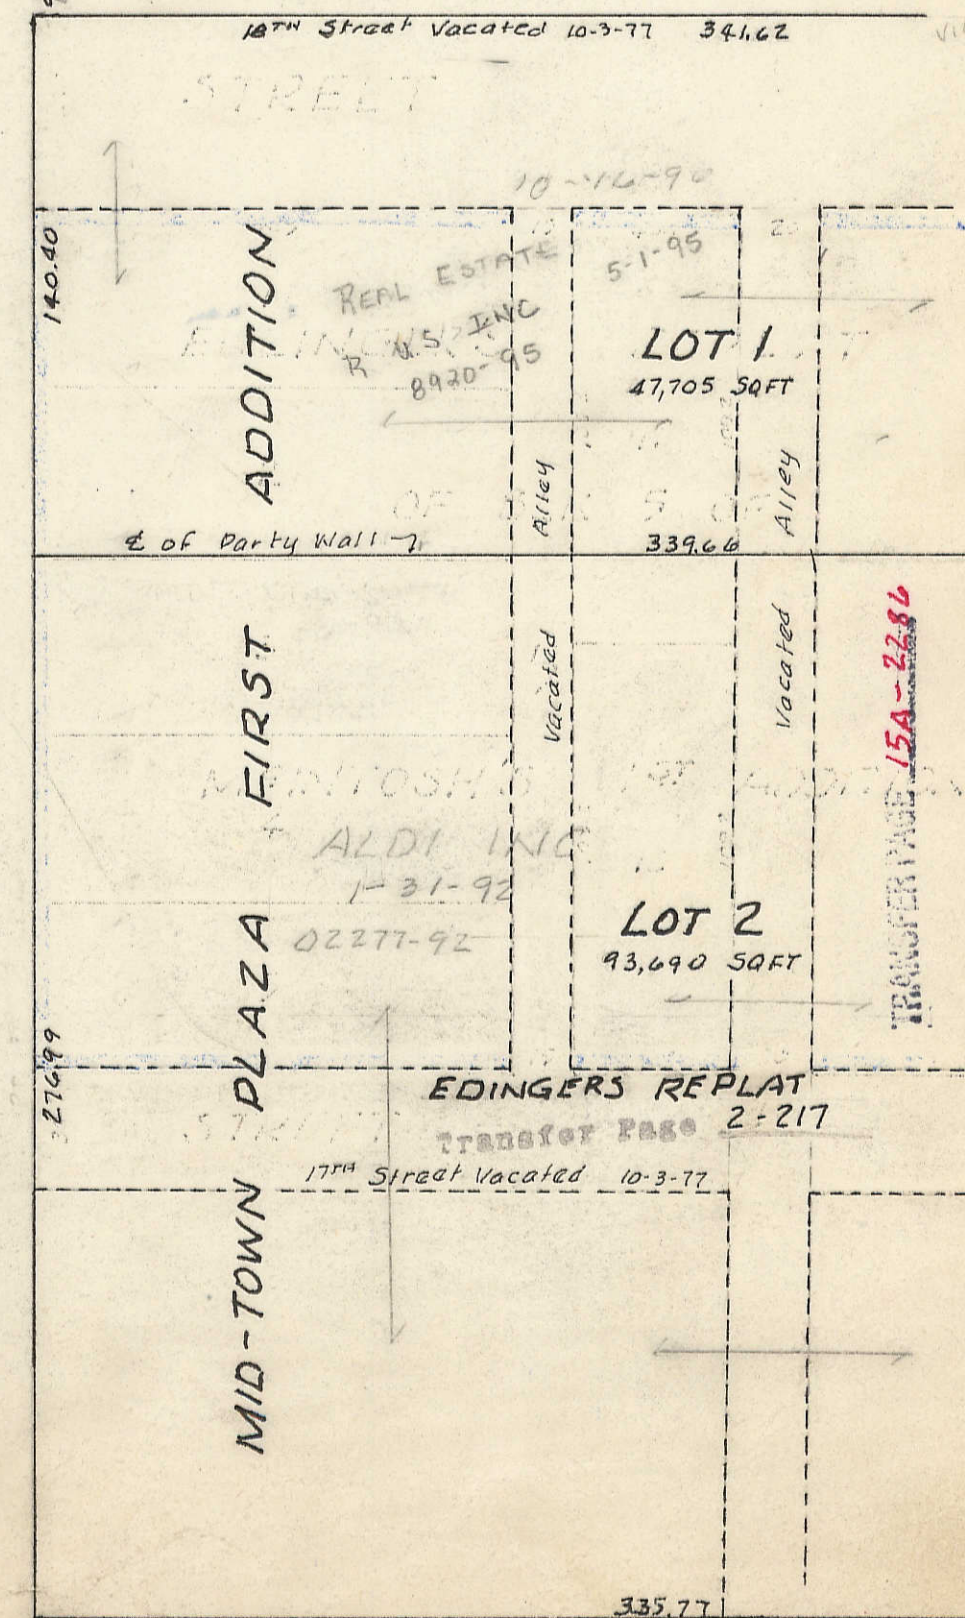

8