


45

Blanks to
Spellicch-Teel
Const. Co.

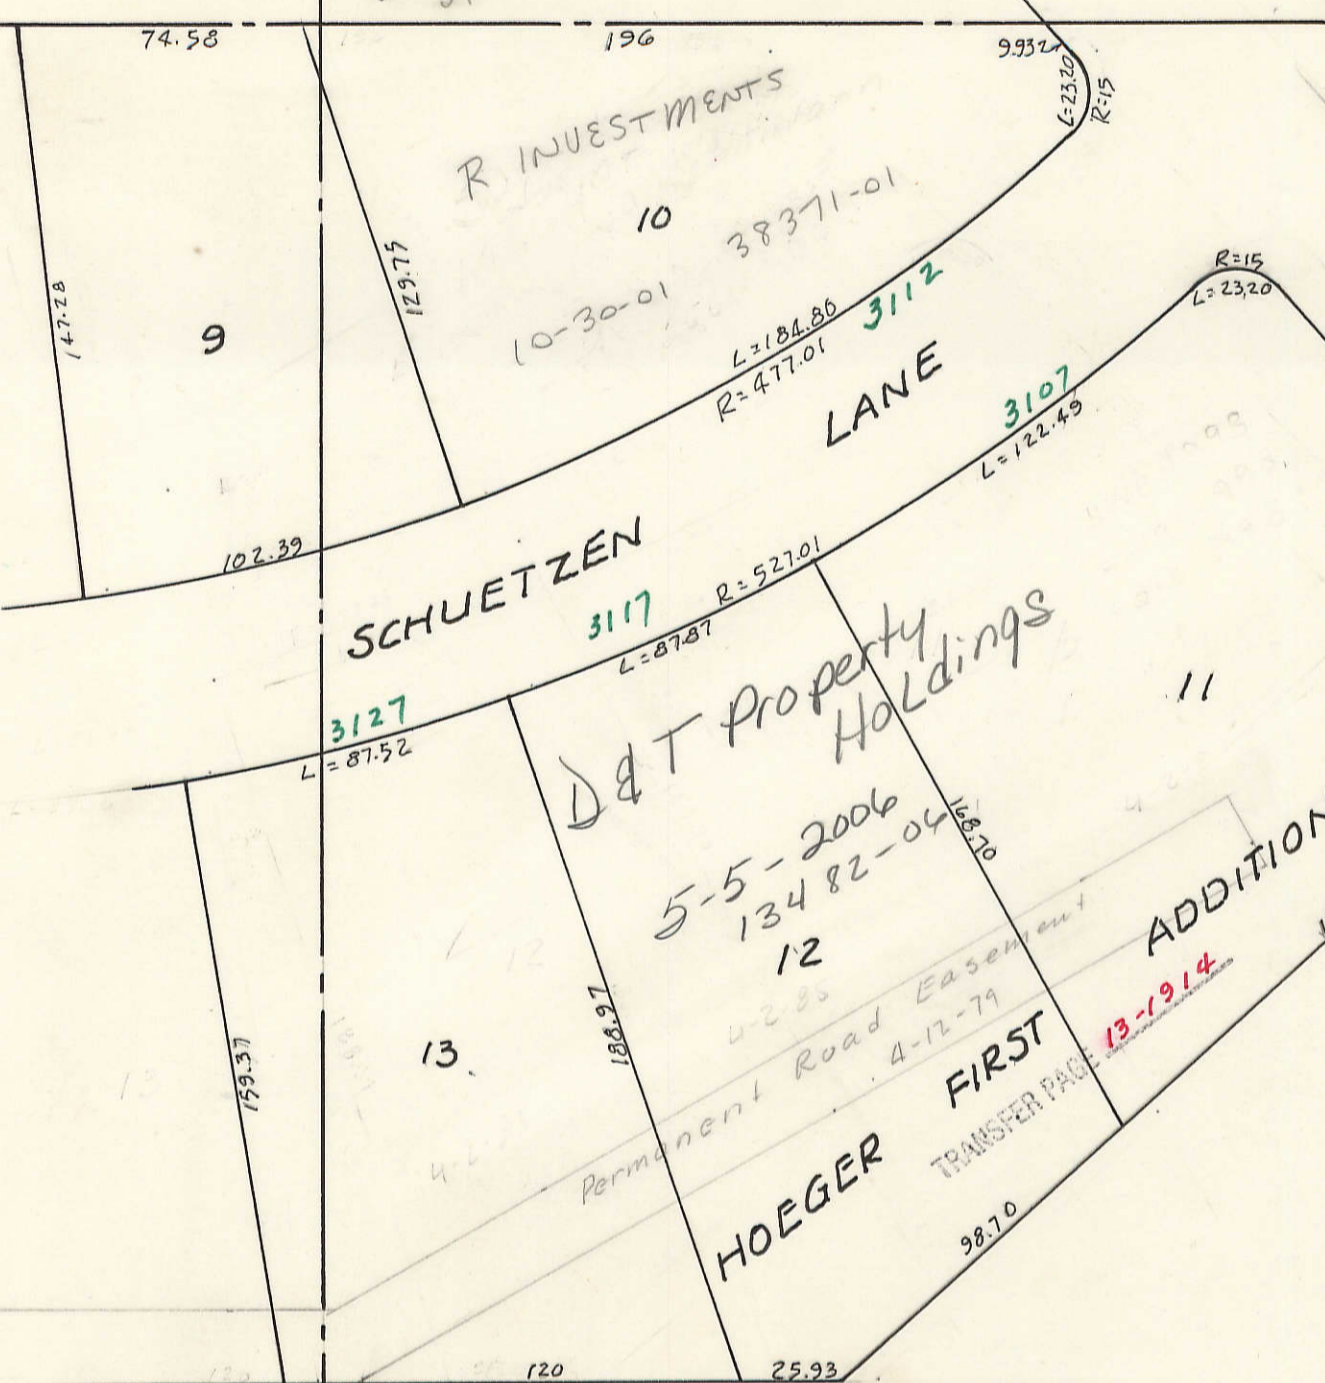

Lois E. Connell

7-28-69

749
(SHARON)

26-A

SCHUETZEN PARK


Evang Lutheran G.S. Soc.

10-19-60

51

53

61

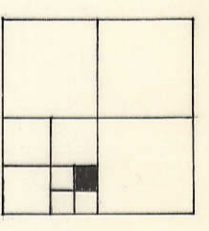

E. line SW 1/4 SEC 28-78-3