

39

TRANSFER PAGE 15A-2634

TRANSFER PAGE 15A-2357



See p. 53

SURVEY # 2001-07142  
3-19-2001


page 30 for owner

LAKE MEADOWS ESTATES 1ST ADD.

WALSH POINTE 1ST ADD.

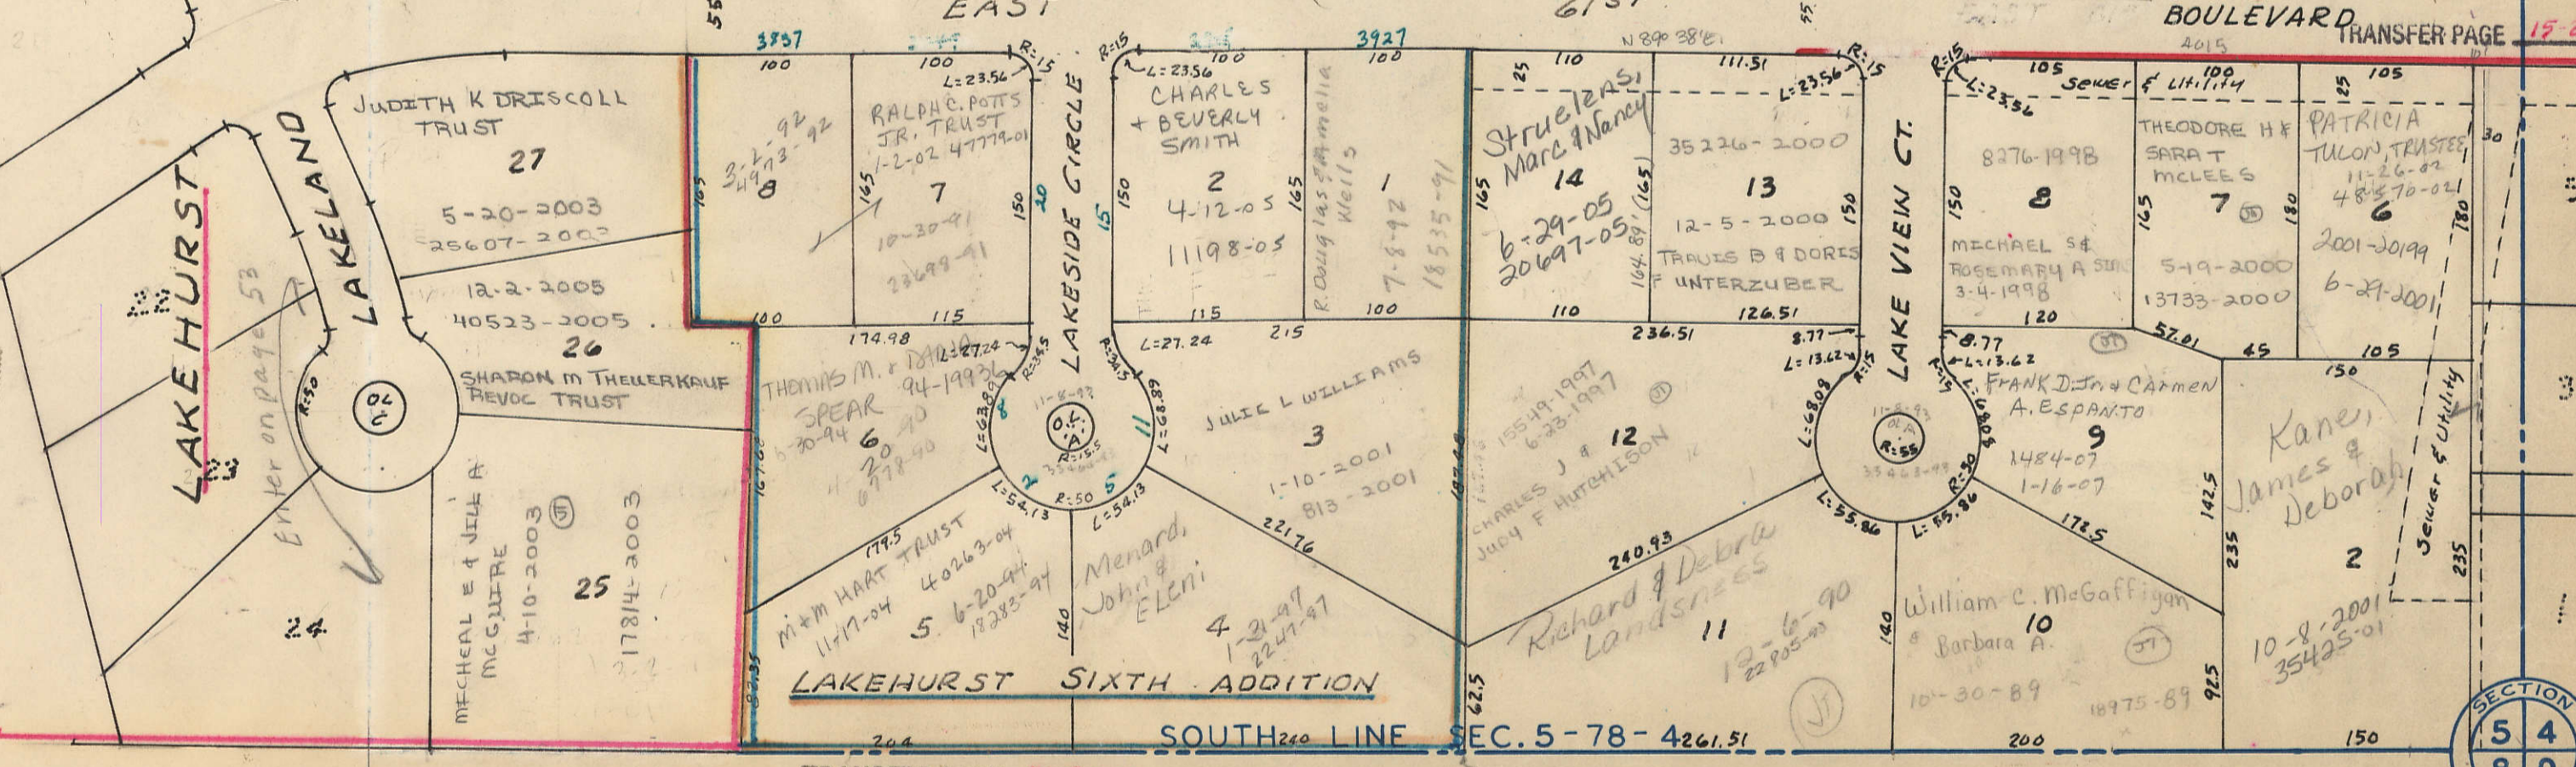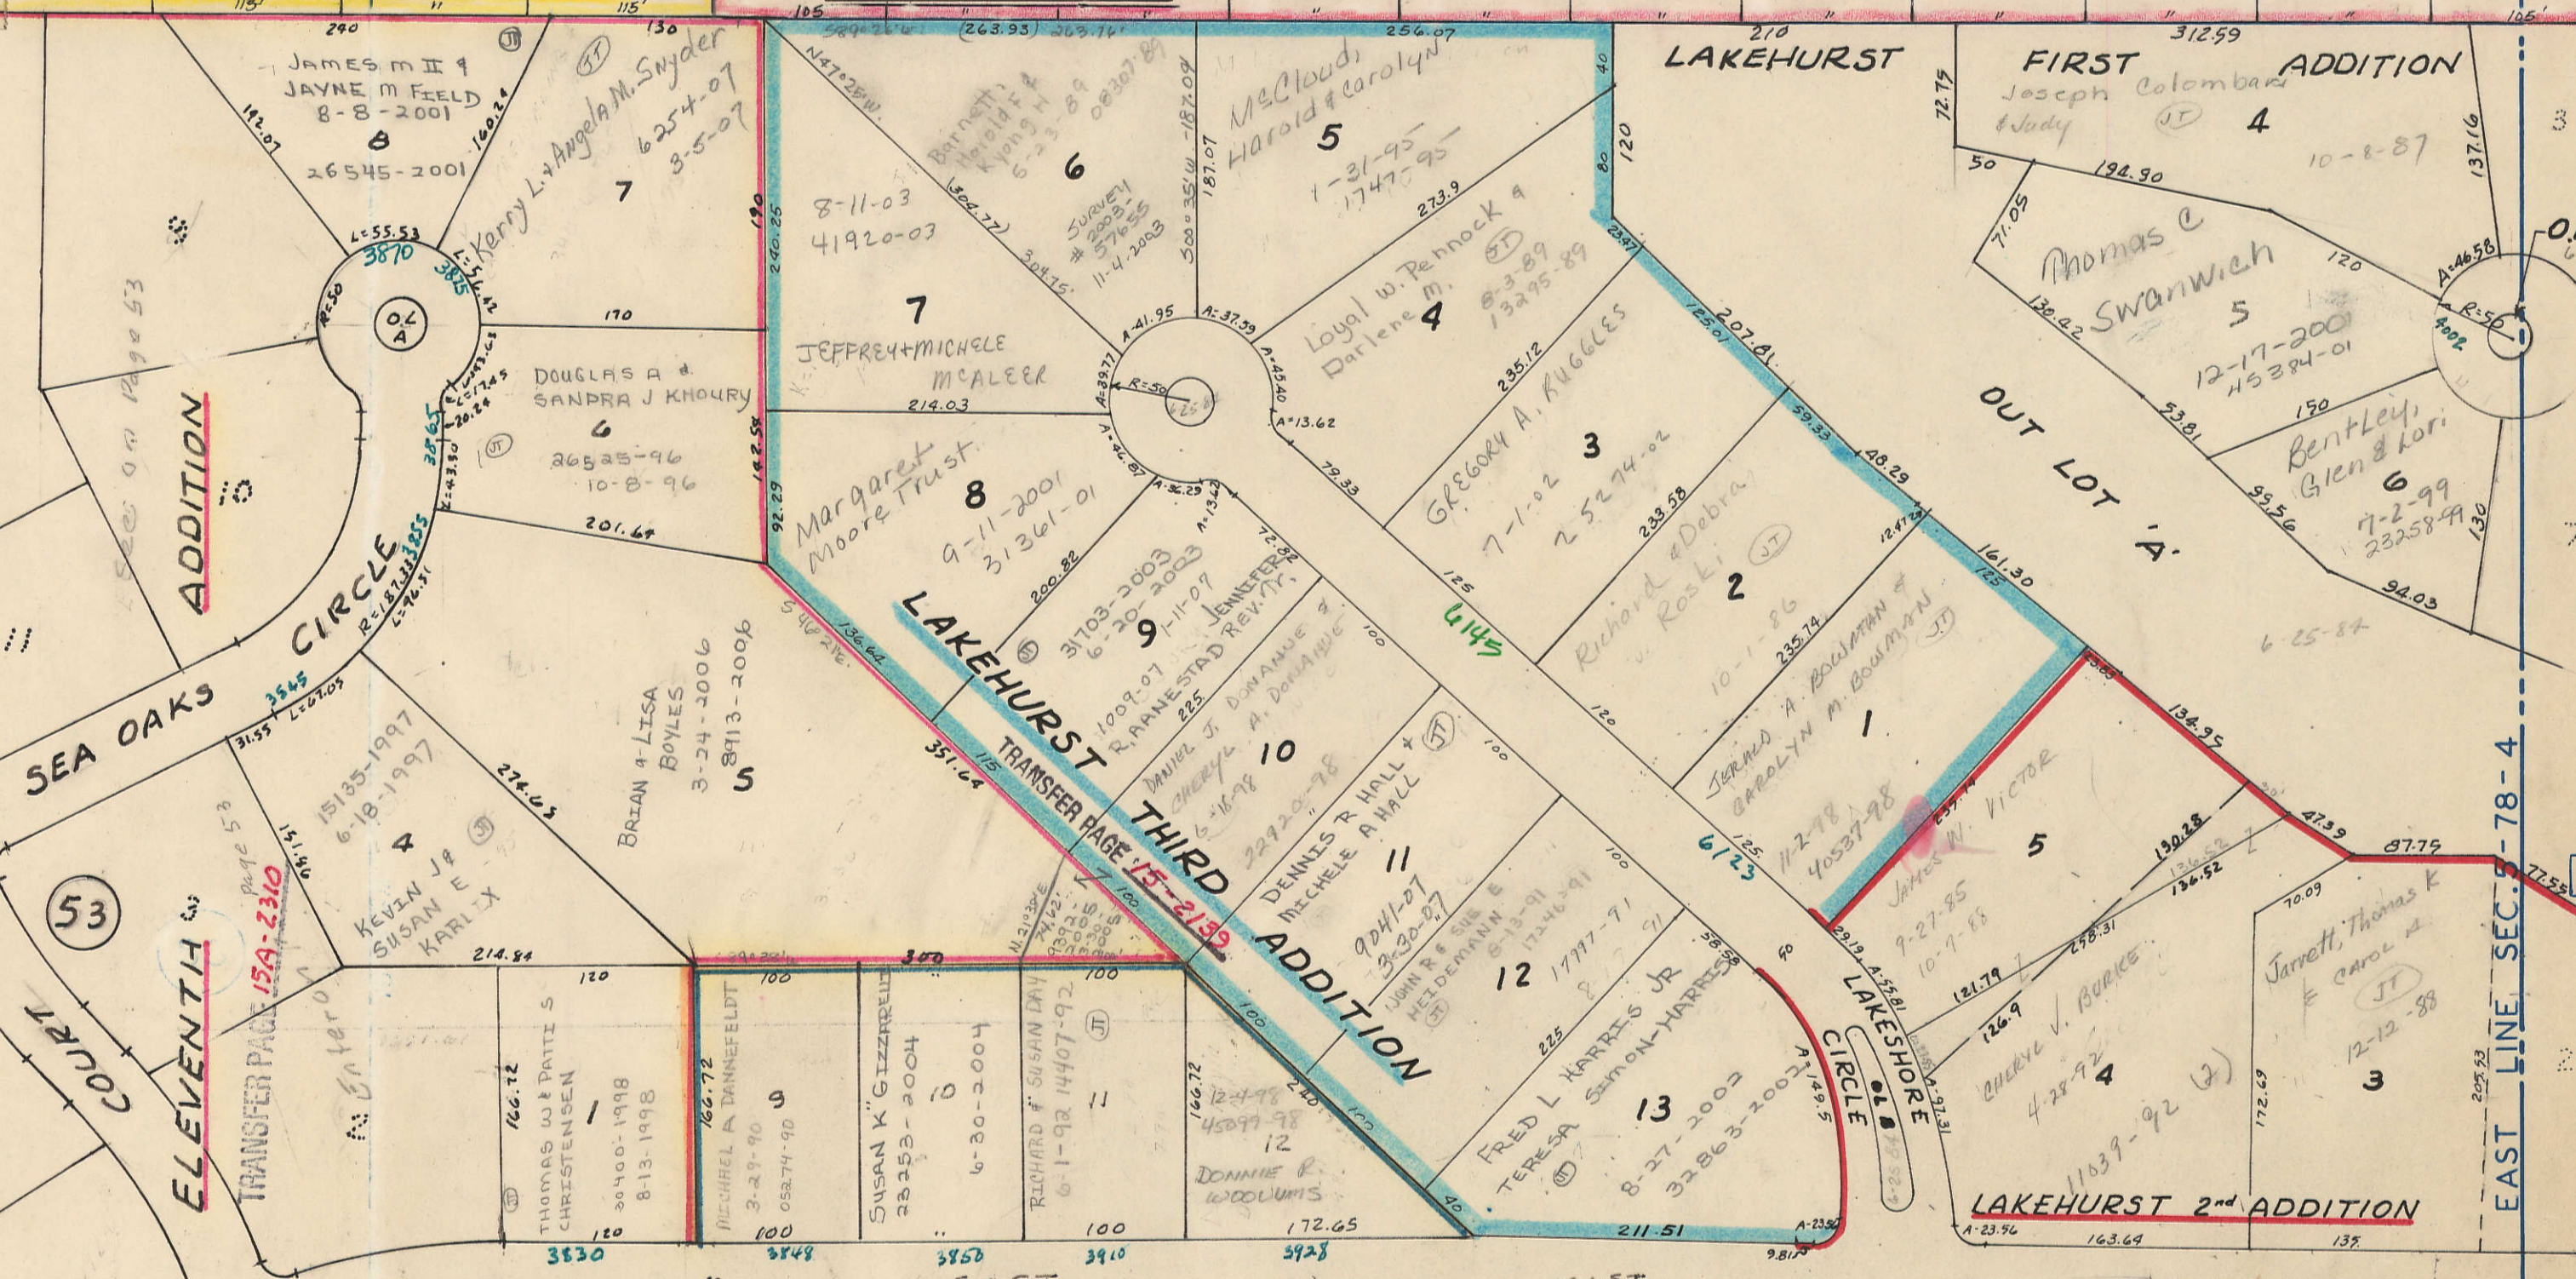

TRANSFER PAGE 15-2201      Y-8      7      LAKEHURST FIFTH ADDITION      TRANSFER PAGE 15-2187

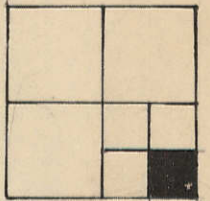

TRANSFER PAGE 15-2127

YI-4

49

