

Lot 3 FENNELLY 1ST ADD (CONDOS)

17A

315A

331A

315B

331B

315C

331C

315D

331D



315E

TN BLUE BRASS - SEC. 32.78-2 17A

TRANSFER PAGE 51ds-63

NOTED: 9-28-06
PROBLEM IN BEARING ON E OF MISSISSIPPI
BETWEEN LEIGHTON'S 1ST ADD. & FENNELLY 1ST ADD.

31-23

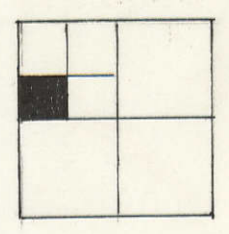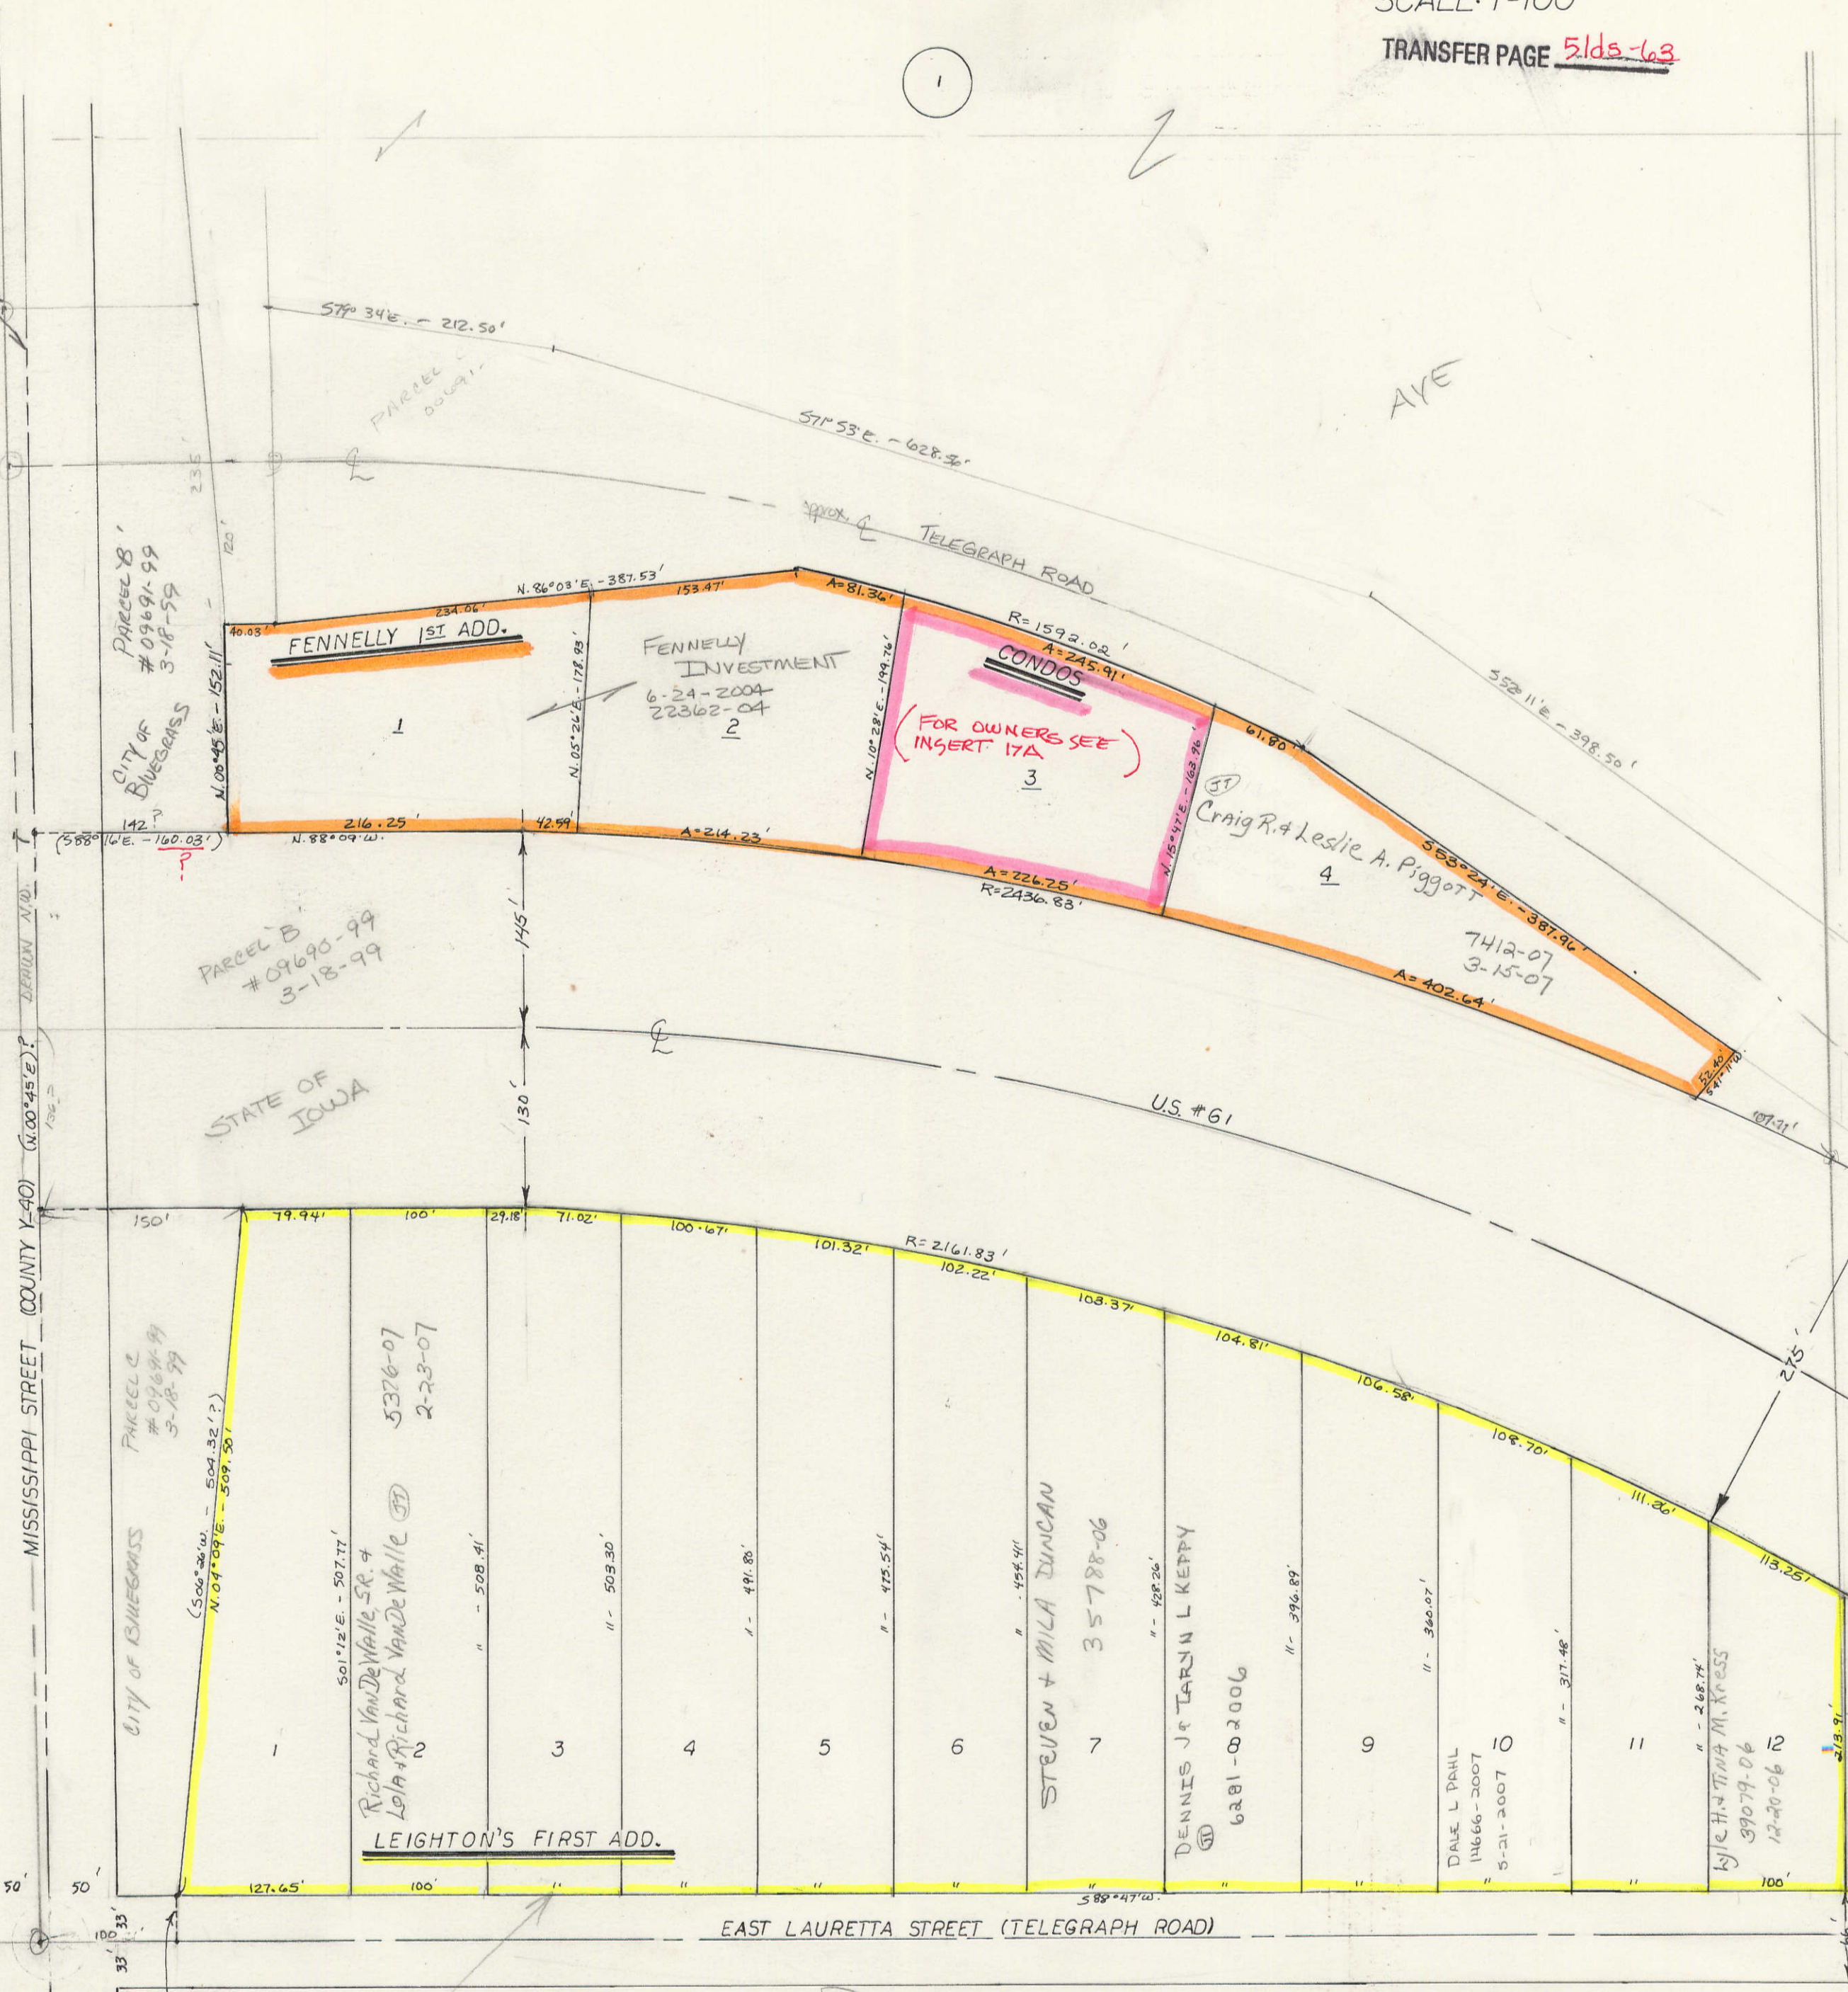

BLANKS TO:
TERRY LEIGHTON
CUSTOM HOMES
(25148-06)
(25149-06)
(25150-06)

33