
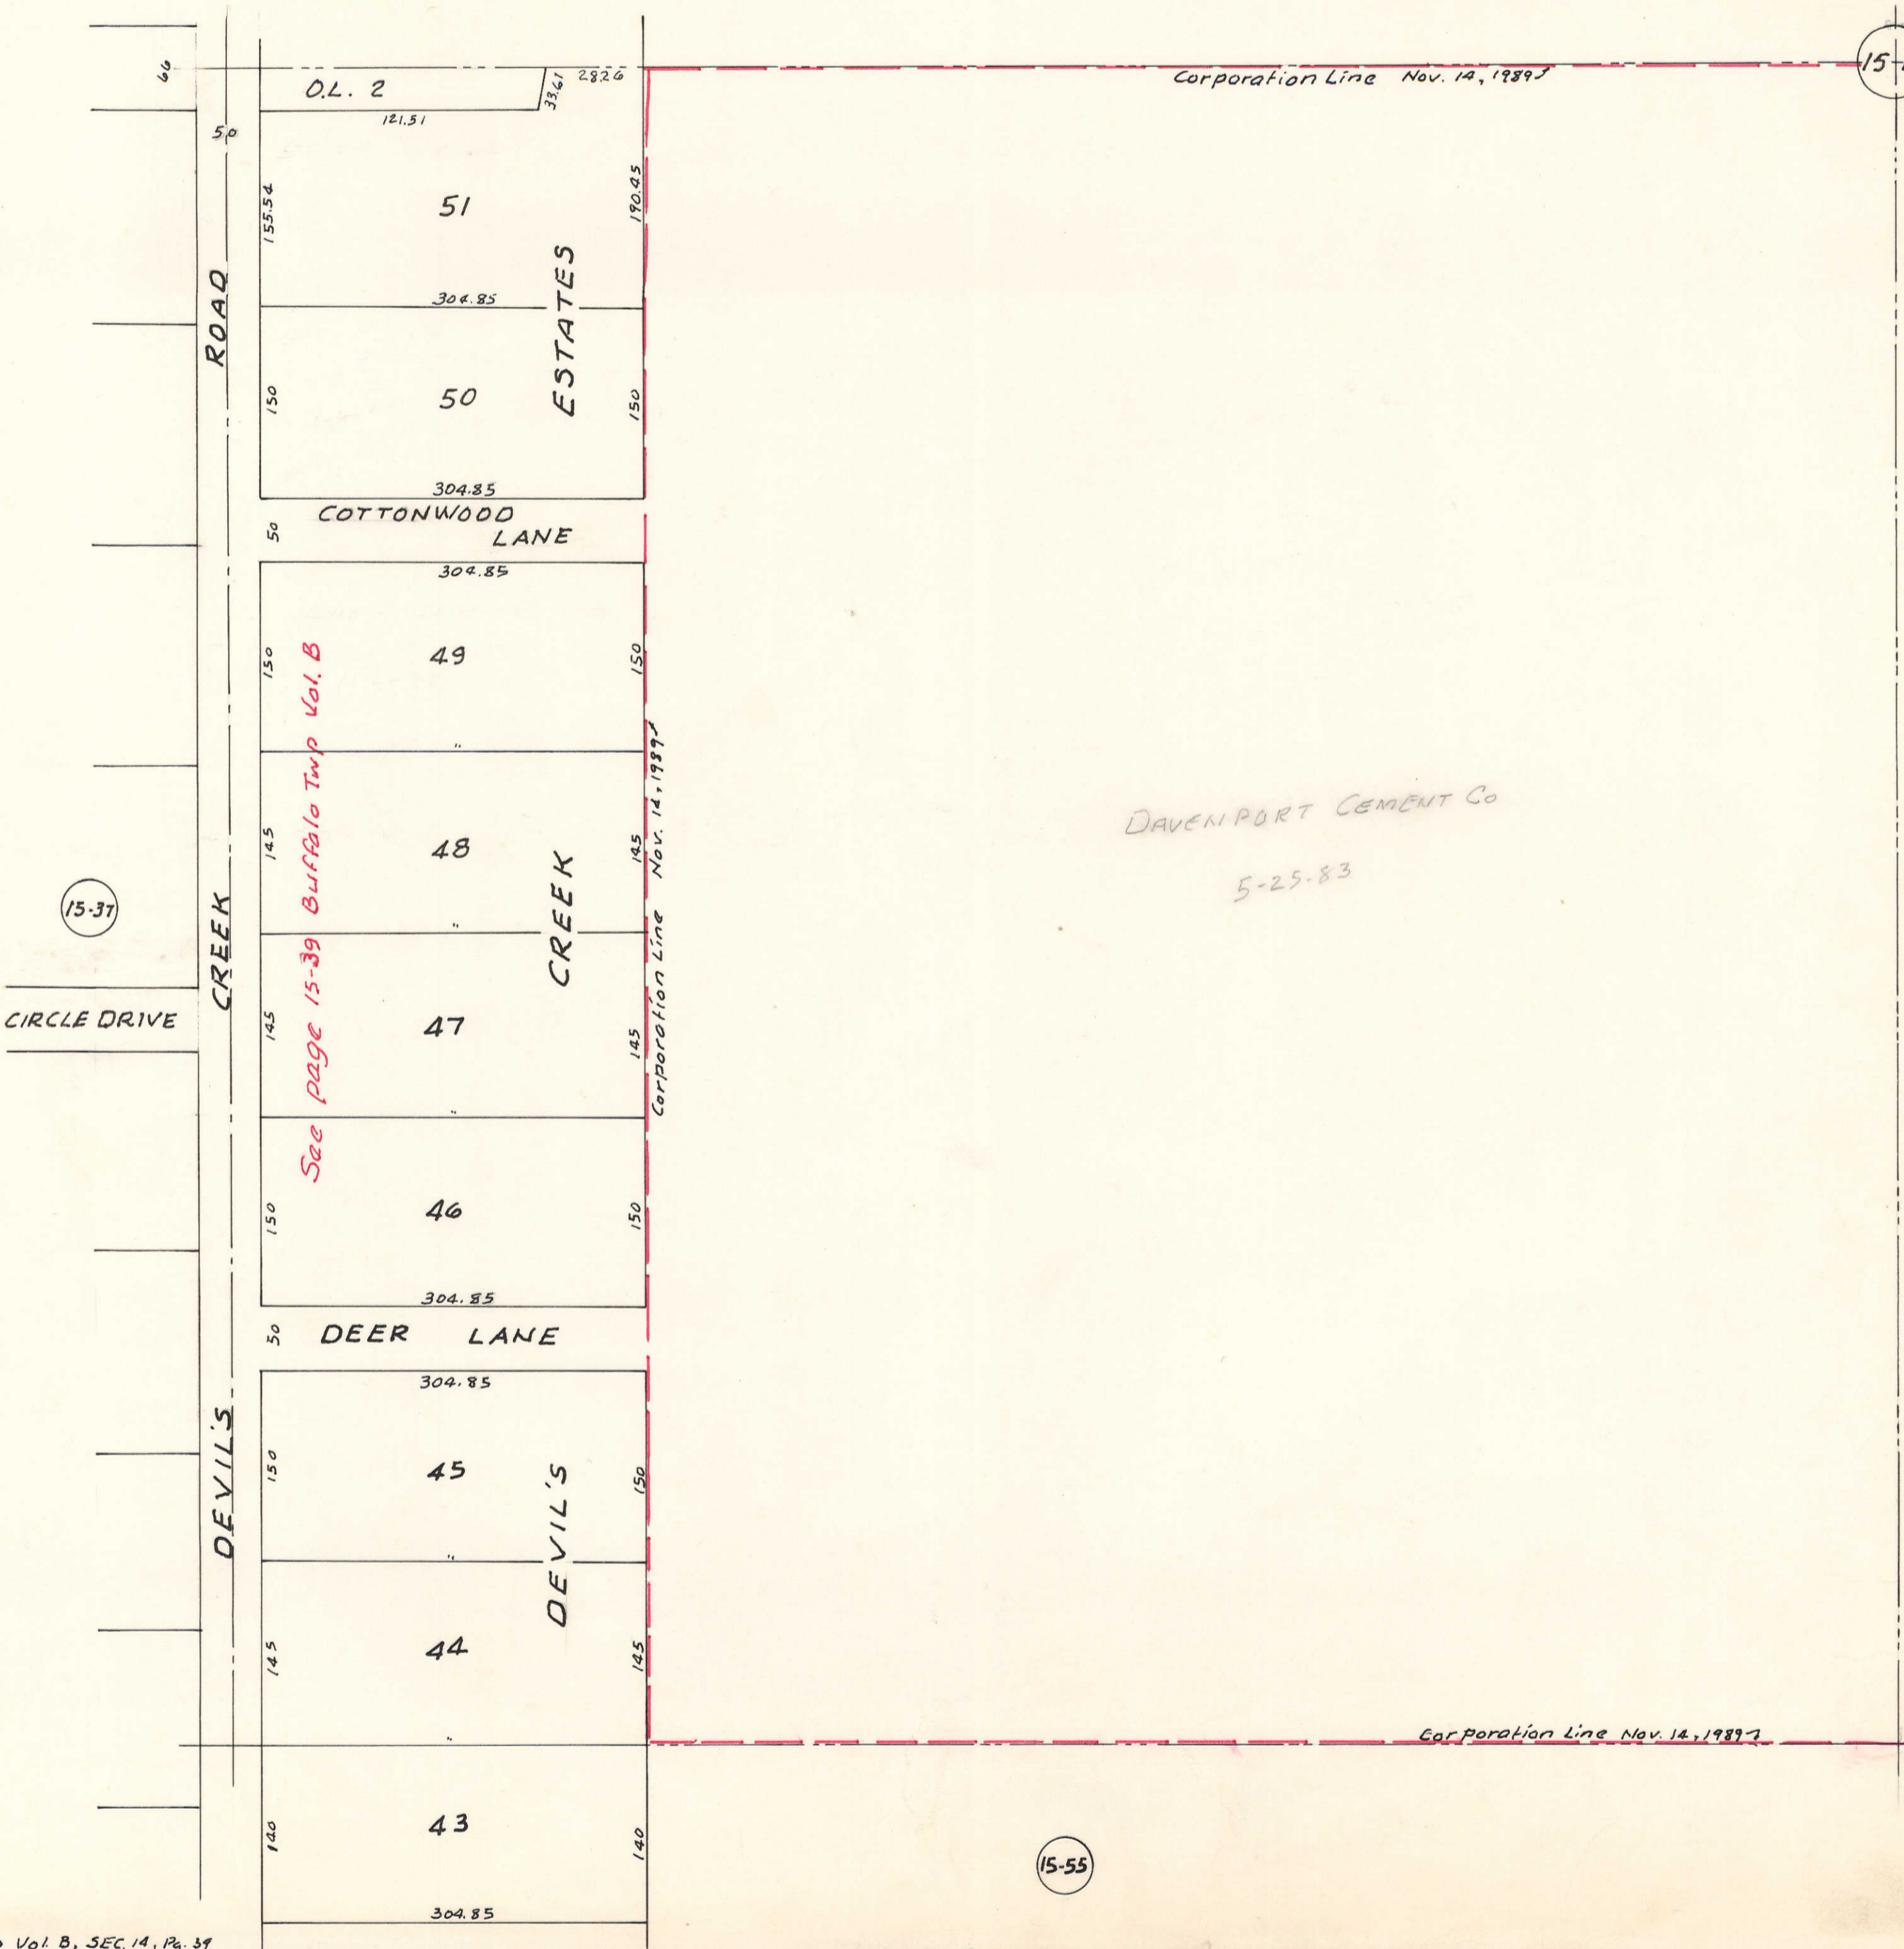


(15-23)

(15-14)

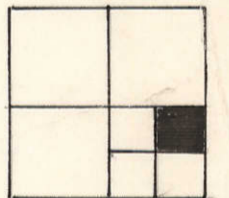

DAVENPORT CEMENT Co
5-25-83

SEC 14

(33)