


BUTLER TWP

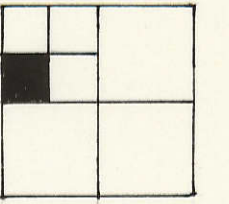


SEE  
BUTLER TWP.

SEC. 12-80-4  
(SW<sup>1</sup>/<sub>4</sub>, NW<sup>1</sup>/<sub>4</sub>)

BUTLER TWP

BUTLER TWP

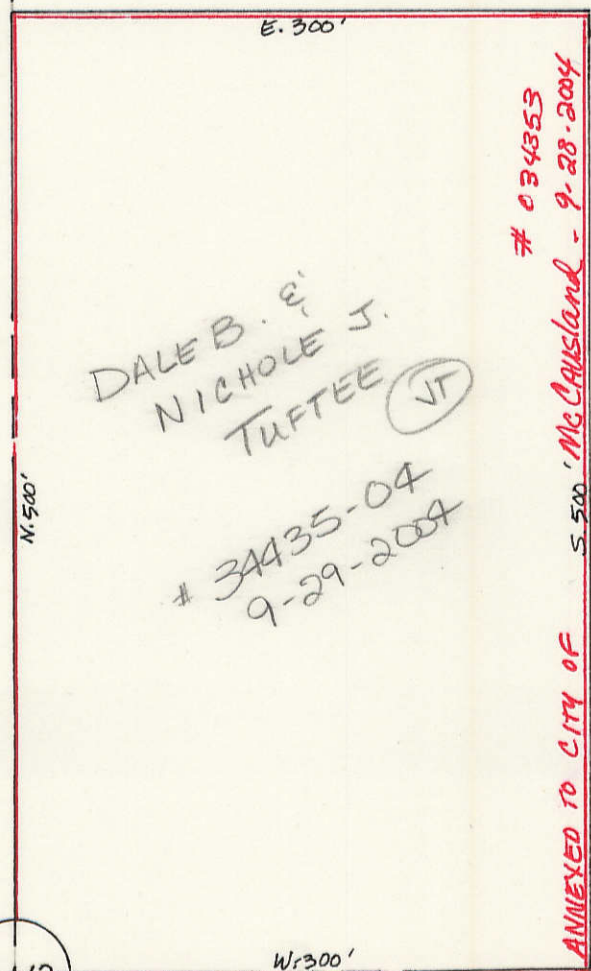

11+12

33