

UNITED STATES PUBLIC LAND SURVEY CORNER CERTIFICATE OF



Land Survey Monuments situated in Section 2, Township 78N, Range 5E, of the Fifth Principal Meridian, SCOTT County, Iowa.
Previously recorded in Book _____, Page _____.

(Show reason for preparing this certificate, the evidence and detailed procedures used in establishing the corner positions and monumentation found or placed.)

Monument Description and Remarks: SECTION CORNER LOCATED FOR SURVEY AND FINAL PLAT OF COTTONWOOD ESTATES

PLAN - VIEW

(Show a minimum of three reference ties to durable physical objects, relevant monuments and physical conditions that will enable recovery of the corner.)

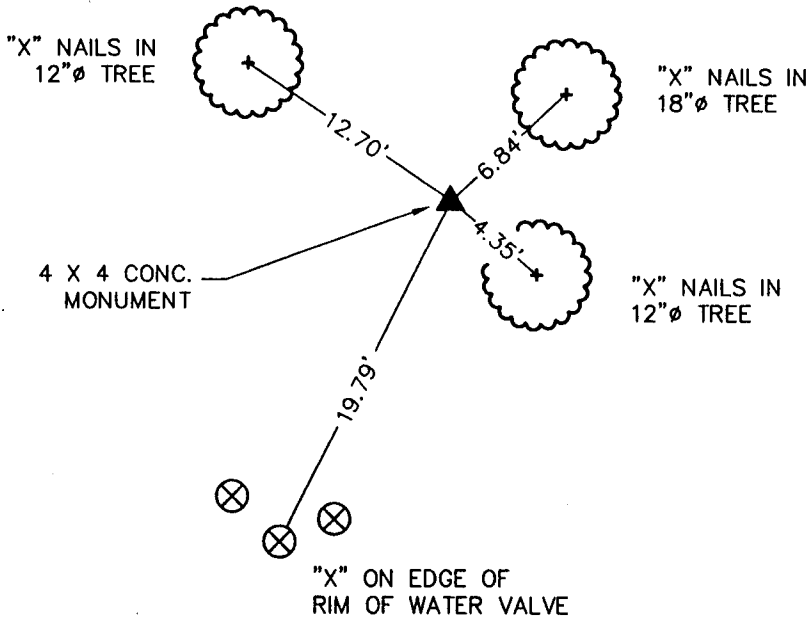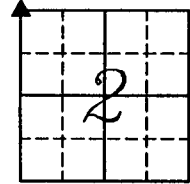

NOT TO SCALE

*Northwest Corner
Section 4*

SHOULD BE
SEC. 2

PREPARED BY:



I hereby certify that the survey work was completed and this certificate was prepared by me or under my direct personal supervision and that I am a duly registered land surveyor under the laws of the state of Iowa.

Marvin E. Hinkle Jan 5, 1998

MARVIN E. HINKLE Date
Registered Land Surveyor No. 4204
My registration expires Dec. 31, 1997.

List Corners to be Indexed

Corners	Section	Twp	Range
NW COR	SEC. 4 SEC. 2	78N	5E

