



UNITED STATES PUBLIC LAND SURVEY CORNER CERTIFICATE OF

Land Survey Monuments situated in Section 2 Township 79 NORTH Range 2 EAST of the Fifth Principal Meridian SCOTT County, Iowa.

Previously recorded in N/A in County Recorder's Office.

Monument Description and Remarks: FOUND STANDARD CONCRETE MONUMENT ±12" DEEP AT THE WEST 1/4 CORNER OF SECTION 2

PLAN - VIEW

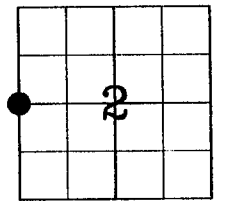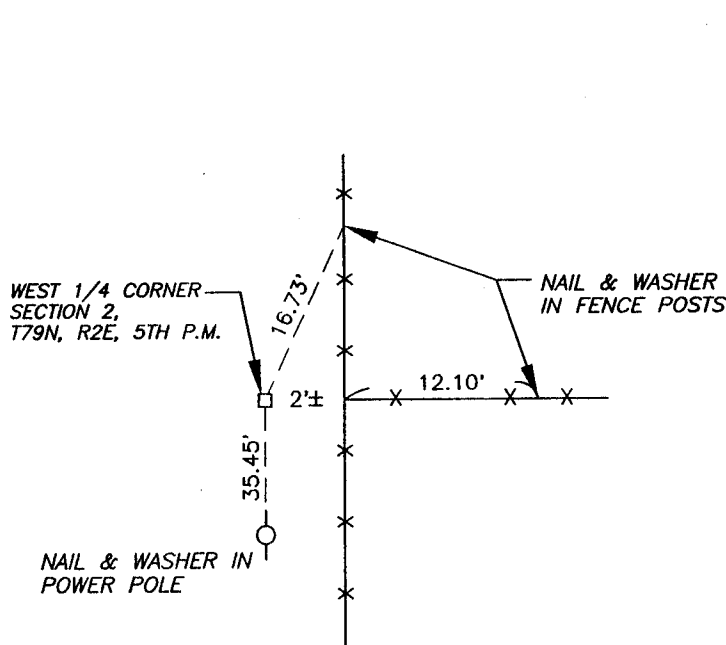

I hereby certify that the survey work was completed and this certificate was prepared by me or under direct personal supervision and that I am a duly registered land surveyor under the laws of the state of Iowa.

Signature: Jimmy D. Rose
 Jimmy D. Rose R.L.S. No. 11309
 Date: January 21, 1999 Reg. No. LS #11309
 License renewal December 31, 1999

List Corners to be Indexed			
Corners	Section	Twp	Range
W 1/4	2	79N	2E

SEAL

