

UNITED STATES PUBLIC LAND SURVEY CORNER CERTIFICATE

OF

Land Survey Monuments situated in Section 23, Township T-79N, Range R-2E, of the Fifth Principal Meridian, SCOTT County, Iowa. Previously recorded in \_\_\_\_\_ in County Recorder's Office.

(book, page, document number, etc.)

(Show reason for preparing this certificate, the evidence and detailed procedures used in establishing the corner positions and monumentation found or placed.)


Monument Description and Remarks: SCOTT COUNTY TIE BOOKS

PLAN - VIEW

(Show a minimum of three reference ties to durable physical objects, relevant monuments and physical conditions that will enable recovery of the corner.)



Mon. Exposed. Ken Klindt (Farmer) wanted Monument lowered. Dug up Monument and tried to place Iron Pin with Survey Cap. Hit Old Stone. Placed 2 magnetic Survey Caps and a Rail Road spike over Stone for locating only. Stone 30" Deep. 11-10-04

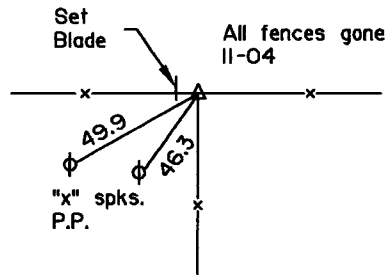

Fd. "x" spks. Placed Survey Sign above "x" spks. 11-04

Found 3-69



- △ Conc. Mon.
- Iron Pin
- Set Iron Pin

List Corners to be Indexed

Corners	Section	Twp	Range
SE. Cor.	23	79N	2E