

UNITED STATES PUBLIC LAND SURVEY CORNER CERTIFICATE

OF

Land Survey Monuments situated in Section 7, Township 79 North, Range 3 East, of the Fifth Principal Meridian, Scott County, Iowa.
 Previously recorded in does not apply in County Recorder's Office.


(book, page, document number, etc.)

(Show reason for preparing this certificate, the evidence and detailed procedures used in establishing the corner positions and monumentation found or placed.)

Monument Description and Remarks: See Detail Below

PLAN - VIEW

(Show a minimum of three reference ties to durable physical objects, relevant monuments and physical conditions that will enable recovery of the corner.)

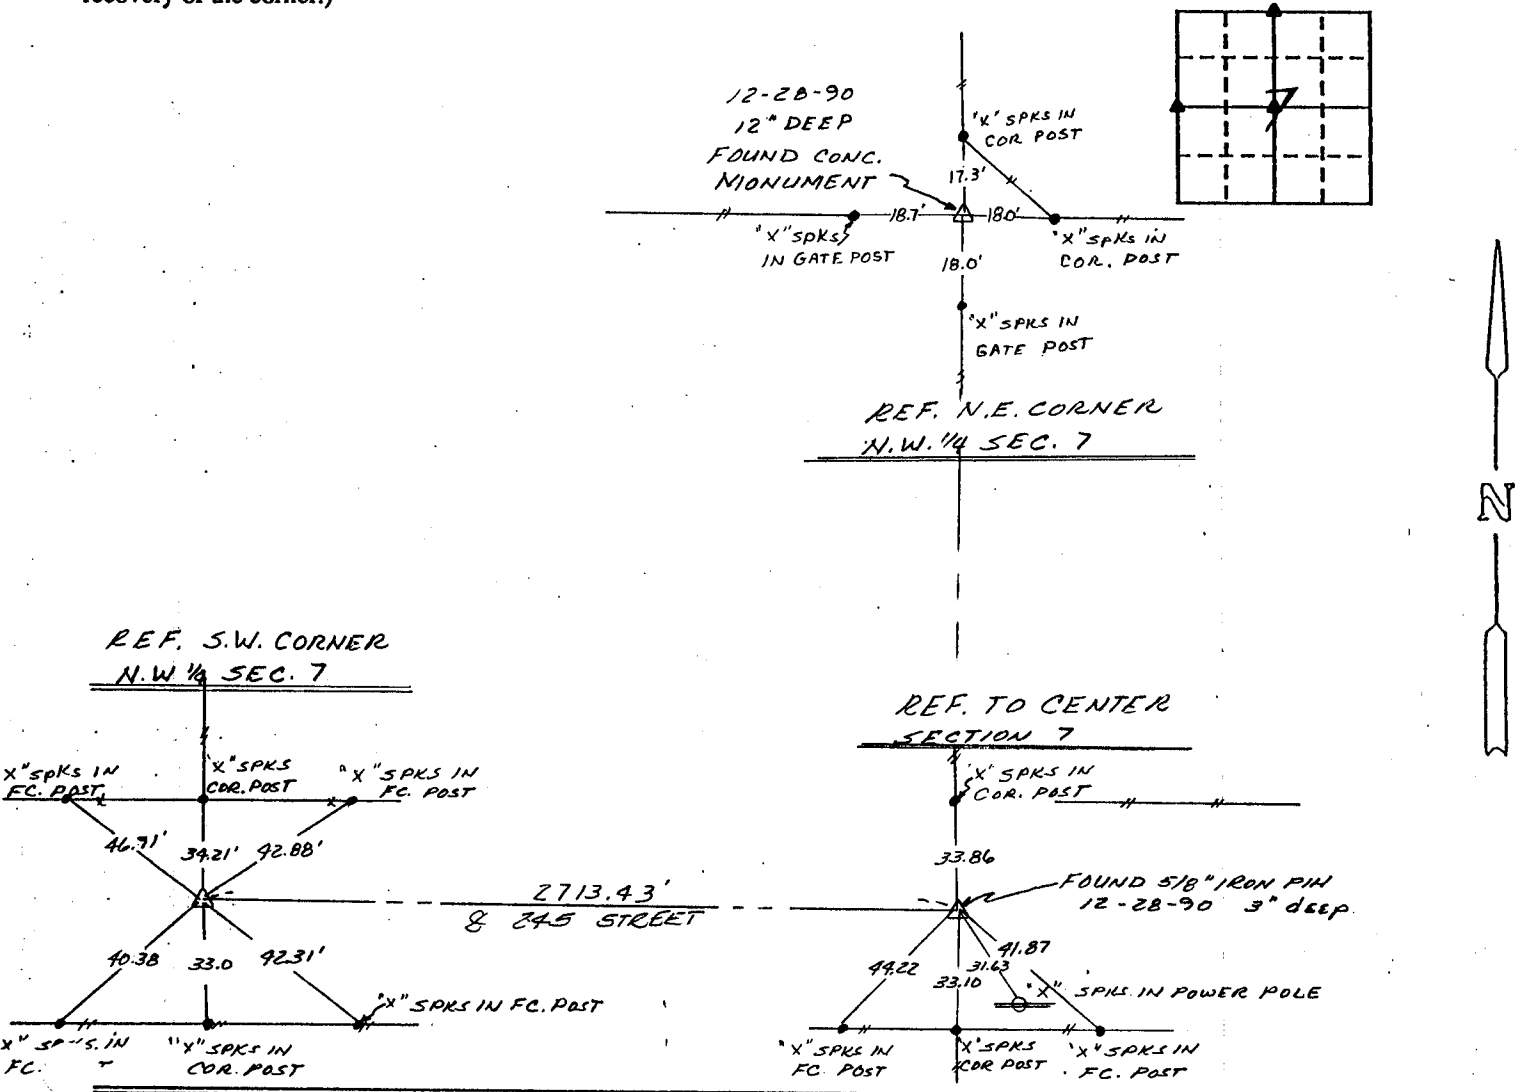

I hereby certify that the survey work was completed and this certificate was prepared by me or under my direct personal supervision and that I am a duly registered land surveyor under the laws of the state of Iowa.

Signature: [Signature]
 Name typed or printed:

Date: Jan 10, 1991 Reg. No. 4204

SEAL

List Corners to be Indexed			
Corners	Section	Twp	Range
N.E. Cor	7	79	3
N.W. 1/4	7	79	3
Center	7	79	3
S.W. Cor.	7	79	3
N.W. 1/4	7	79	3