

00333-98

98 JAN -6 PM 2:41

FEE \$6.00 pd  
*Ralland L. Chesling*  
RECORDER OF DEEDS  
SCOTT COUNTY, IOWA


UNITED STATES PUBLIC LAND SURVEY CORNER CERTIFICATE  
OF

Land Survey Monuments situated in Section 33, Township 79N., Range 3E.,  
of the Fifth Principal Meridian, SCOTT County, Iowa,  
Previously recorded in \_\_\_\_\_ in County Recorder's Office.

(Show reason for preparing this certificate, the evidence and detailed procedures used in establishing the corner positions and monuments found or placed.)  
Monument Description and Remarks: MONUMENT WAS BROKEN OFF AT TOP.

PLAN VIEW

(Show a minimum of three reference ties to durable physical objects, relevant monuments and physical conditions that will enable recovery of the corner.)

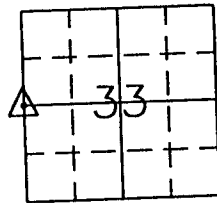

CENTER TOP OF  
FIRE HYDRANT



34.62'

FOUND STANDARD  
MONUMENT BROKEN



13.00'

WEST RIM OF  
WEST WATER VALVE



WVS

14.40'

5/8" IR SET AT BOC  
OF 83rd ST.



I hereby certify that the survey work was completed and this certificate was prepared by me or under my direct personal supervision and that I am a duly registered land surveyor under the laws of the state of Iowa.

Signature: Ralland L. Chesling  
Ralland L. Chesling

Date: January 6, 1998 Reg. No. 13974.

List Corners to be Indexed  
Corners Section Twp. Range  
W1/4 33 79N. 3E.

SEAL

