

UNITED STATES PUBLIC LAND SURVEY CORNER CERTIFICATE

OF

and Survey Monuments situated in Section 21, Township 80, Range 4, of the Fifth Principal Meridian, Scott County, Iowa.
Previously recorded in Does not apply in County Recorder's Office.



(book, page, document number, etc.)

(Show reason for preparing this certificate, the evidence and detailed procedures used in establishing the corner positions and monumentation found or placed.)

Monument Description and Remarks: Monument information obtained from Scott County Engineer's Office.

PLAN - VIEW

(Show a minimum of three reference ties to durable physical objects, relevant monuments and physical conditions that will enable recovery of the corner.)

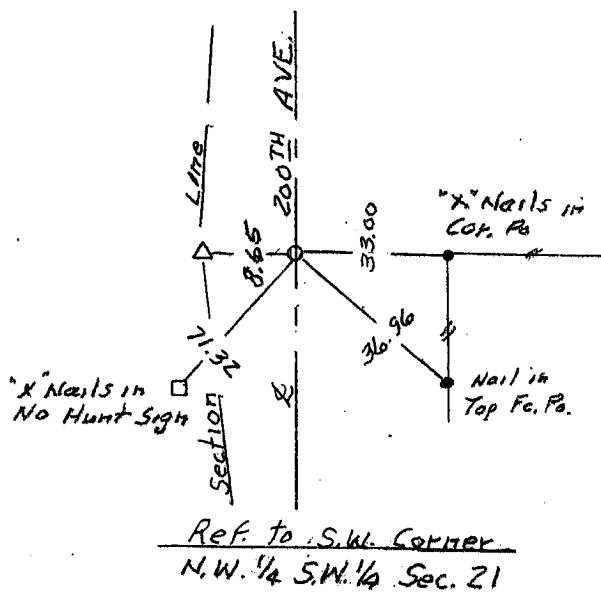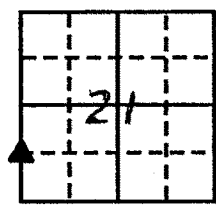

I hereby certify that the survey work was completed and this land surveying document was prepared by me or under my direct personal supervision and that I am a duly registered land surveyor under the laws of the state of Iowa

Signature: Marvin E. Hinkle
Name typed or printed:

Date: April 1, 2005 Reg. No. 4204

My registration renewal date is December 31, 2005

Corners	List Corners to be Indexed		
	Section	Twp	Range
S.W. corner	21	80	4
N.W. S.W.			

SEAL

