


T. 77 & 78 N. R. 3 E. OF 5<sup>TH</sup> P. M.

ROCKINGHAM

TOWNSHIP

- 1 Gas pipe S.W. Cor. NW 1/4 Sec 6. It is in E. betw. Fences and on line Fence E + W
- 2 Stone S.W. Cor. Sec 6. It is 43° E. of spike in blazed Oak. It is 33° W. of gas pipe and it is 3° N. of E + W Fence
- 3 Iron nail S.E. Cor. S.W. 1/4 Sec 6. It is on E side of Cor. post
- 4 Gas pipe Ch. of Sec 7. It is 3/4' W. of spike in hedge tree
- 5 Stone S.W. Cor. NW 1/4 Sec 7. It is 89° North of spike in cattan wood on South side of creek. It is 21° S.E. from 2 spikes in Cor. post. It is 18' S. of fence West. It is 30° East of hedge + 20° West of fence. It is 119° N.E. of spike in white oak
- 6 Stone S.W. Cor. NW 1/4 of SW 1/4 Sec 7. It is on line of Fence South and 20' N. of Fence North
- 7 Stone S.E. Cor. NE 1/4 SW 1/4 Sec 7. It is on line of Fence W. 4 1/2' Ft. West of stump which is present Fence Corner
- 8 Error No Stone
- 9 Stone S.E. Cor. Sec 7. It is about 2' South of Fence Corner
- 10 Stone S.W. Cor. S.W. 1/4 Sec 7. It is by Cor. post
- 11 Stone S.W. Cor. Sec 9. It is 55° S.E. of spike in Burr Oak, 56° N.W. of spike in White Oak. It is 44° N.W. of spike in Elm
- 12 Lane Mon. S.W. Cor. NW 1/4 Sec 18. It is on fence line East end is about in E. betw. Fences
- 13 Stone Ch. of Sec 18. It is about 2 1/4' Ft. N.E. of tree
- 14 Stone Ch. of Sec 6. It is 1/2' West of West face of Cor. post. It is 8 3/4' East of East face of 36" Burr Oak
- 15 Stone SW Cor NW 1/4 Sec 31. It is on West side of Cor. post. It is about 3' deep
- 16 Stone Ch. of Sec 31. It is 4 1/2' Ft. West + 2 1/2' Feet South of tree Cor. post
- 17 Stone S.E. Cor. of NE 1/4 of Sec 31. It is 3' South of Cor. post
- 18 Stone SW Cor. Sec 32. It is on line of Fence West and 1/2' N. North of Cor. post. There is a cross on top of stone
- 19 Cross on E. paving SW Cor. Sec 31
- 20 Gas pipe Ch. of Sec 32. It is 3/4' Ft. South of Fence
- 21 Stone S.E. Cor. of NE 1/4 of Sec 32. It is 21' West of West edge of paving. It is 22' S. of North of Lane Drive to Residence

22 NW Cor Section 8 Iron bar by Boudinot Replaced with Conc. Monument 74.4 NE of RR spike in base of 20" Oak. 66' NW of SW Cor. of Barn + 20' SW of Fence

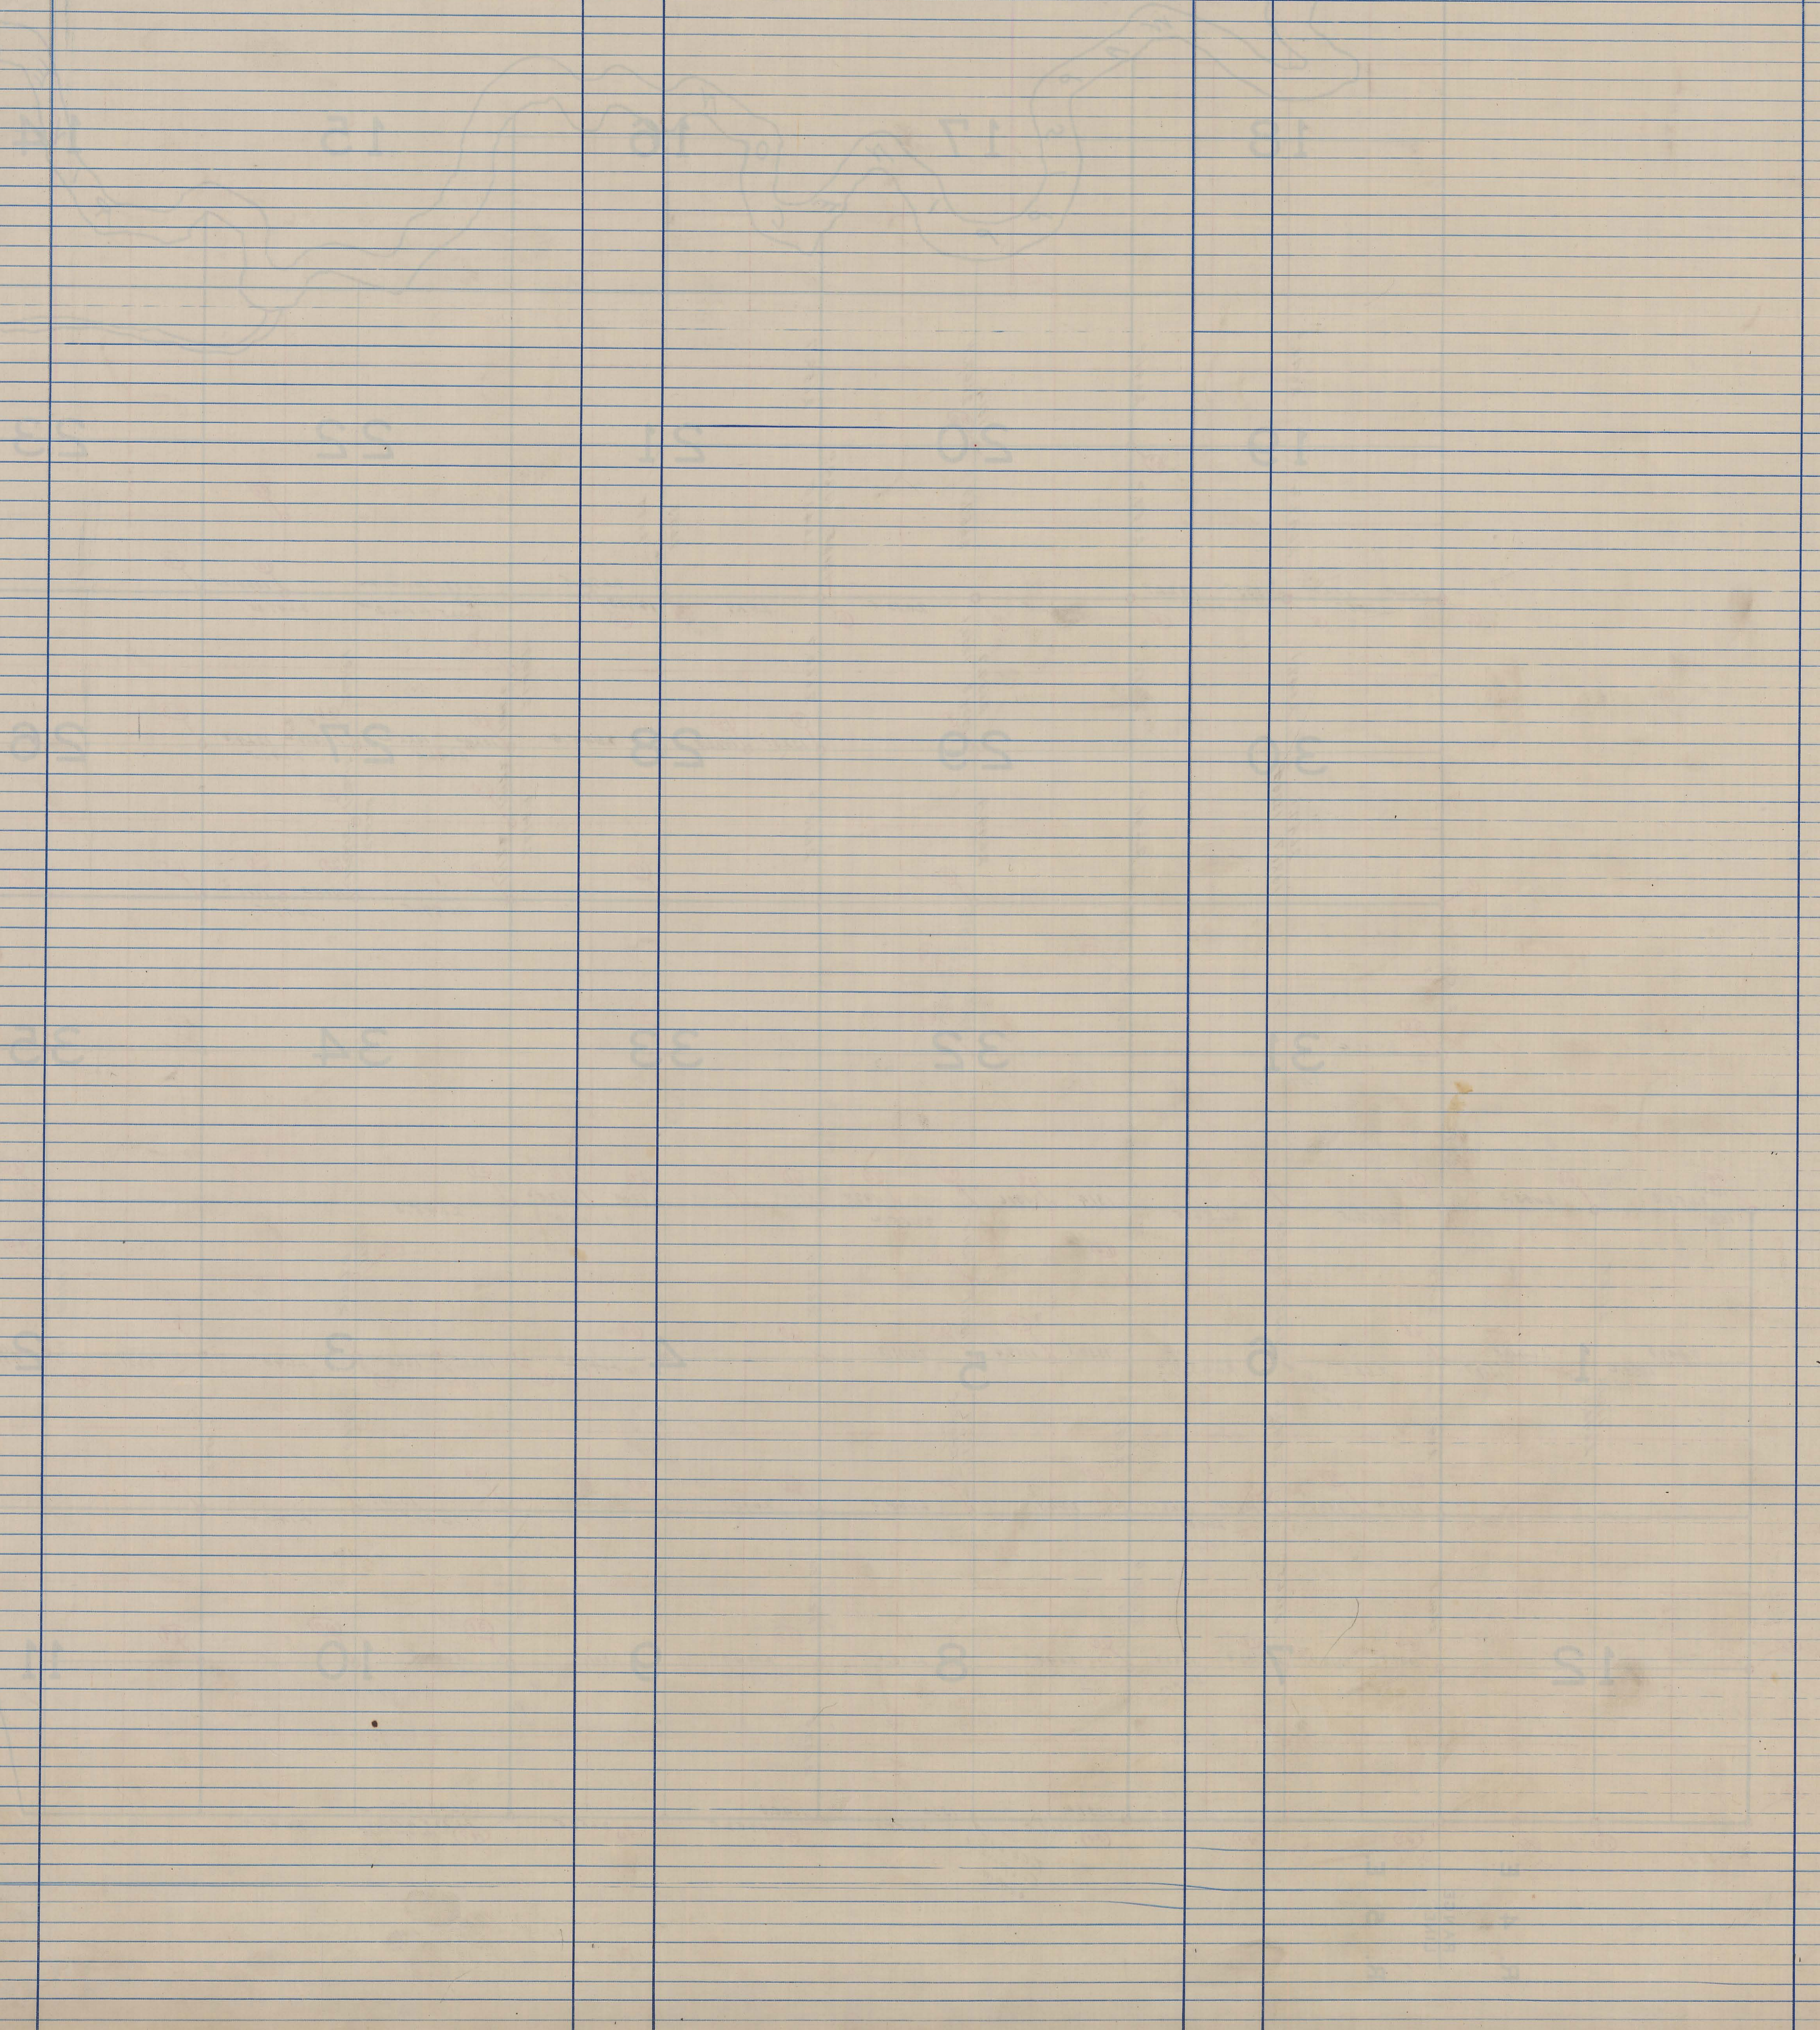

T. 77 & 78 N. R. 3 E. OF 5TH P. M.  
 ROCKINGHAM TOWNSHIP

T. 78 N.  
 TOWNSHIP LINE  
 T. 77 N.

