
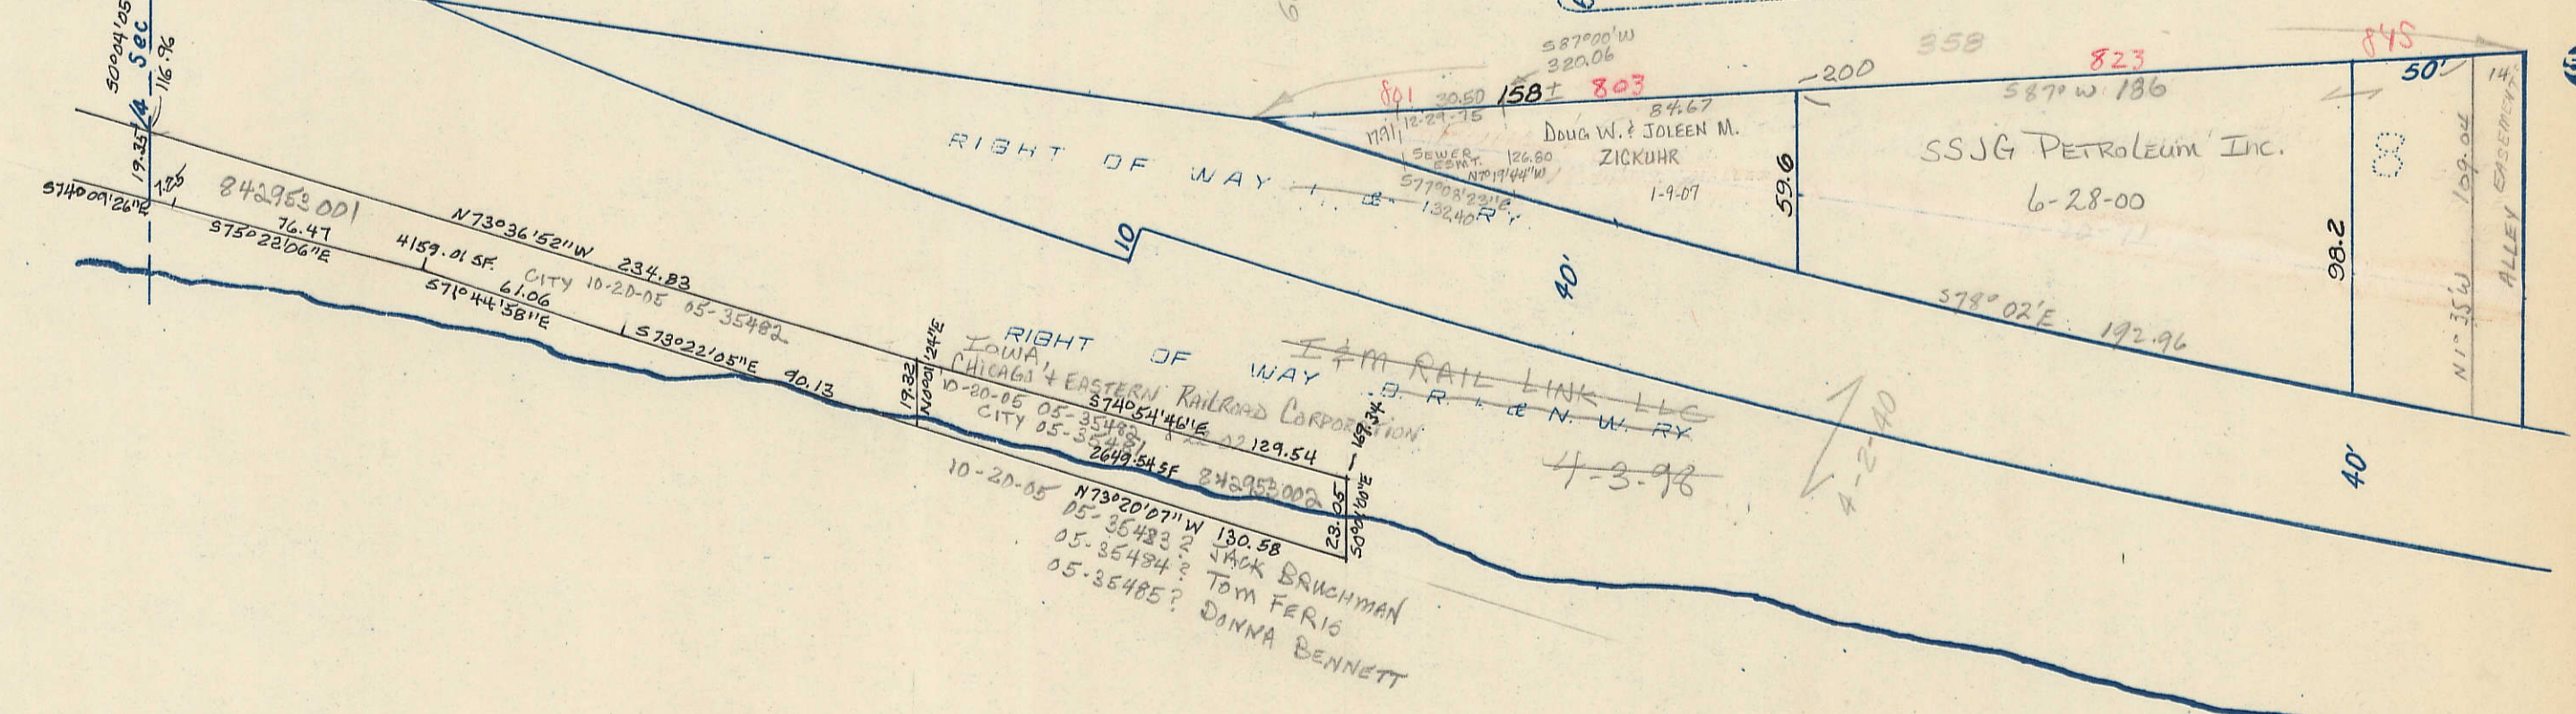
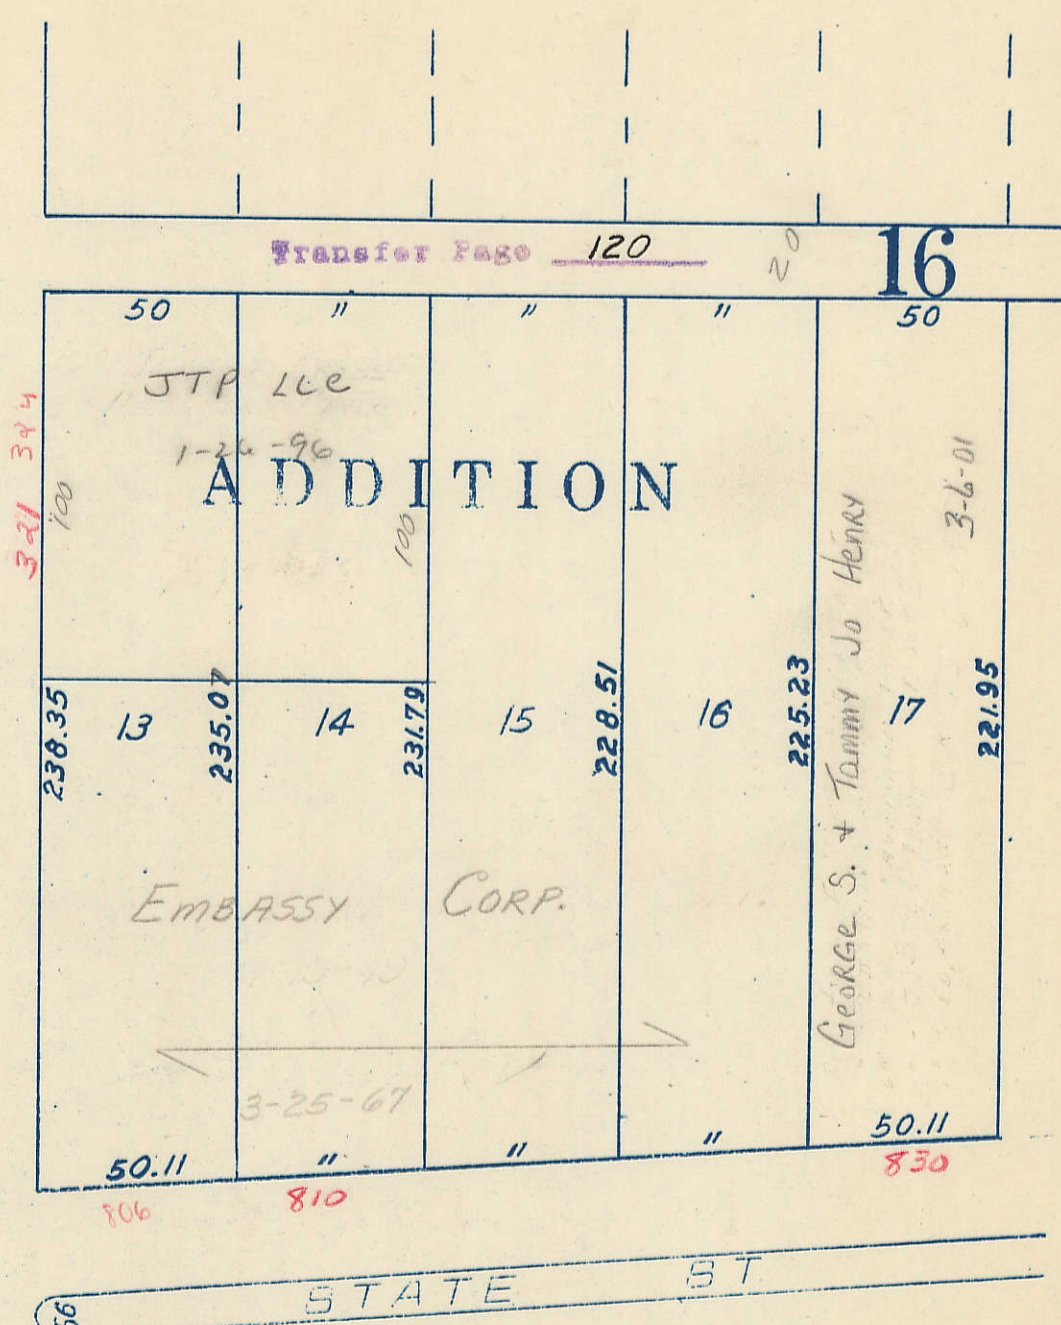


53

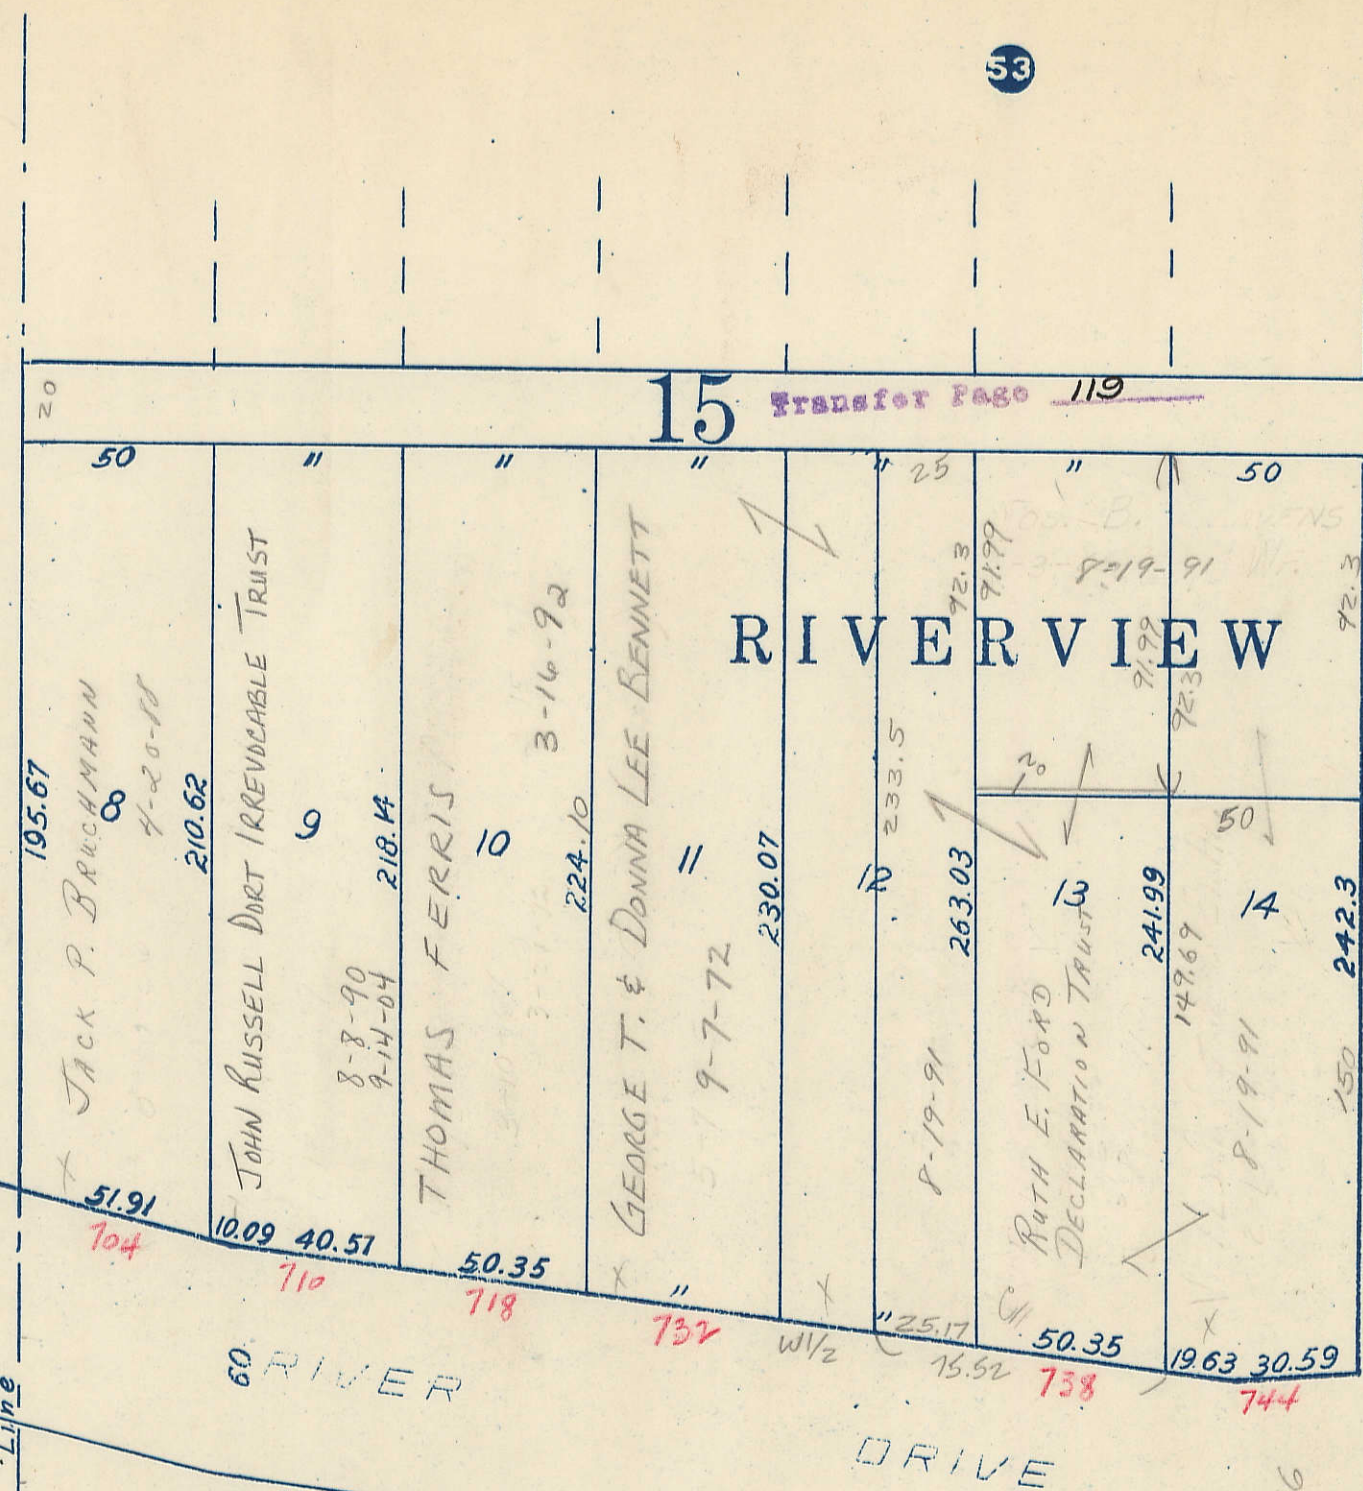

