


NE-NW-SW 28-78-4

66

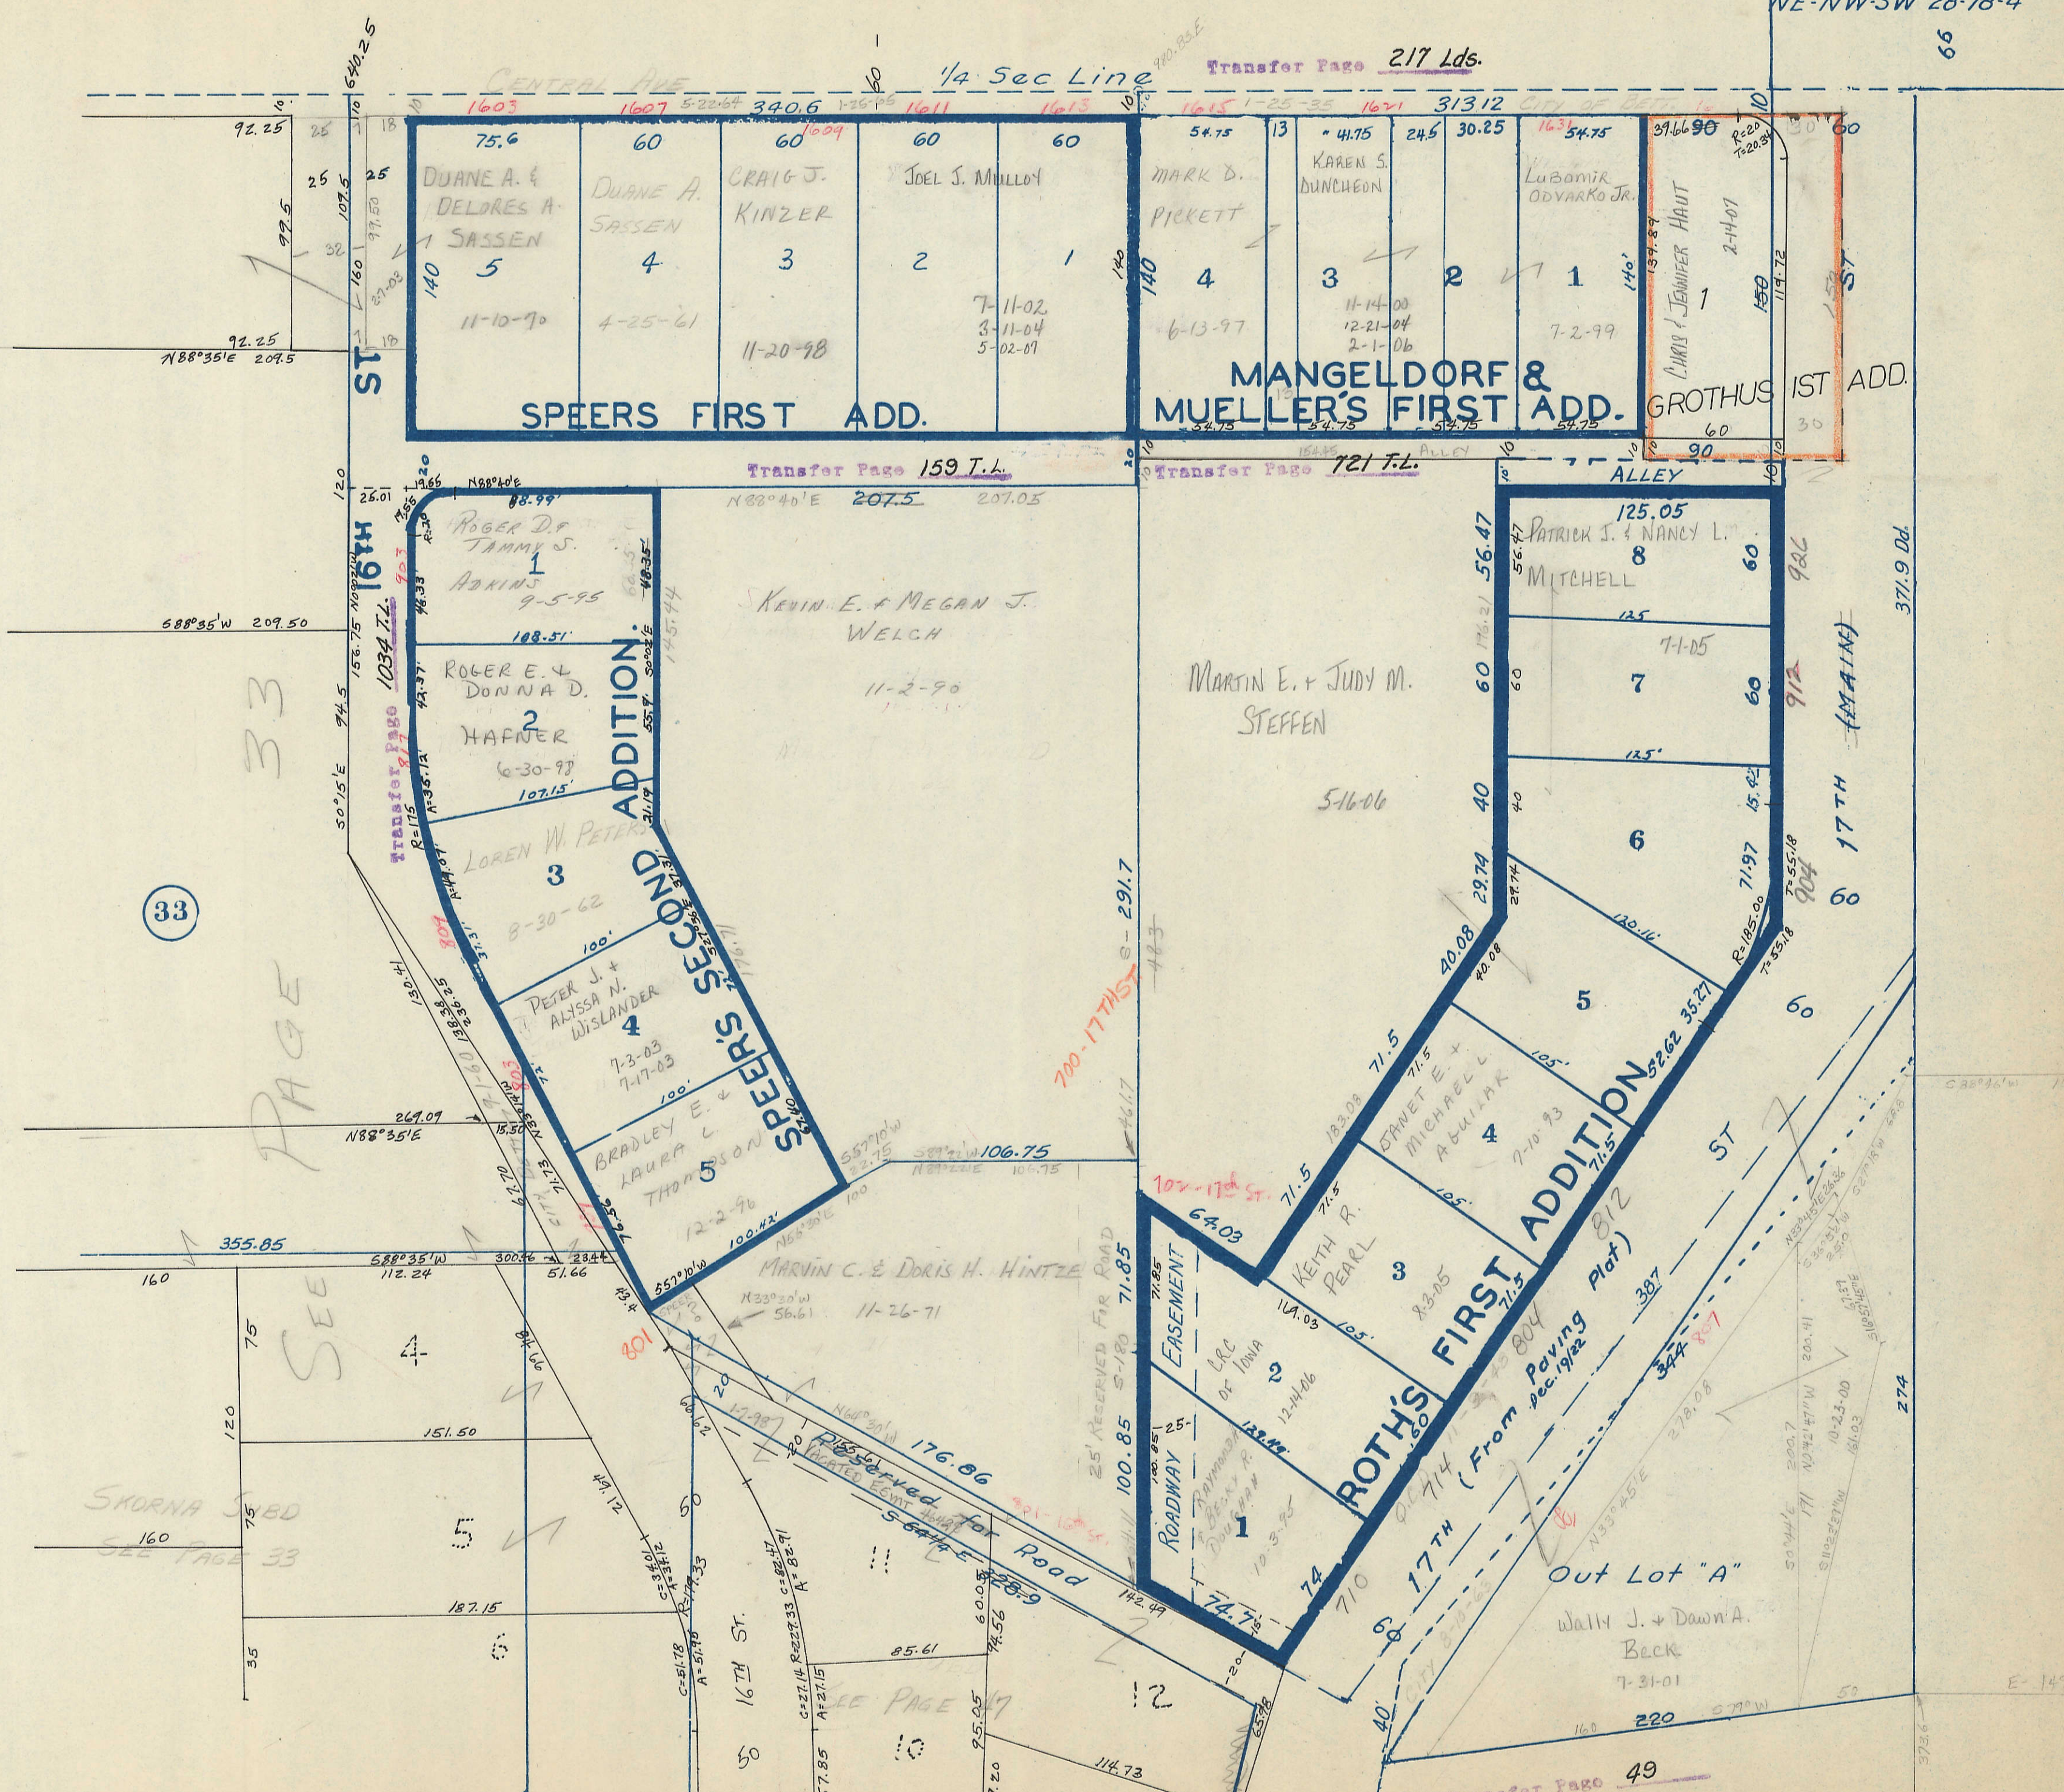

PAGE 33 SEE

Transfer Page 49