


REPLANT OF
OTTO'S ADD.

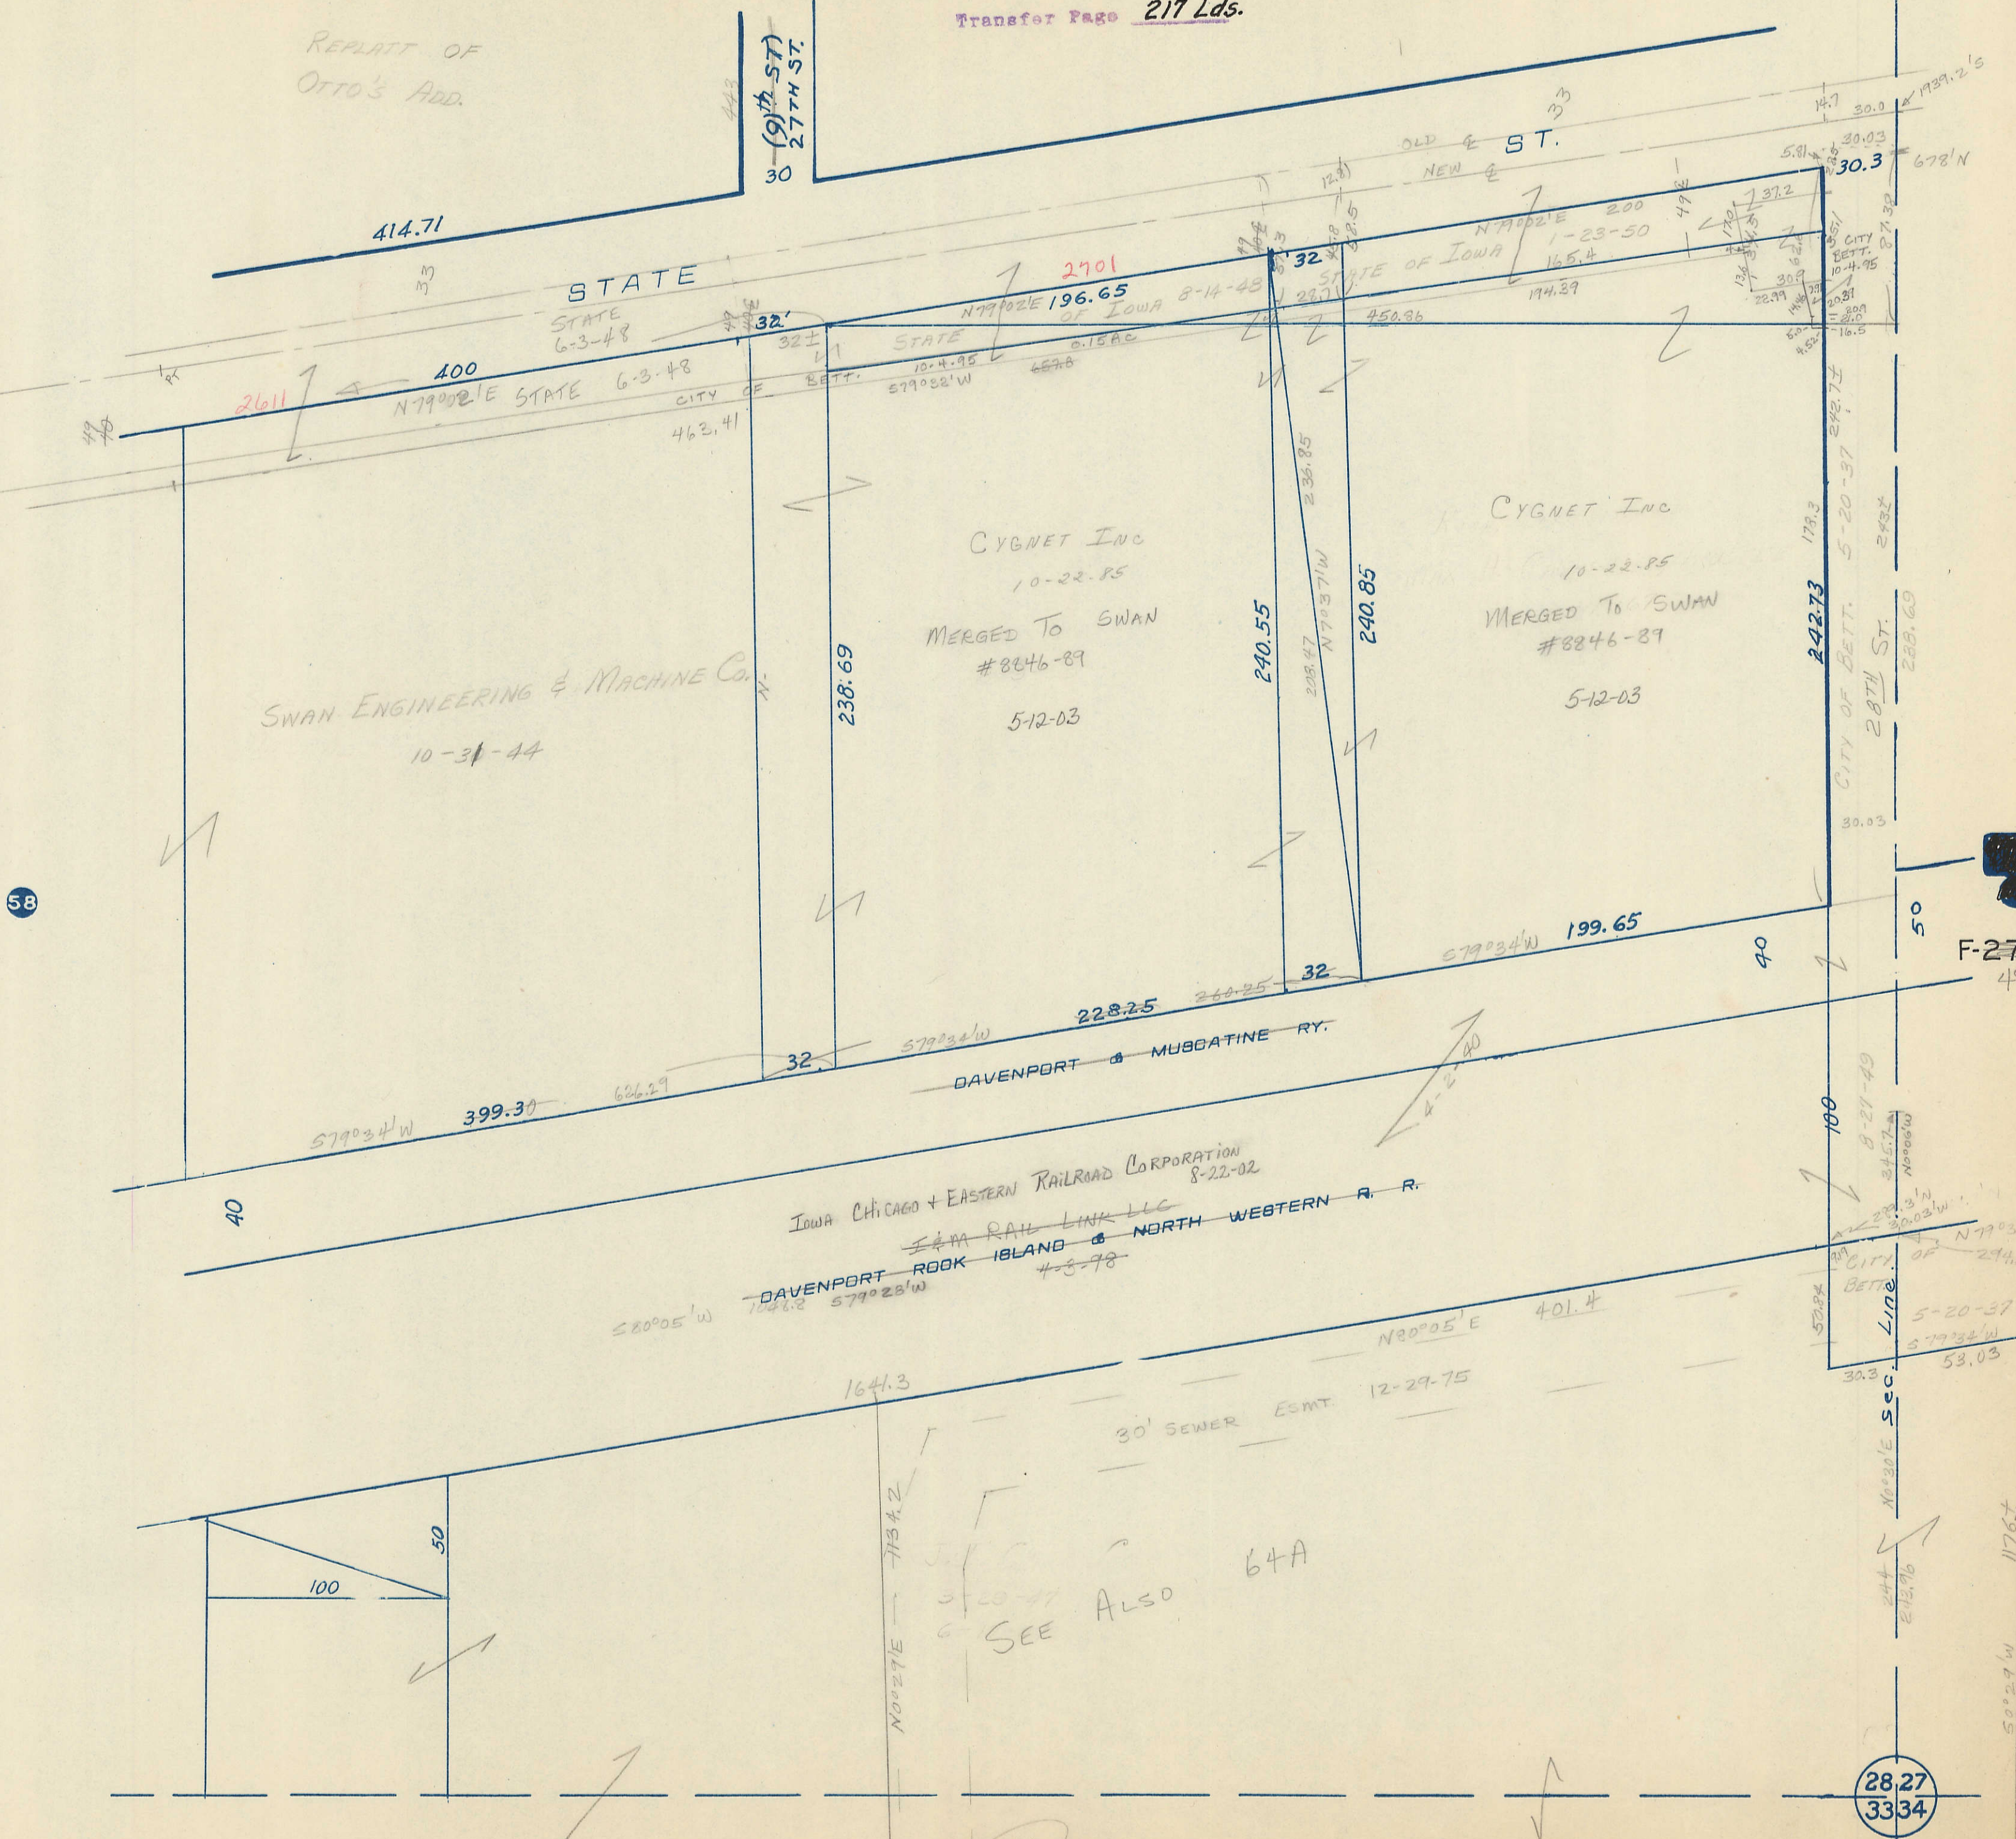

58

F-27A

28 27
33 34

65

64A