
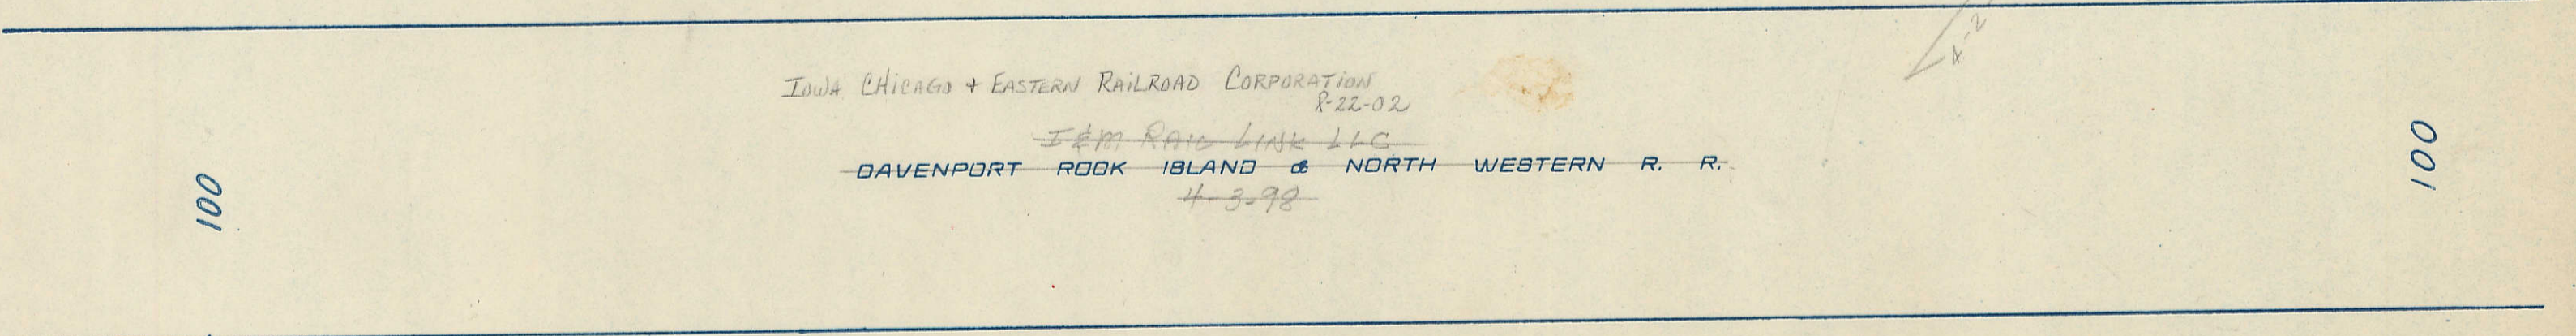
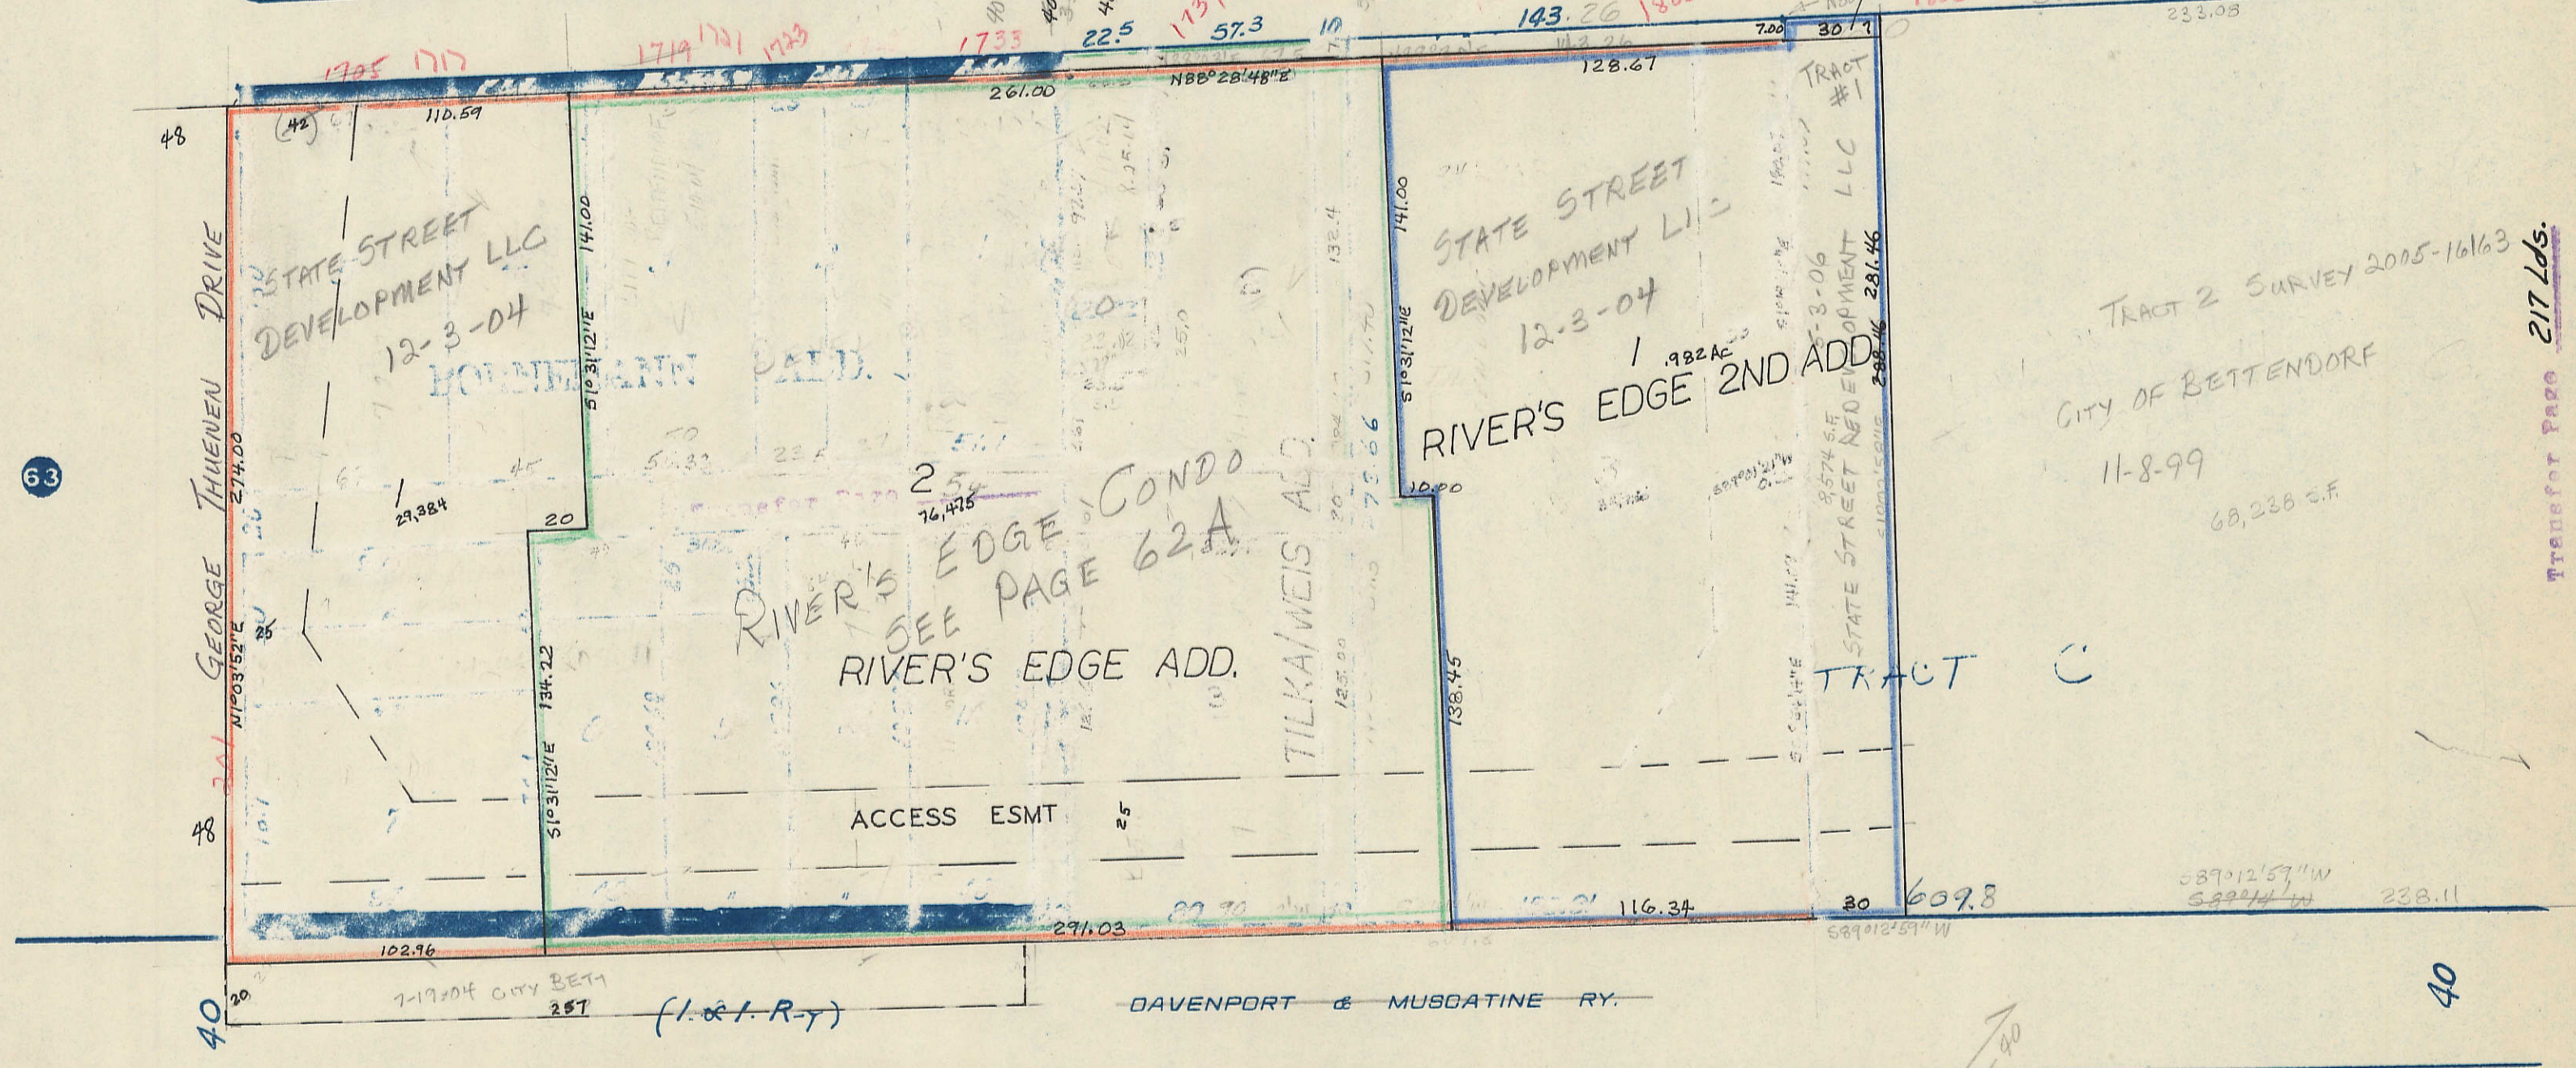


Transfer Page 48

Transfer Page 47

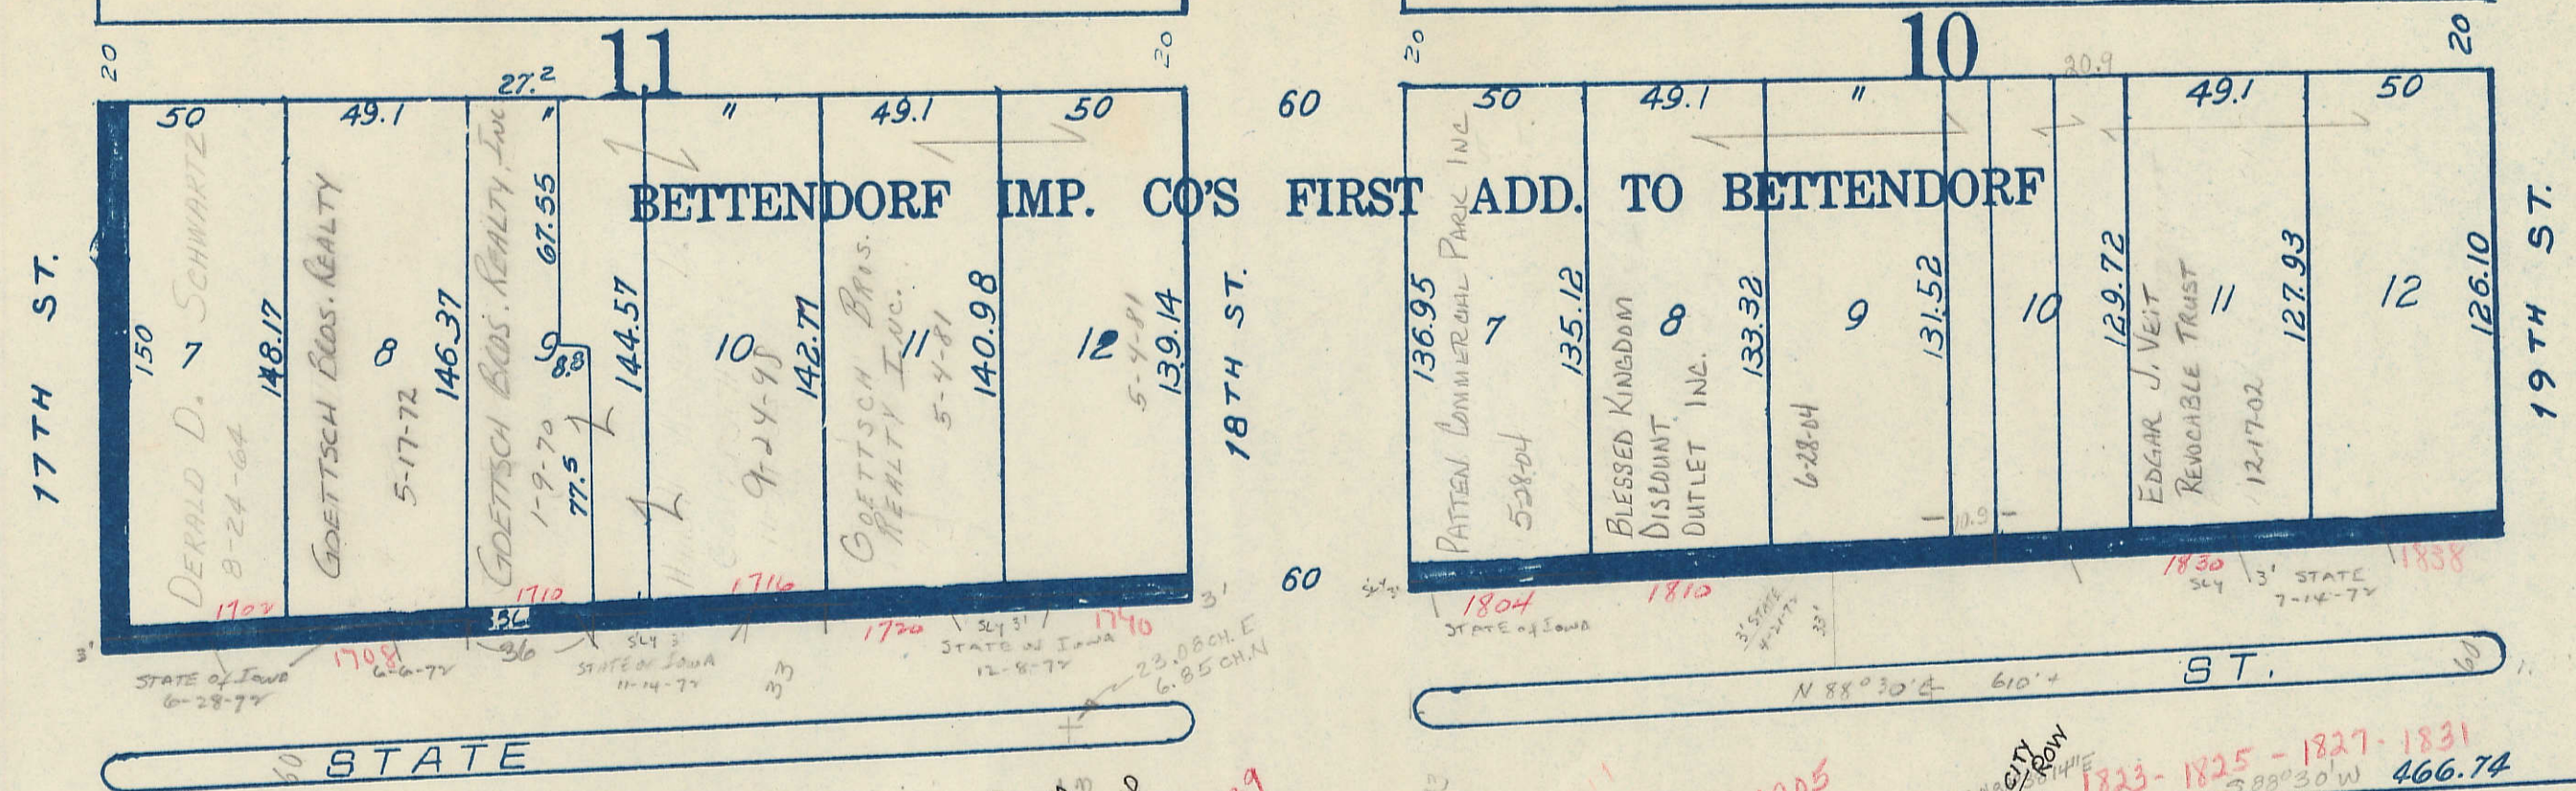

J.I. One Co. 64 A
2-2-97

63

Transfer Page 217 Lds.

61