


FRACTIONAL SEC. 33-78-4
SCALE: 1"=400'

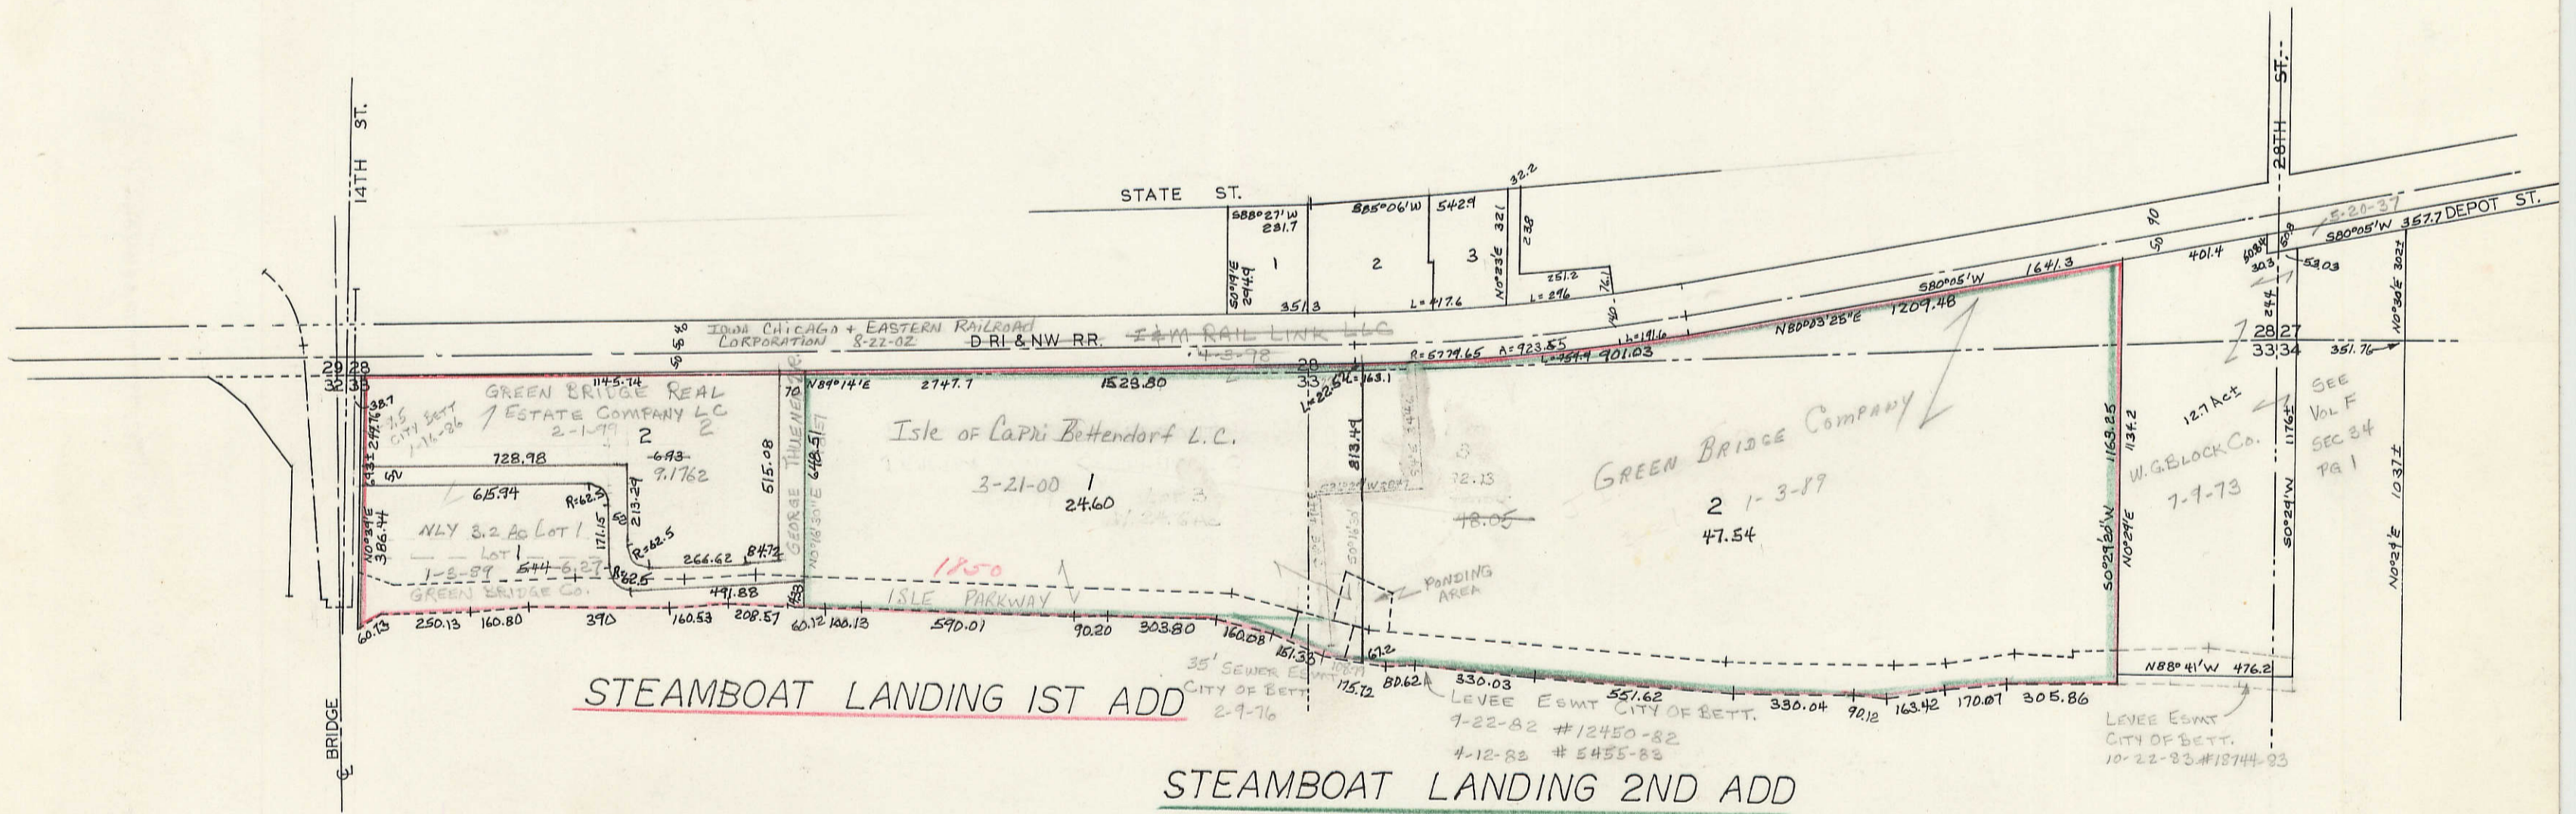

1"=400'