


Transfer Page 211
LD.

(23)

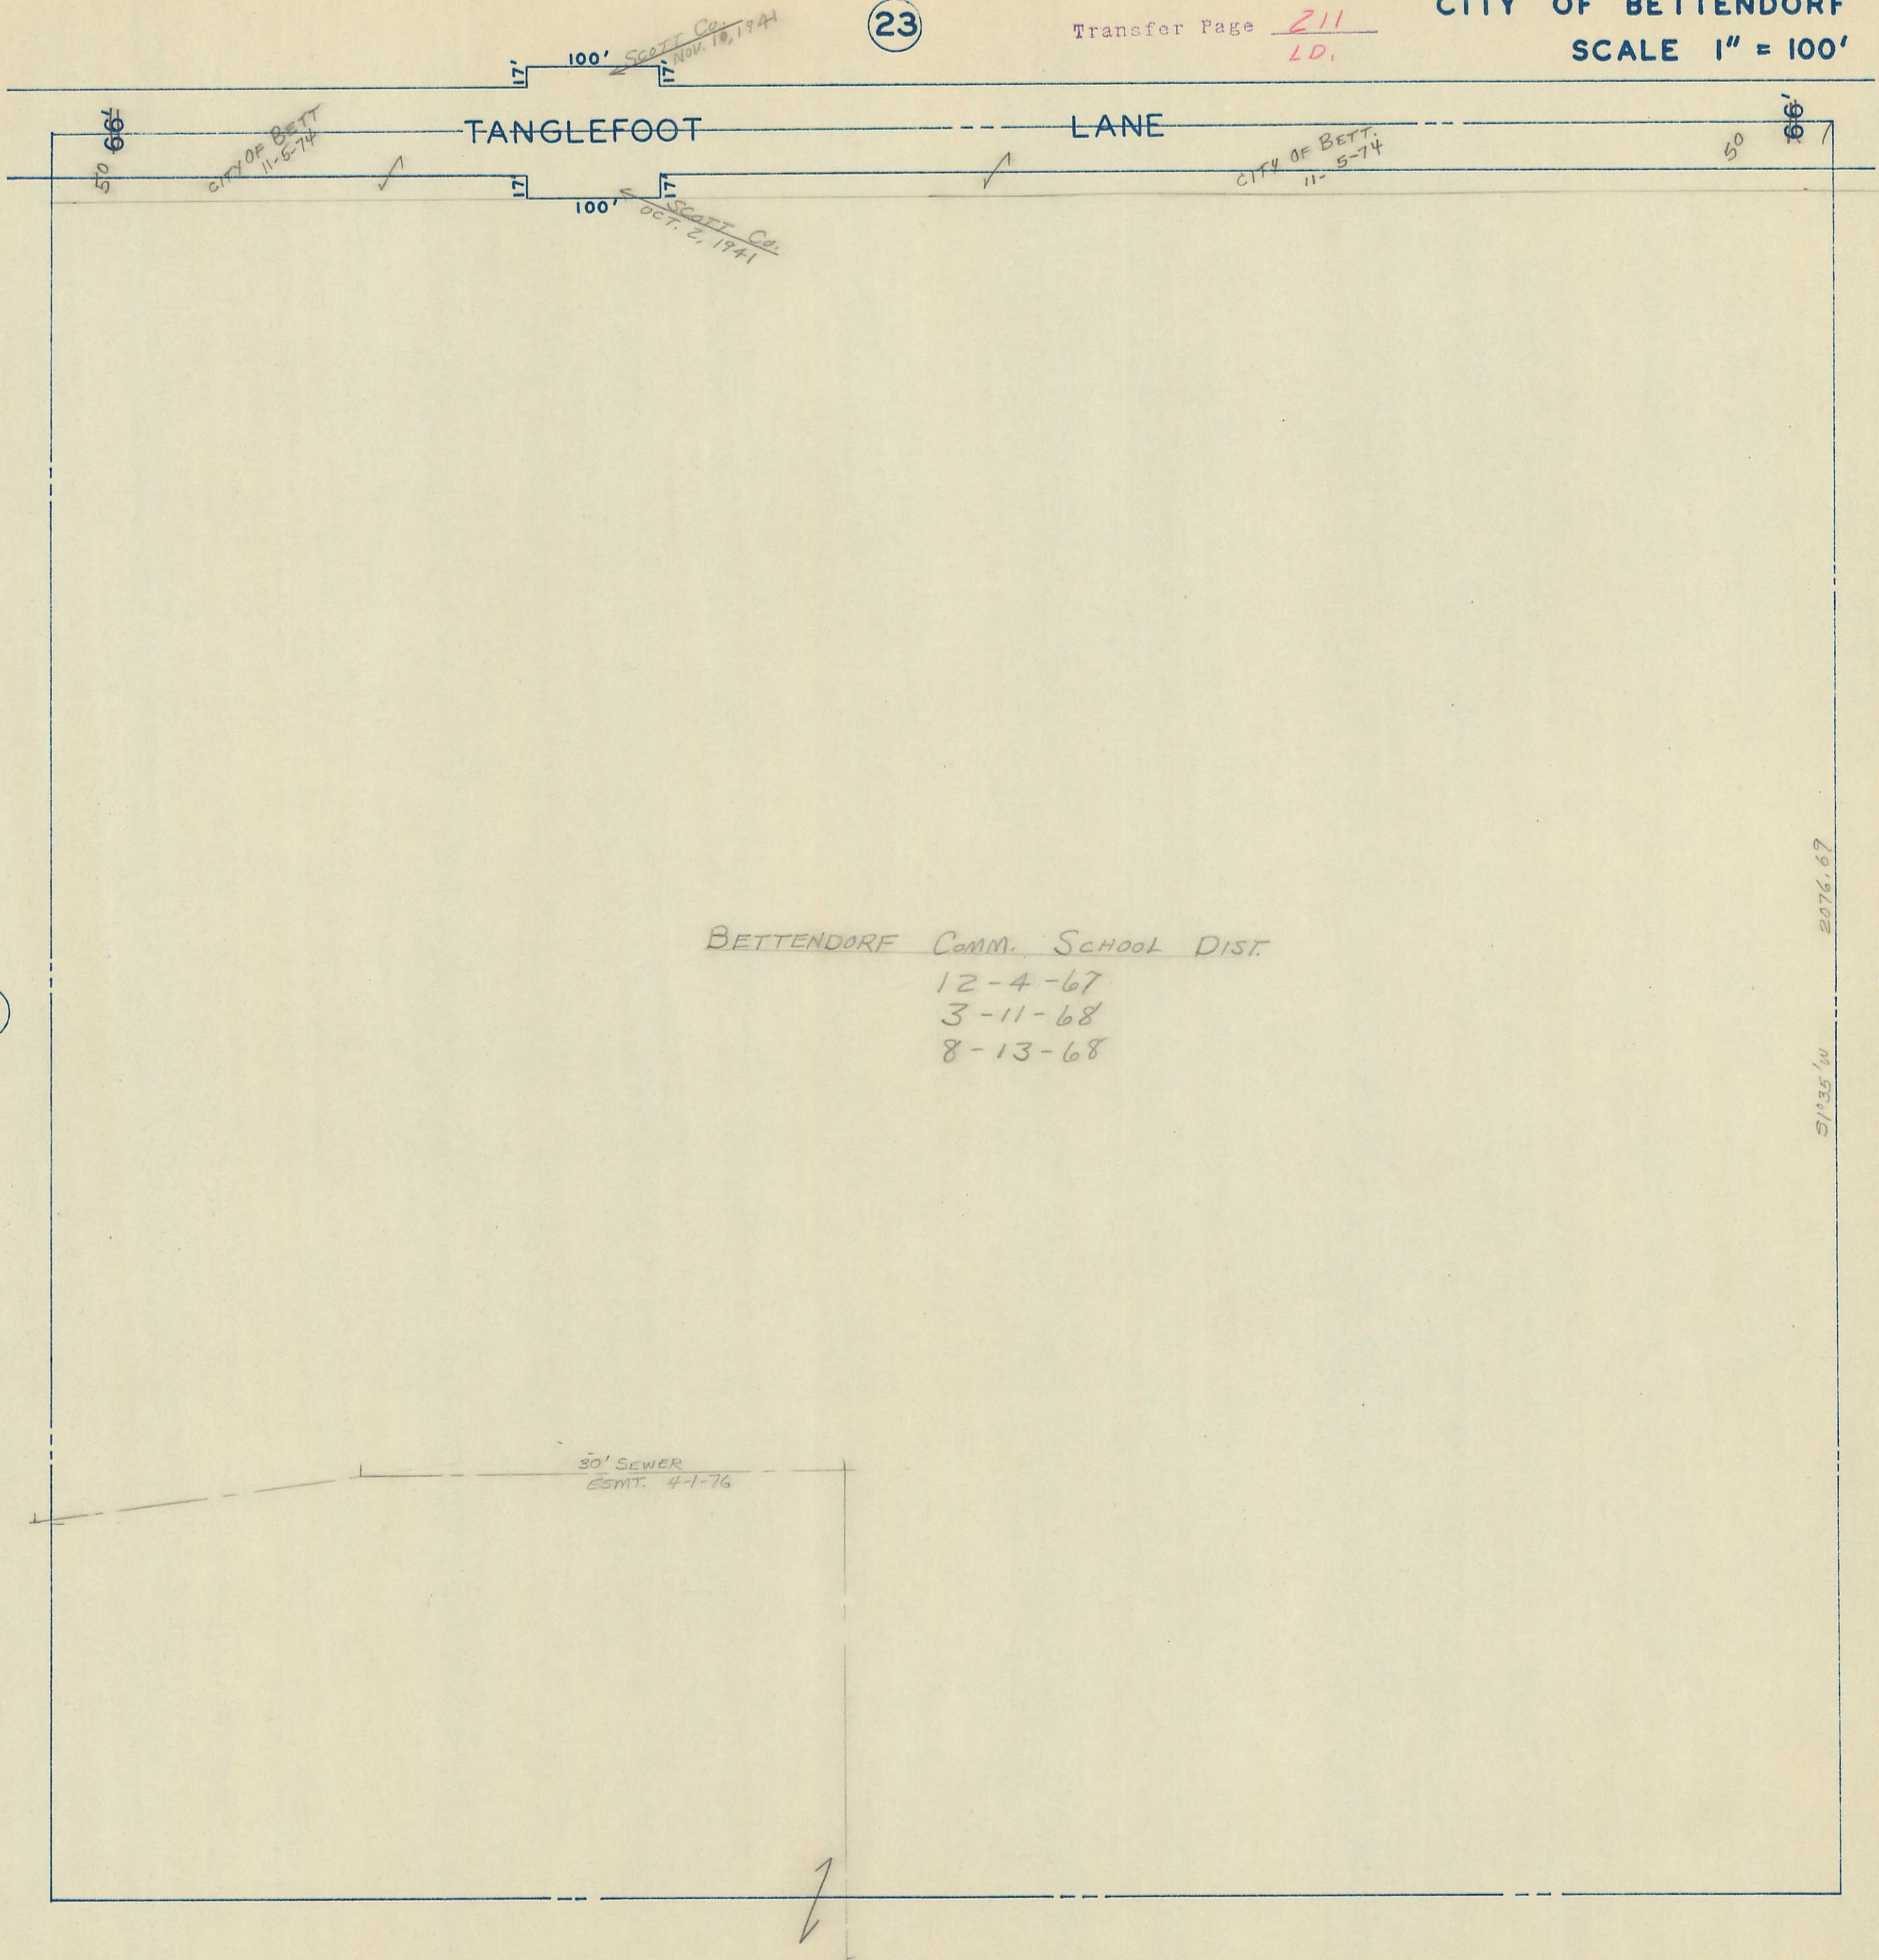

(37)

51'35" W 2076.67

(33) SEC. 15

(55)