


5

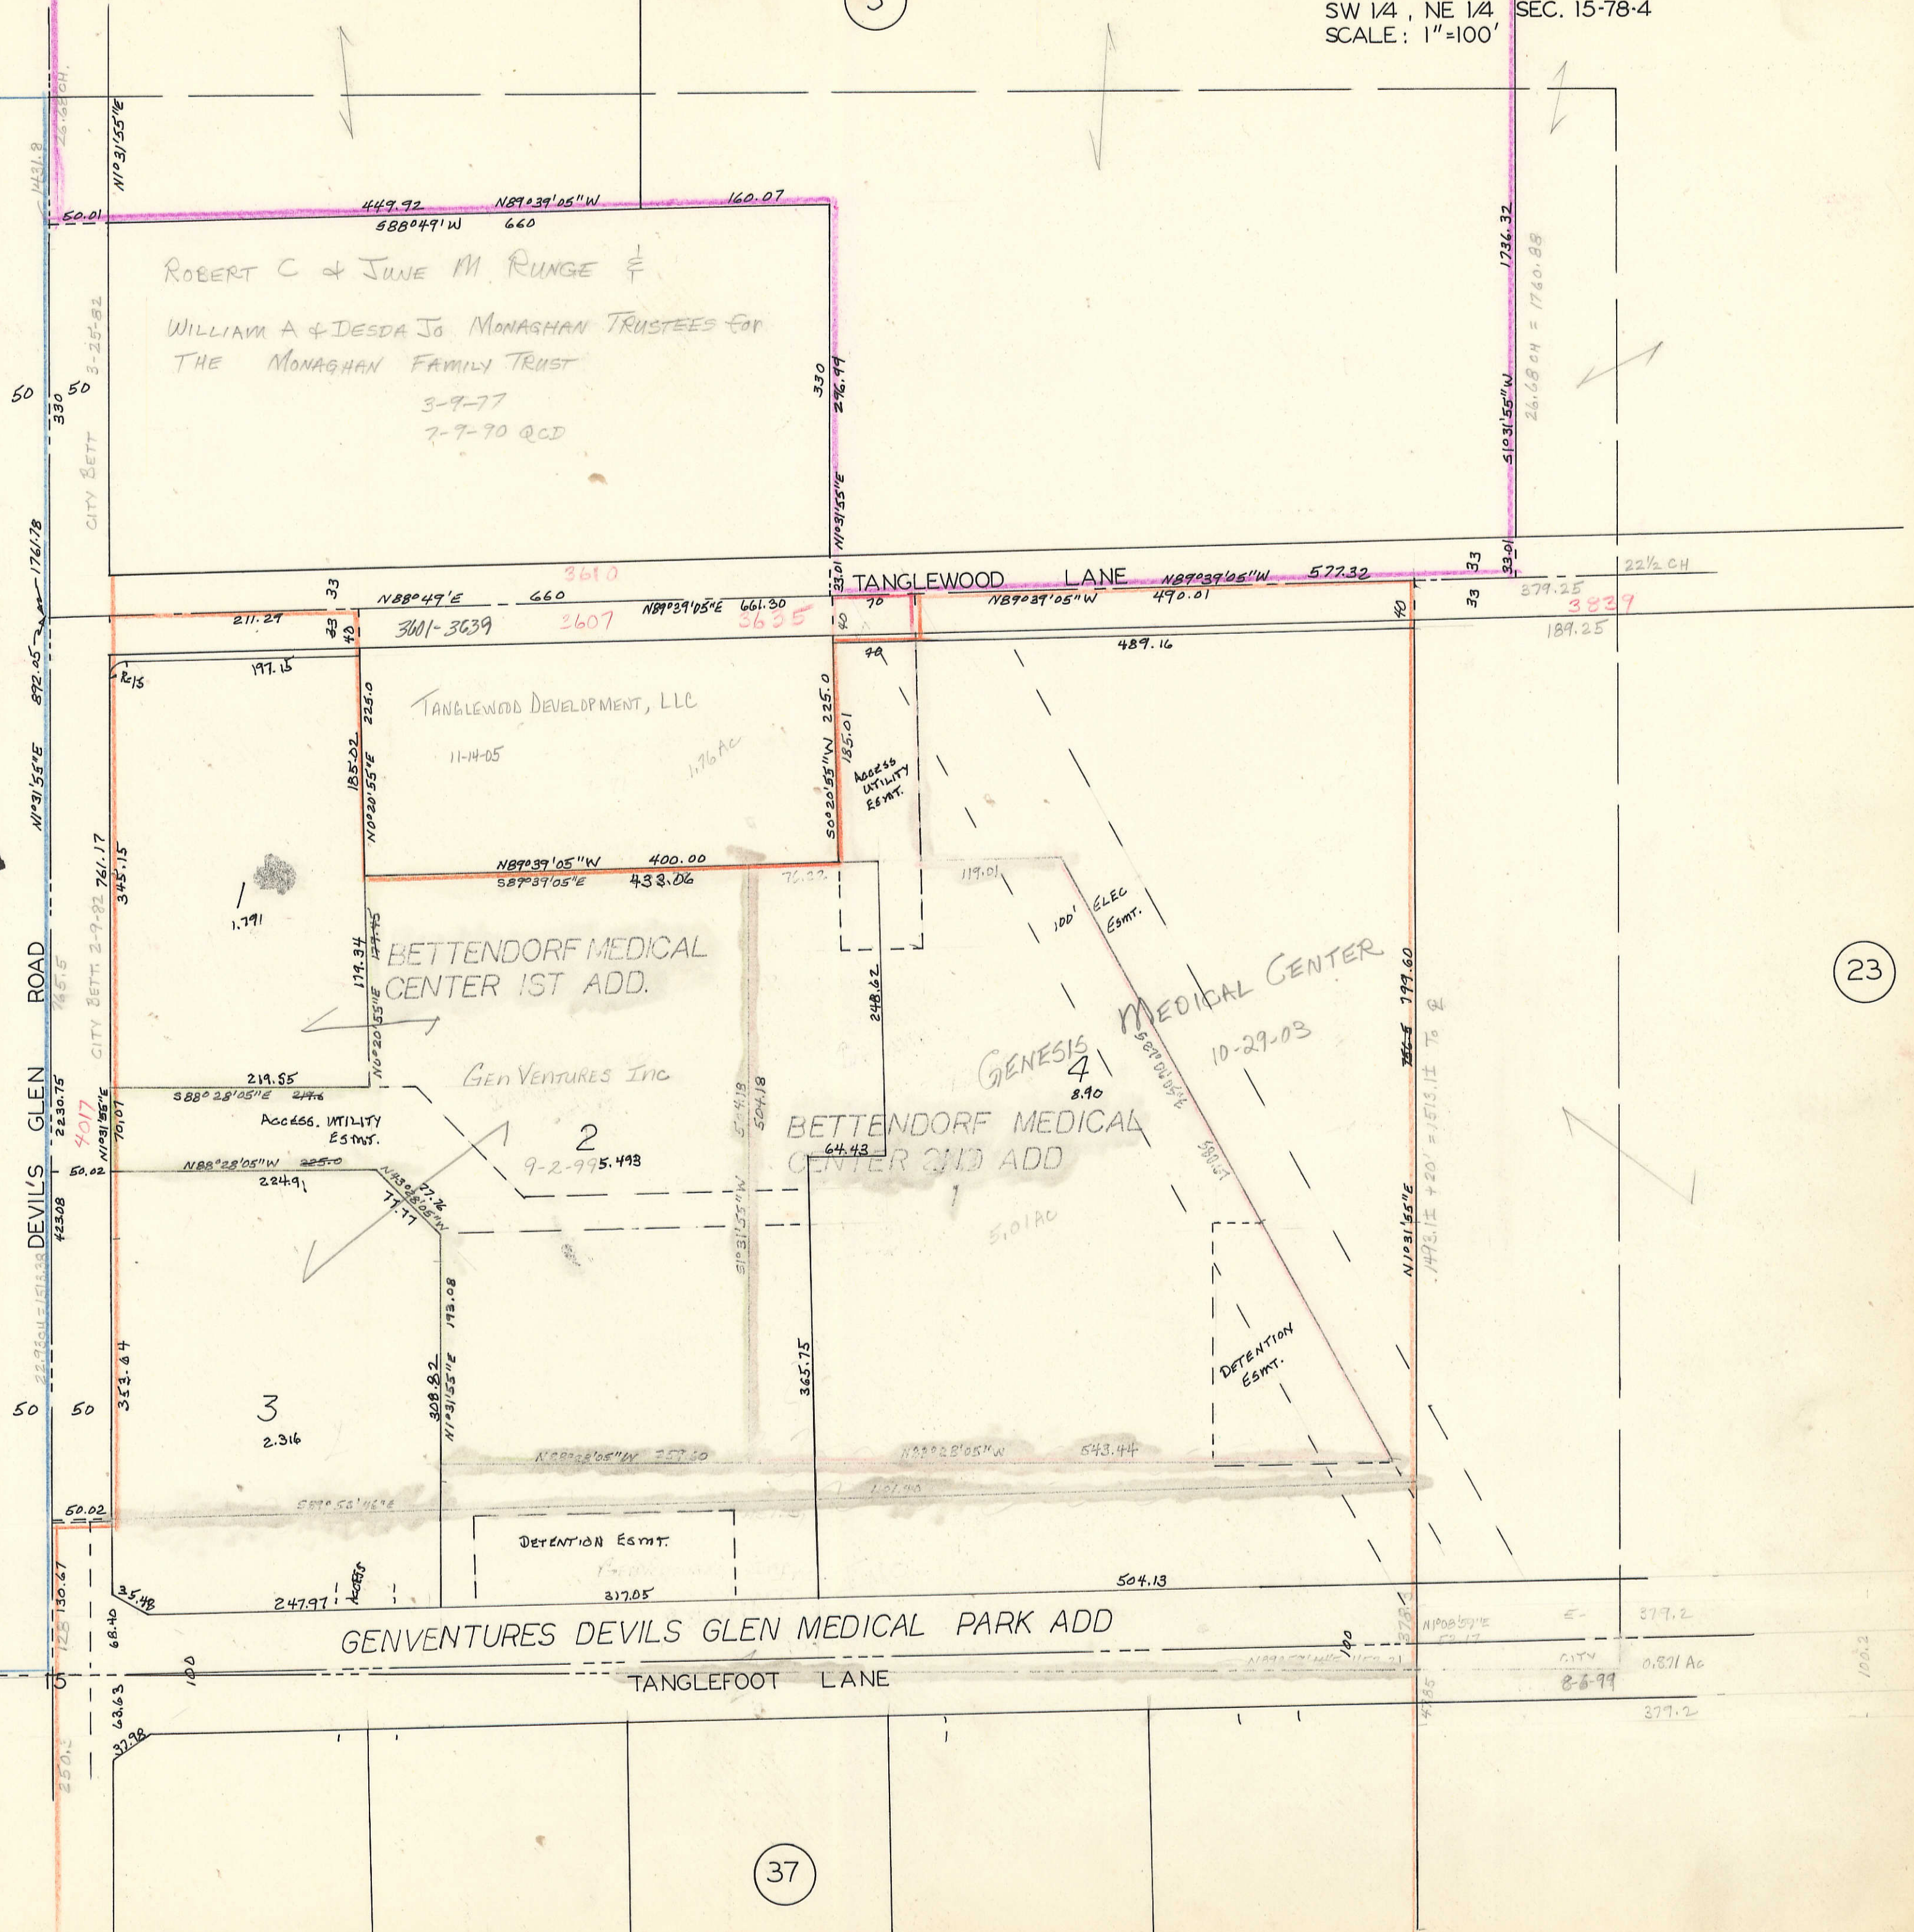

ROBERT C & JUNE M. RUNGE &
 WILLIAM A & DESDA JO. MONAGHAN TRUSTEES FOR
 THE MONAGHAN FAMILY TRUST
 3-9-77
 7-7-90 QCD

TANGLEWOOD DEVELOPMENT, LLC
 11-14-05
 1.76 AC

BETTENDORF MEDICAL
 CENTER 1ST ADD.

Gen Ventures Inc

BETTENDORF MEDICAL
 CENTER 2ND ADD

GENESIS 4
 8.90

MEDICAL CENTER
 10-29-03

DETENTION ESMT.

DETENTION
 ESMT.

GENVENTURES DEVILS GLEN MEDICAL PARK ADD

TANGLEFOOT LANE

19

23

37