


51 SEC. 14

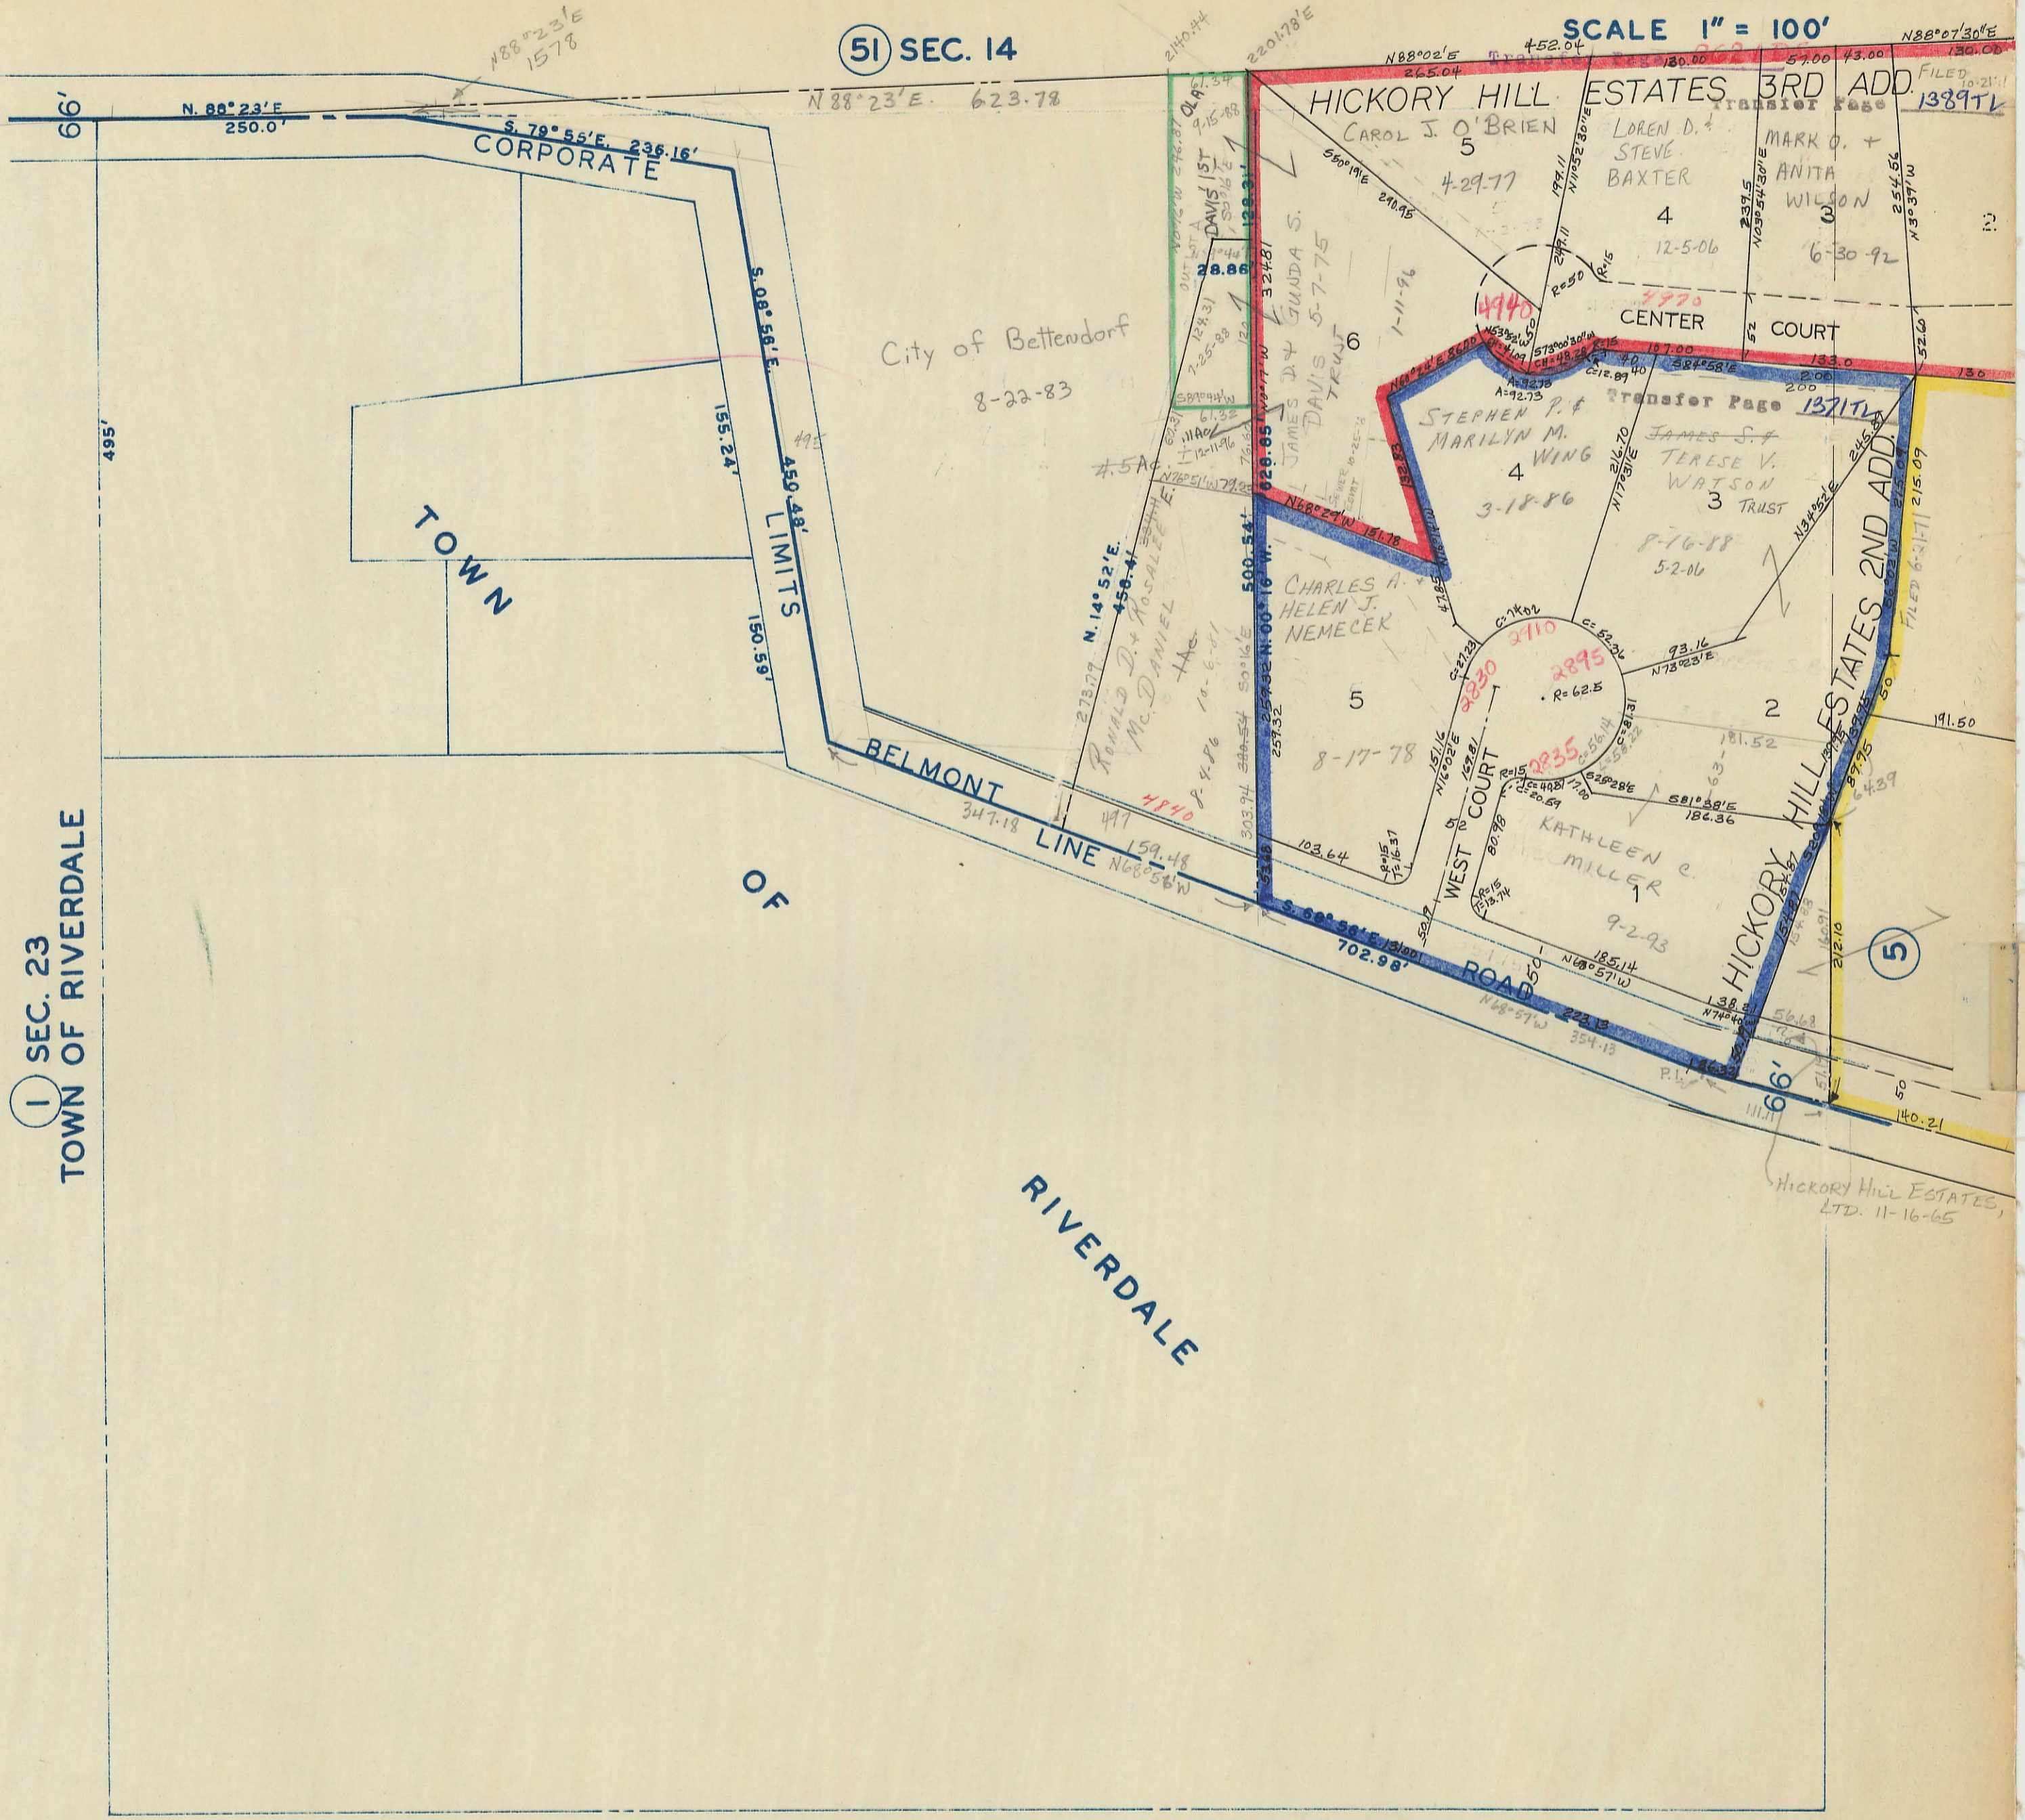

1 SEC. 23 TOWN OF RIVERDALE

RIVERDALE

Sec 23-78-4