


23

Transfer Page 359LDS

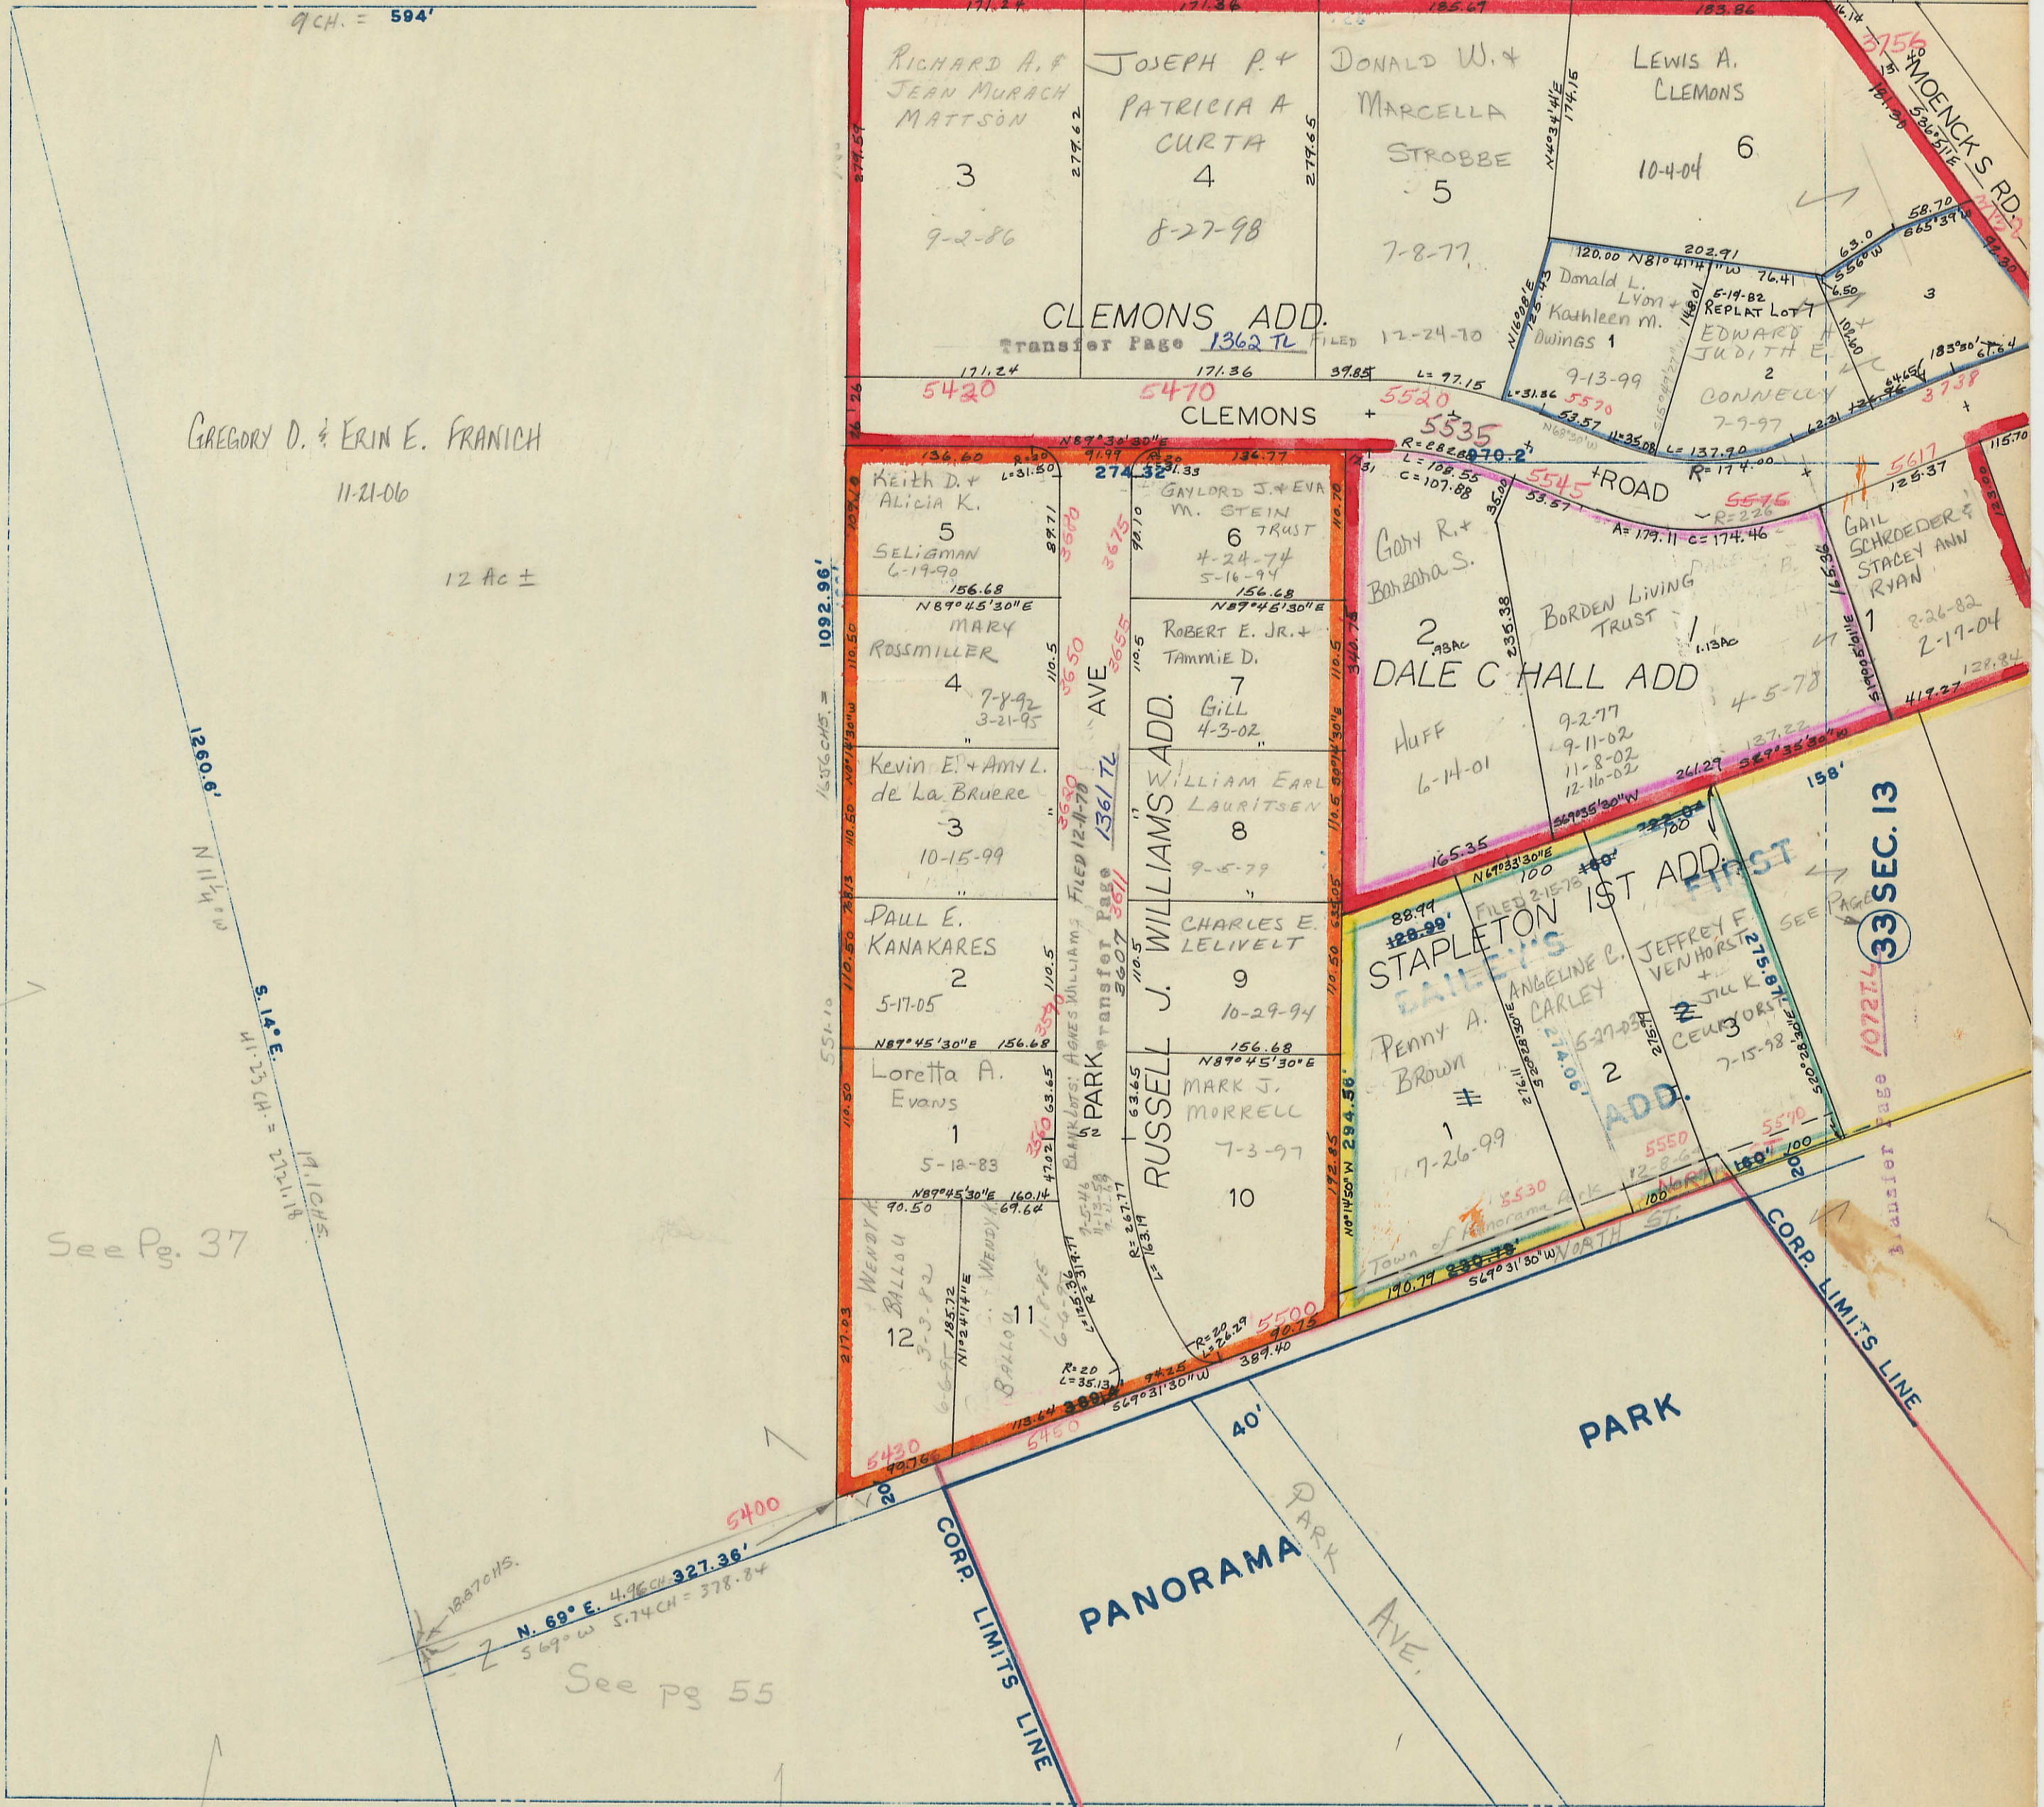

GREGORY D. & ERIN E. FRANICH  
11-21-06  
12 Ac ±

See Pg. 37

See pg 55

37

33 SEC. 13

55