


53-SEC.13

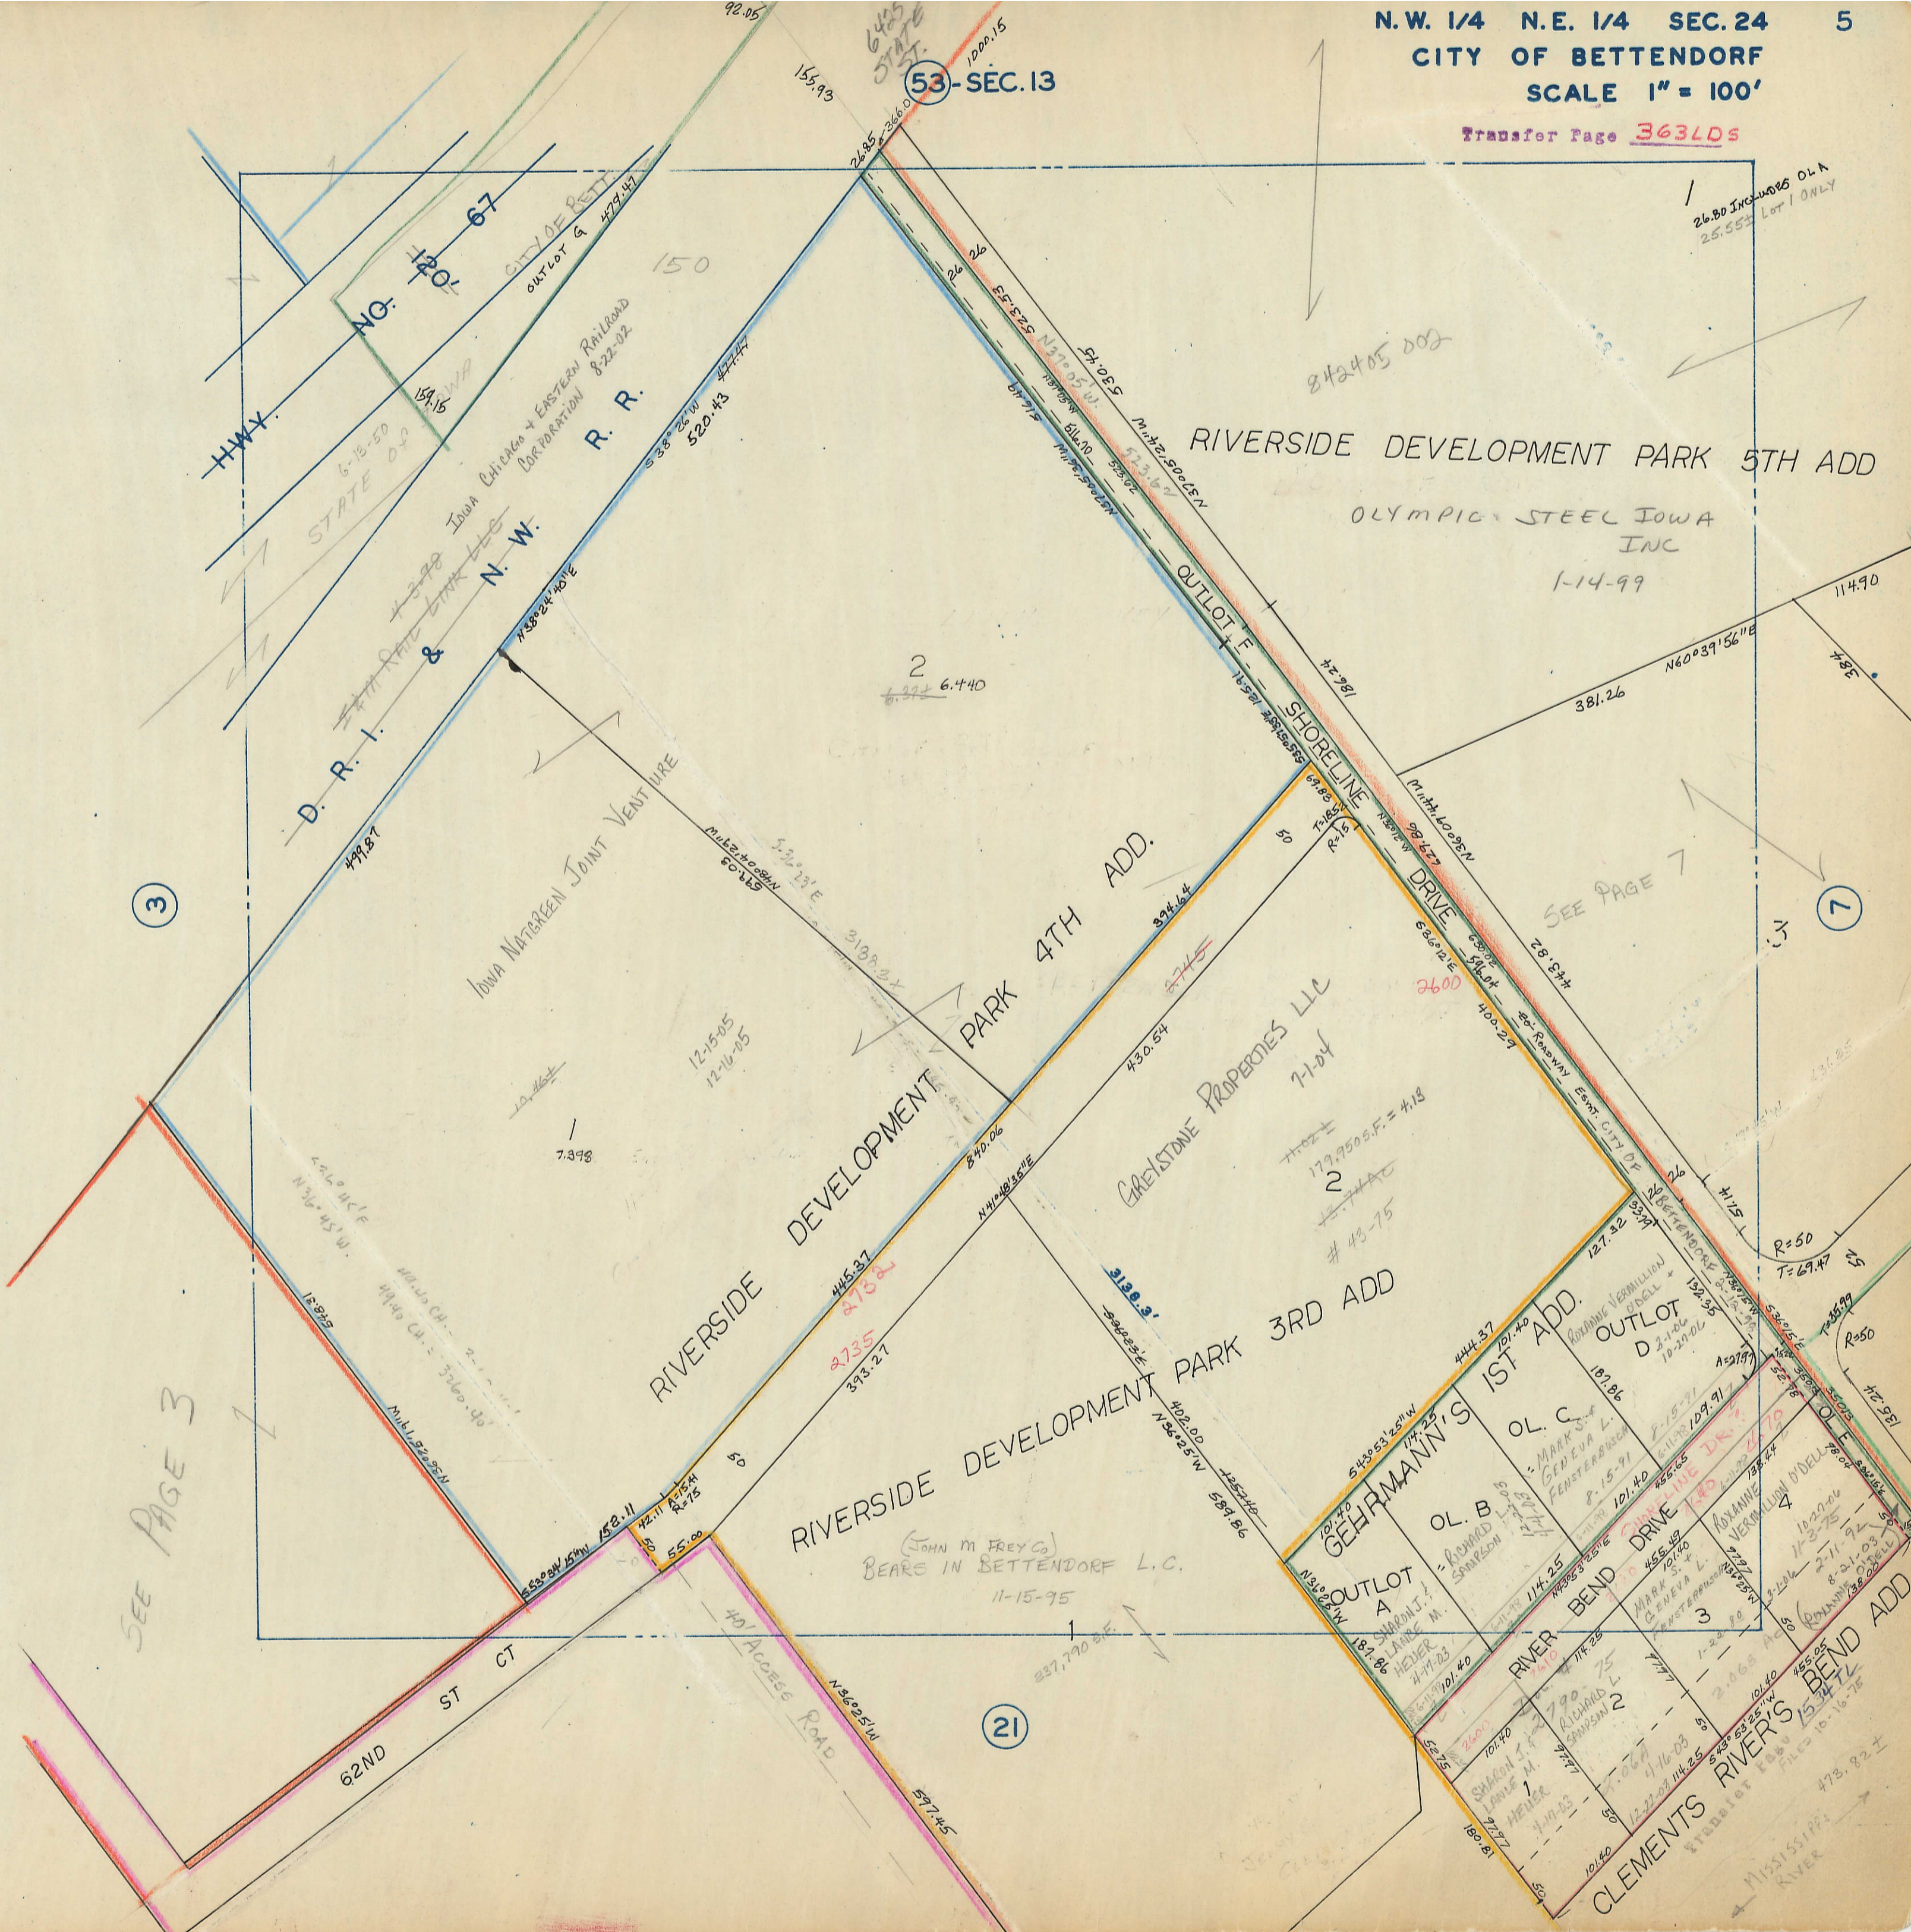

SEE PAGE 3

SEE PAGE 7

26.80 Incls. 0.1 A
25.55 Lot 1 ONLY

842405 002

RIVERSIDE DEVELOPMENT PARK 5TH ADD

OLYMPIC STEEL IOWA INC
1-14-99

PARK 4TH ADD.

GREYSTONE PROPERTIES LLC
7-1-04

PARK 3RD ADD

RIVERSIDE DEVELOPMENT PARK 3RD ADD

(JOHN M FREY CO)
BEARS IN BETTENDORF L.C.
11-15-95

IST ADD.

OL. C

OL. B

OL. A

RIVER BEND DRIVE

CLEMENTS RIVER'S BEND ADD.