

(21)

LOT 2

RIVERSIDE INDUSTRIAL PARK

Transfer Page 142572

(35)

11-8-48
11-6-48

VIEW ACATED


9-5-63

SUBDIVISION

ROAD

MISSISSIPPI

RIVER

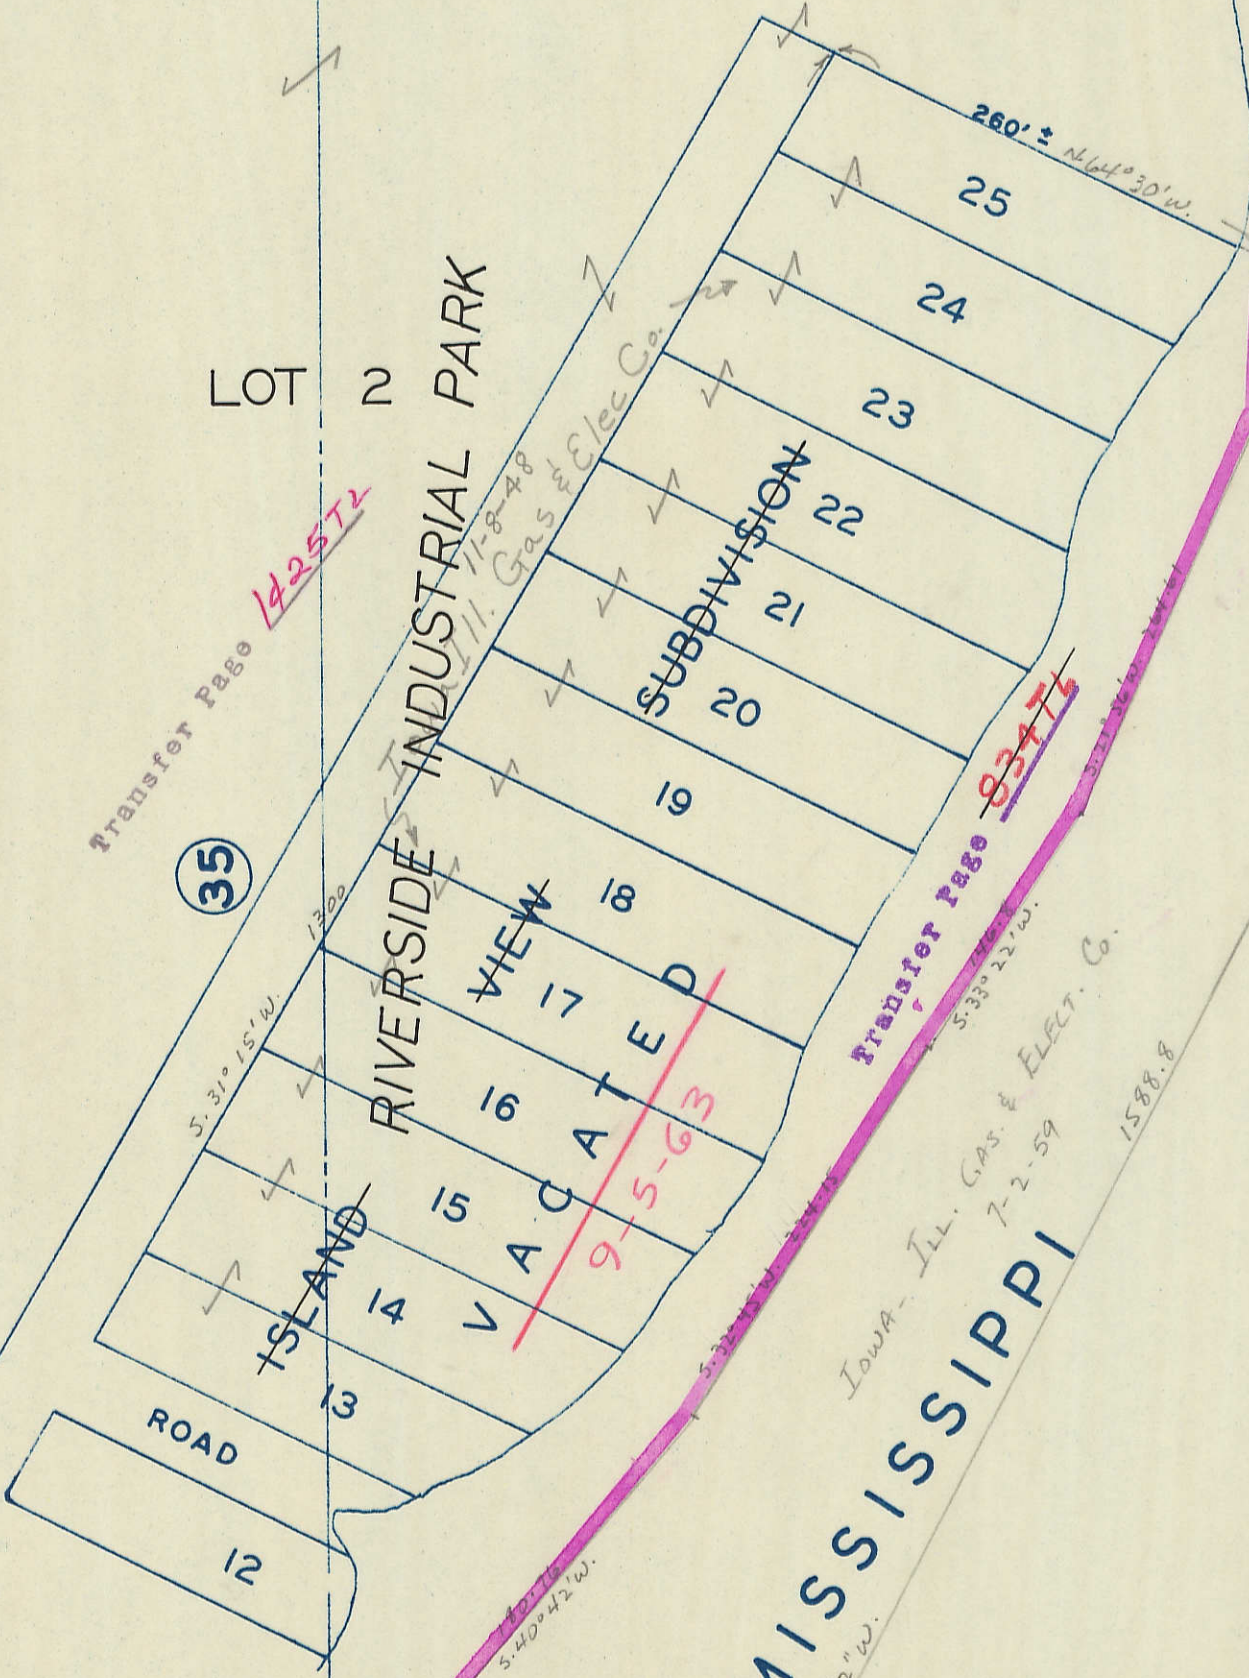

Iowa, Ill. Gas & Elect. Co.
7-2-59

Transfer Page 83476

280' ± N 64° 30' W





3/10