


Transfer Page 358LDS.

(37)

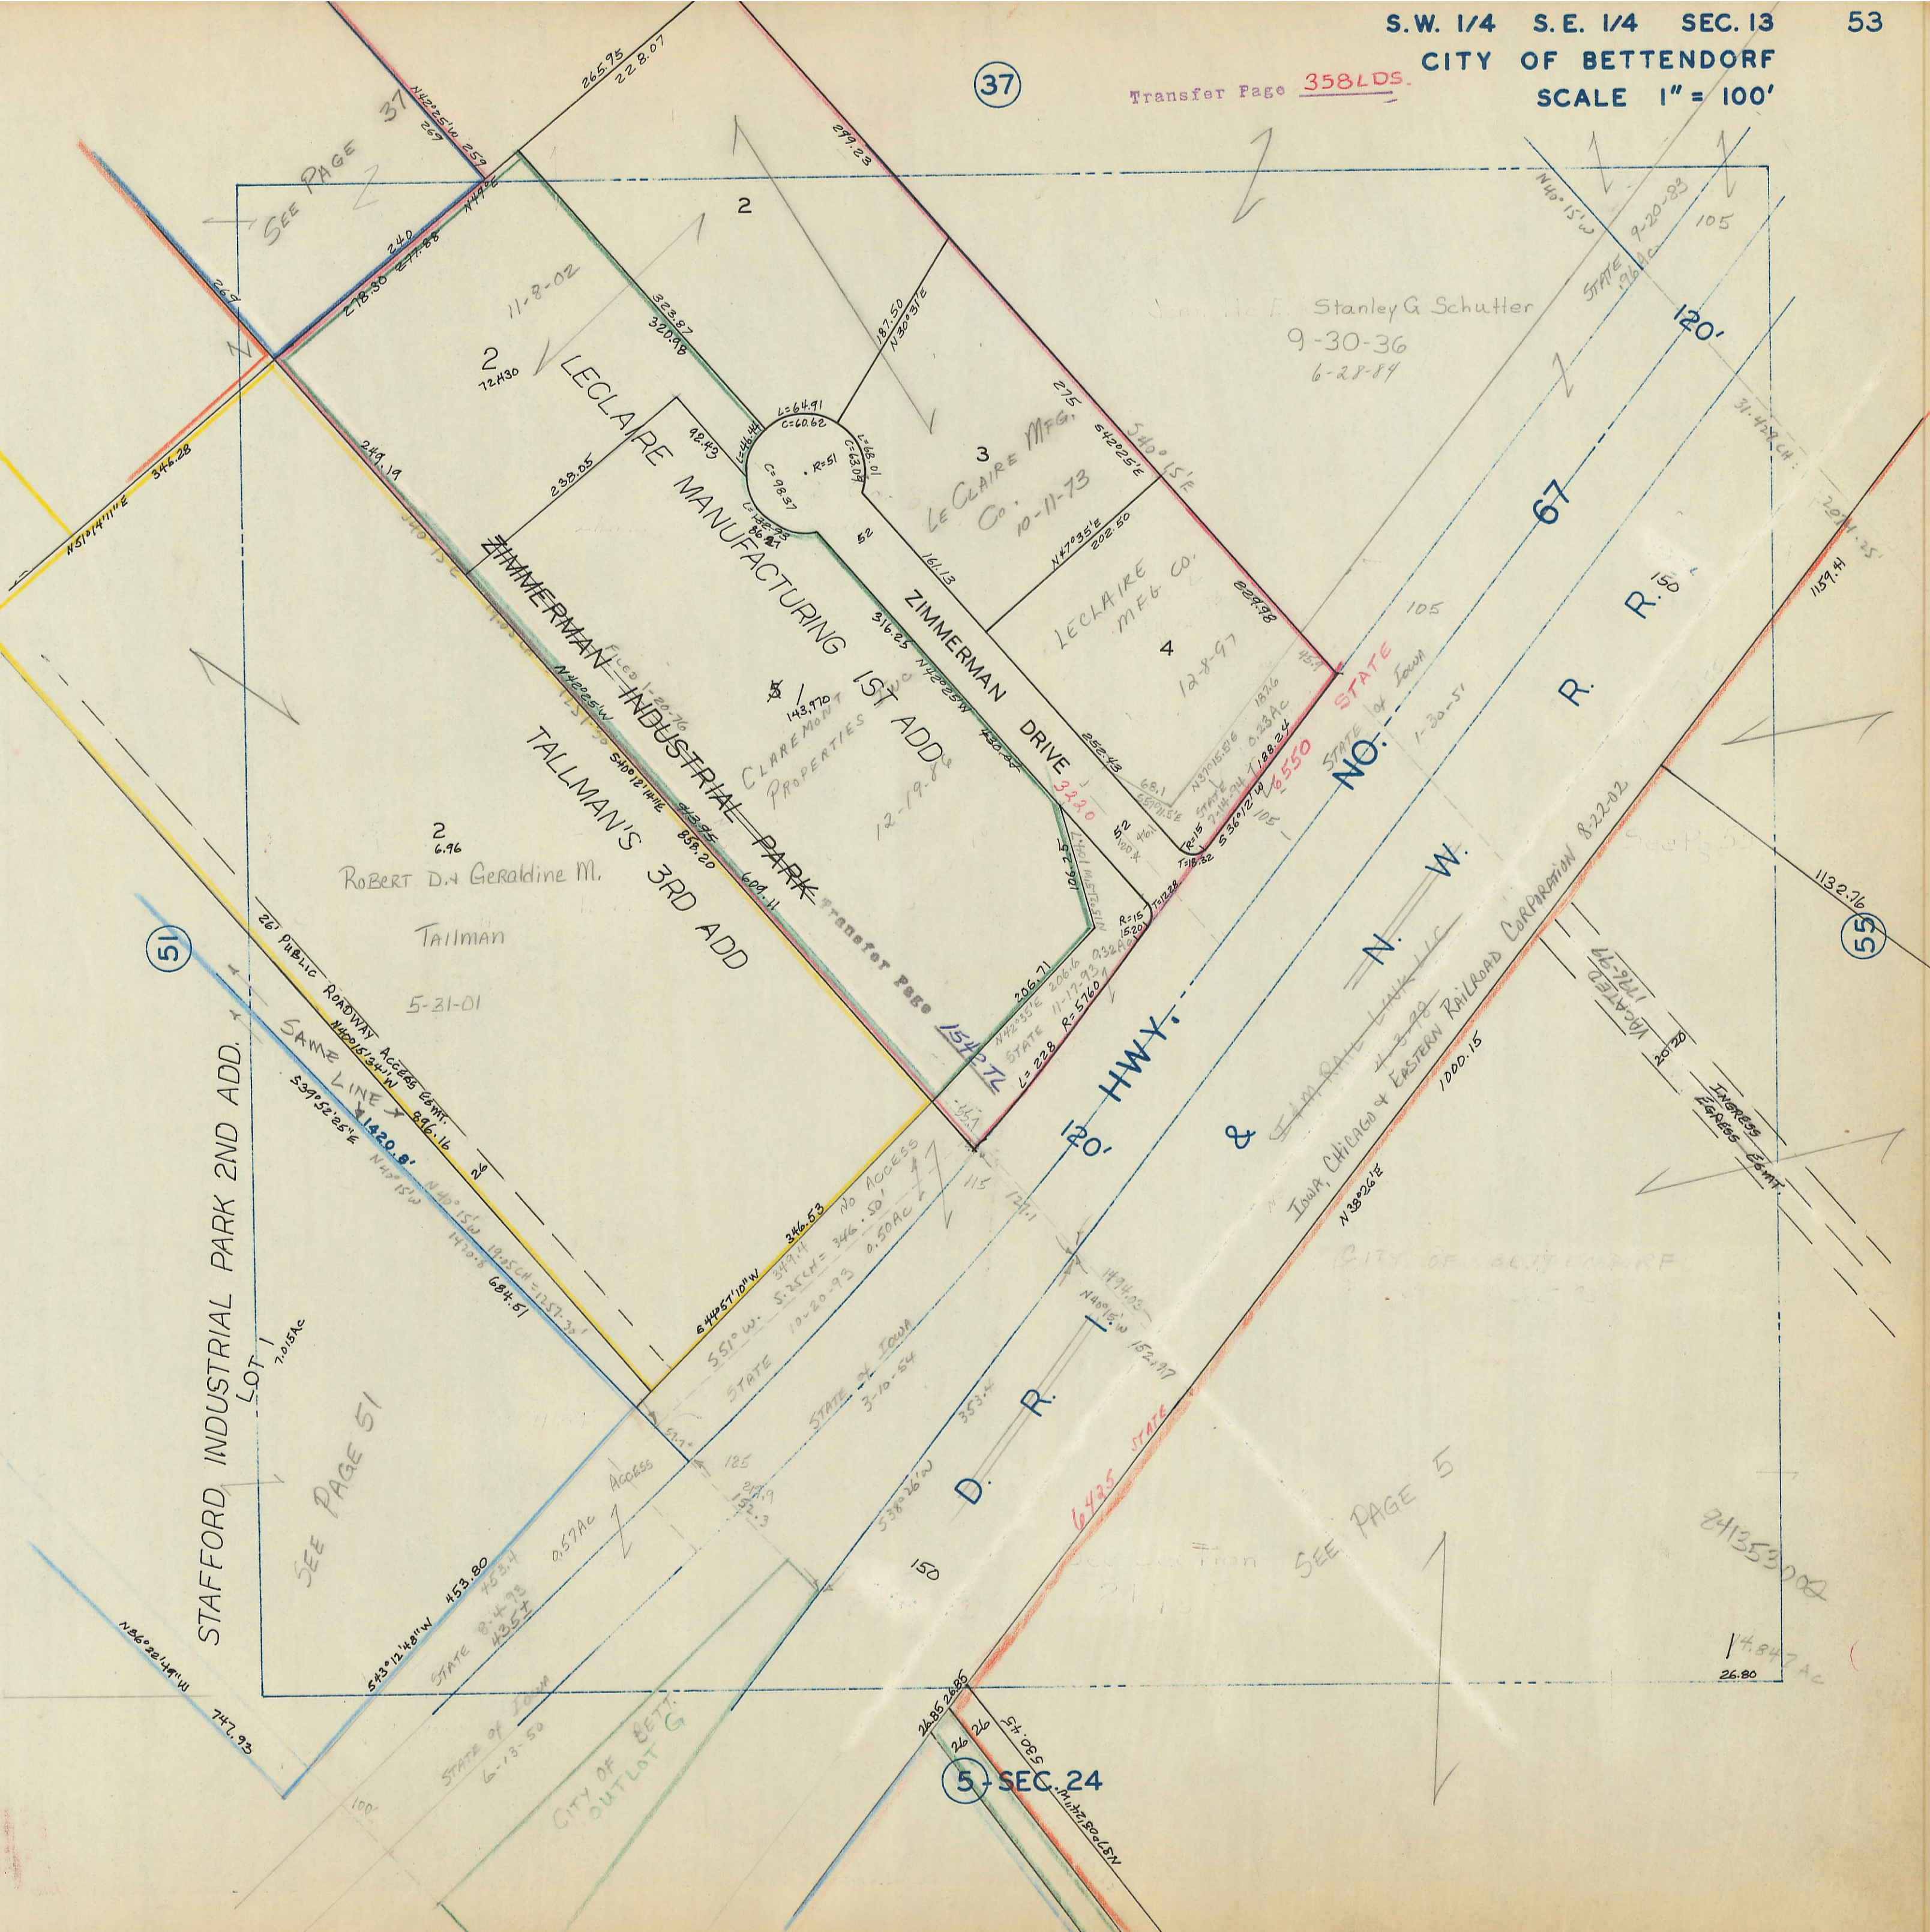

(51)

(55)

(5) SEC 24

STAFFORD INDUSTRIAL PARK 2ND ADD.


CITY OF BETTENDORF
OUTLOT G

SEE PAGE 51

SEE PAGE 5

SEE PAGE 37

LECLAIRE MANUFACTURING

ZIMMERMAN INDUSTRIAL PARK

TALLMAN'S 3RD ADD

ZIMMERMAN DRIVE

LECLAIRE MFG. CO.

LECLAIRE MFG. CO.

CLARE MOUNT PROPERTIES

STATE OF IOWA

























































ROBERT D. & Geraldine M. Tallman
5-21-01

Stanley G. Schutter
9-30-36
6-28-19

241353002

14.847 Ac

26.80

204.25

1157.41

1132.76

1132.76

