



SW 1/4, NW 1/4 SEC. 27-78-4
SCALE: 1" = 100'

SEE PAGE 015


DRUEHL'S ACRE LOTS

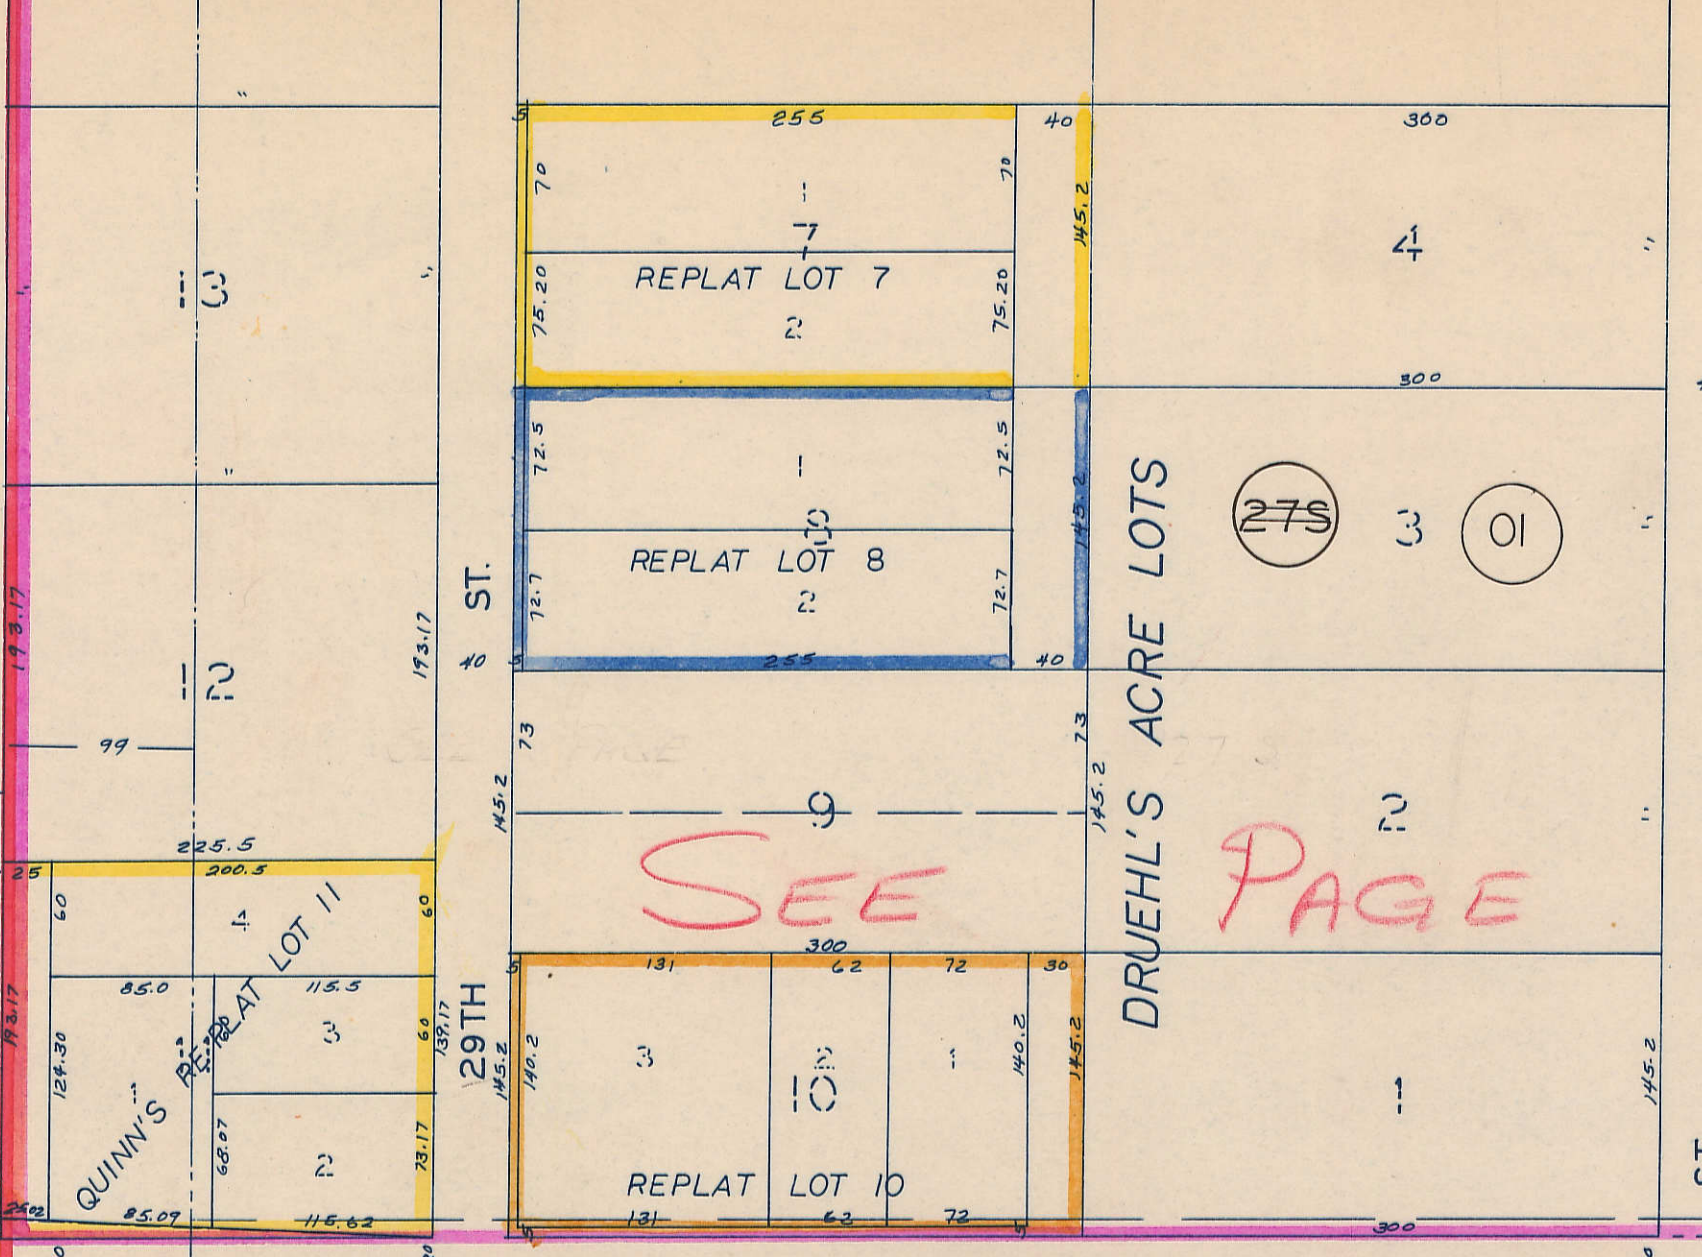


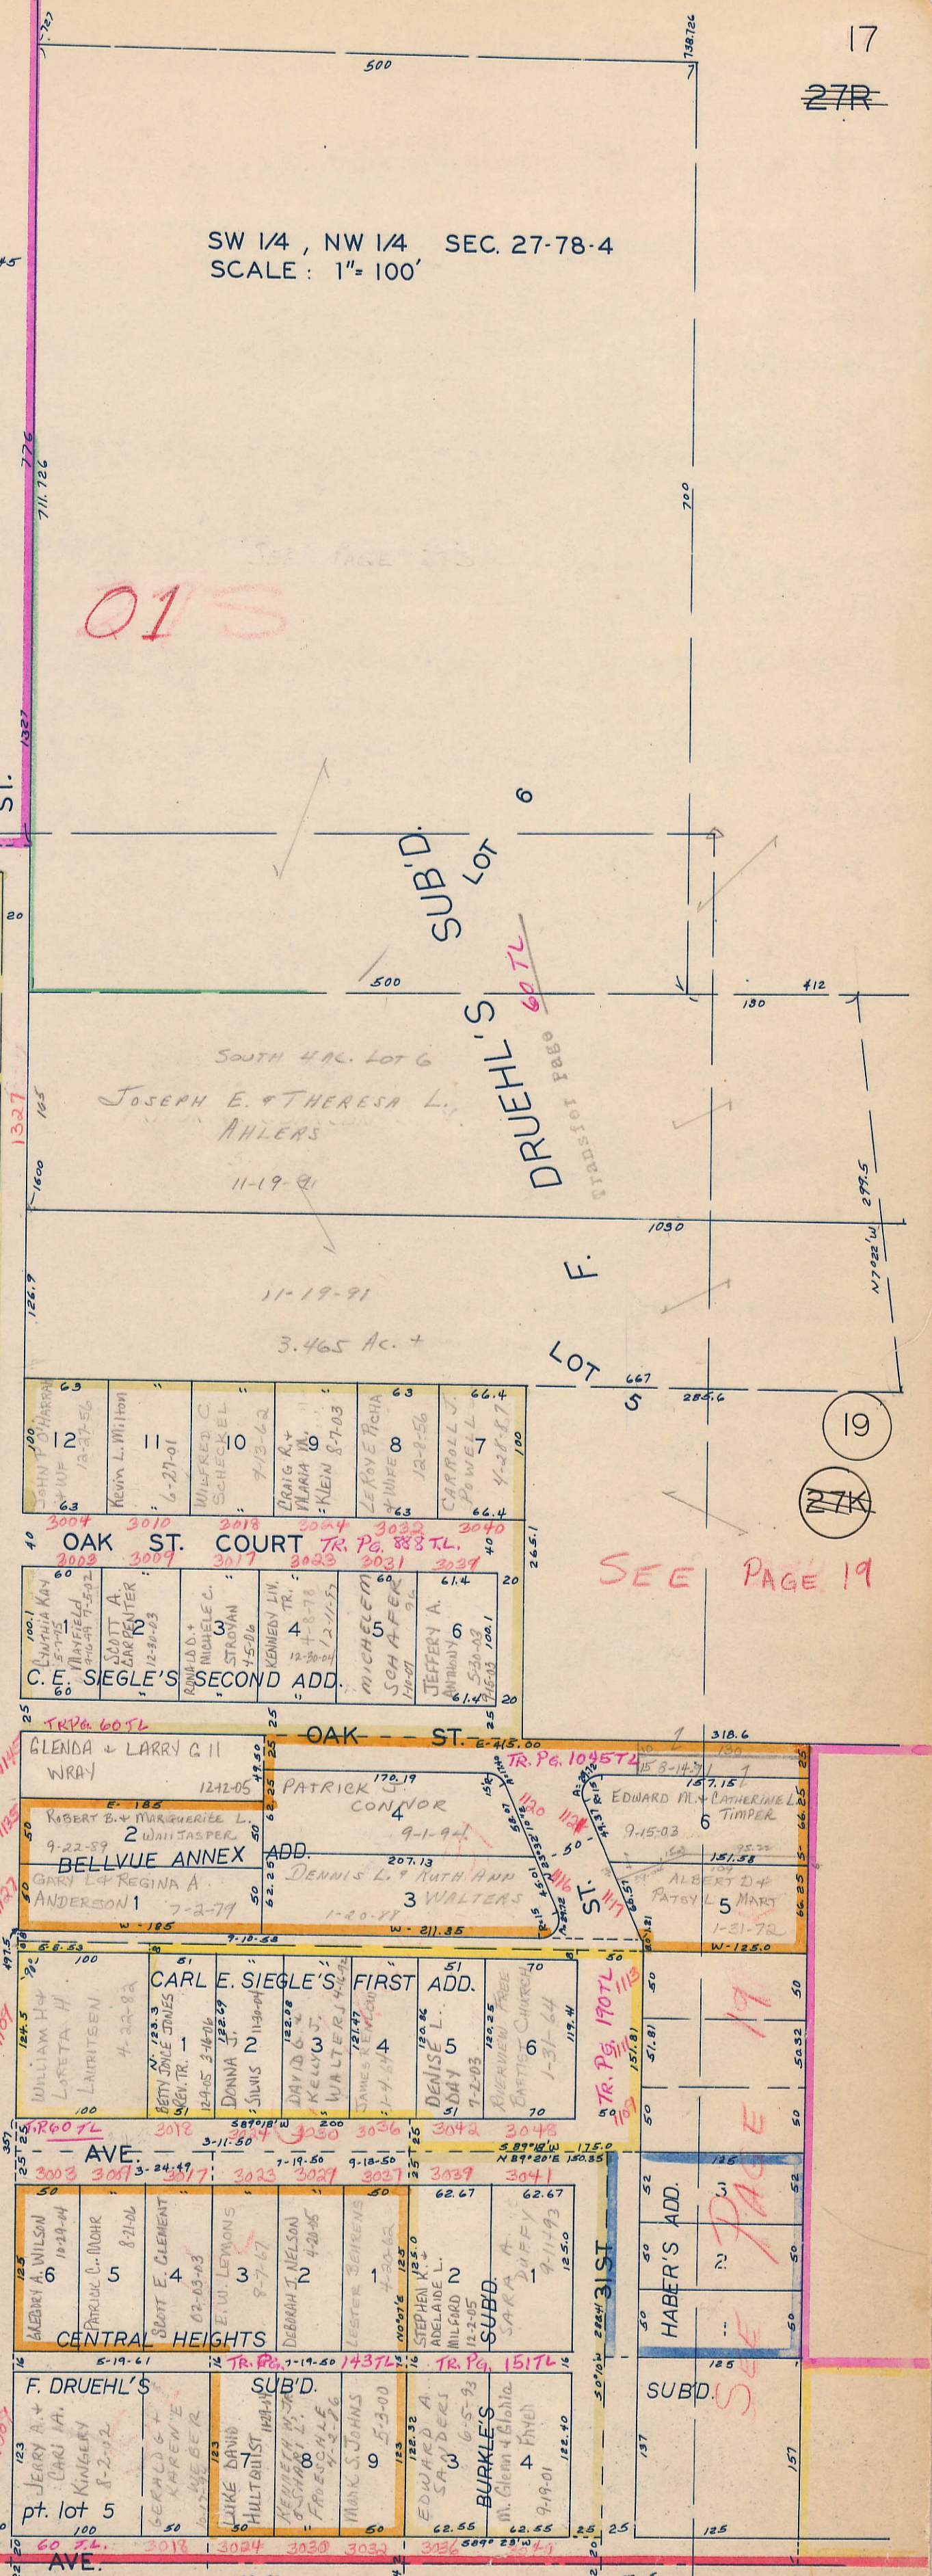


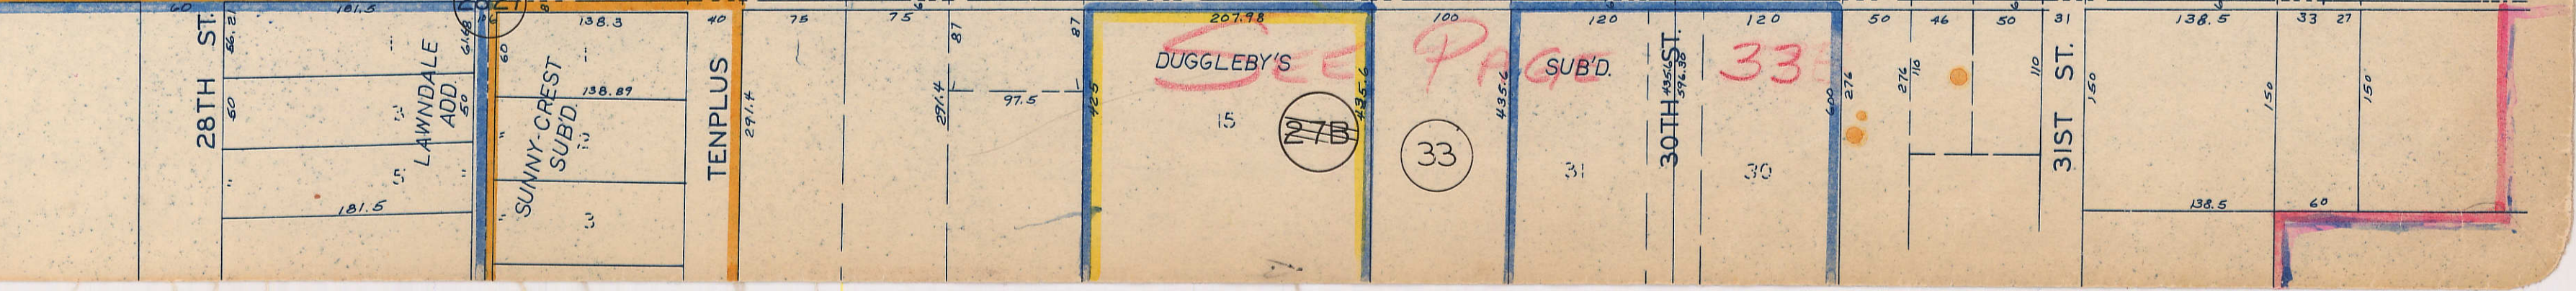



