


Transfer Page 366 LD

SW 1/4, SE 1/4, SEC. 27-78-4  
SCALE: 1" = 100'

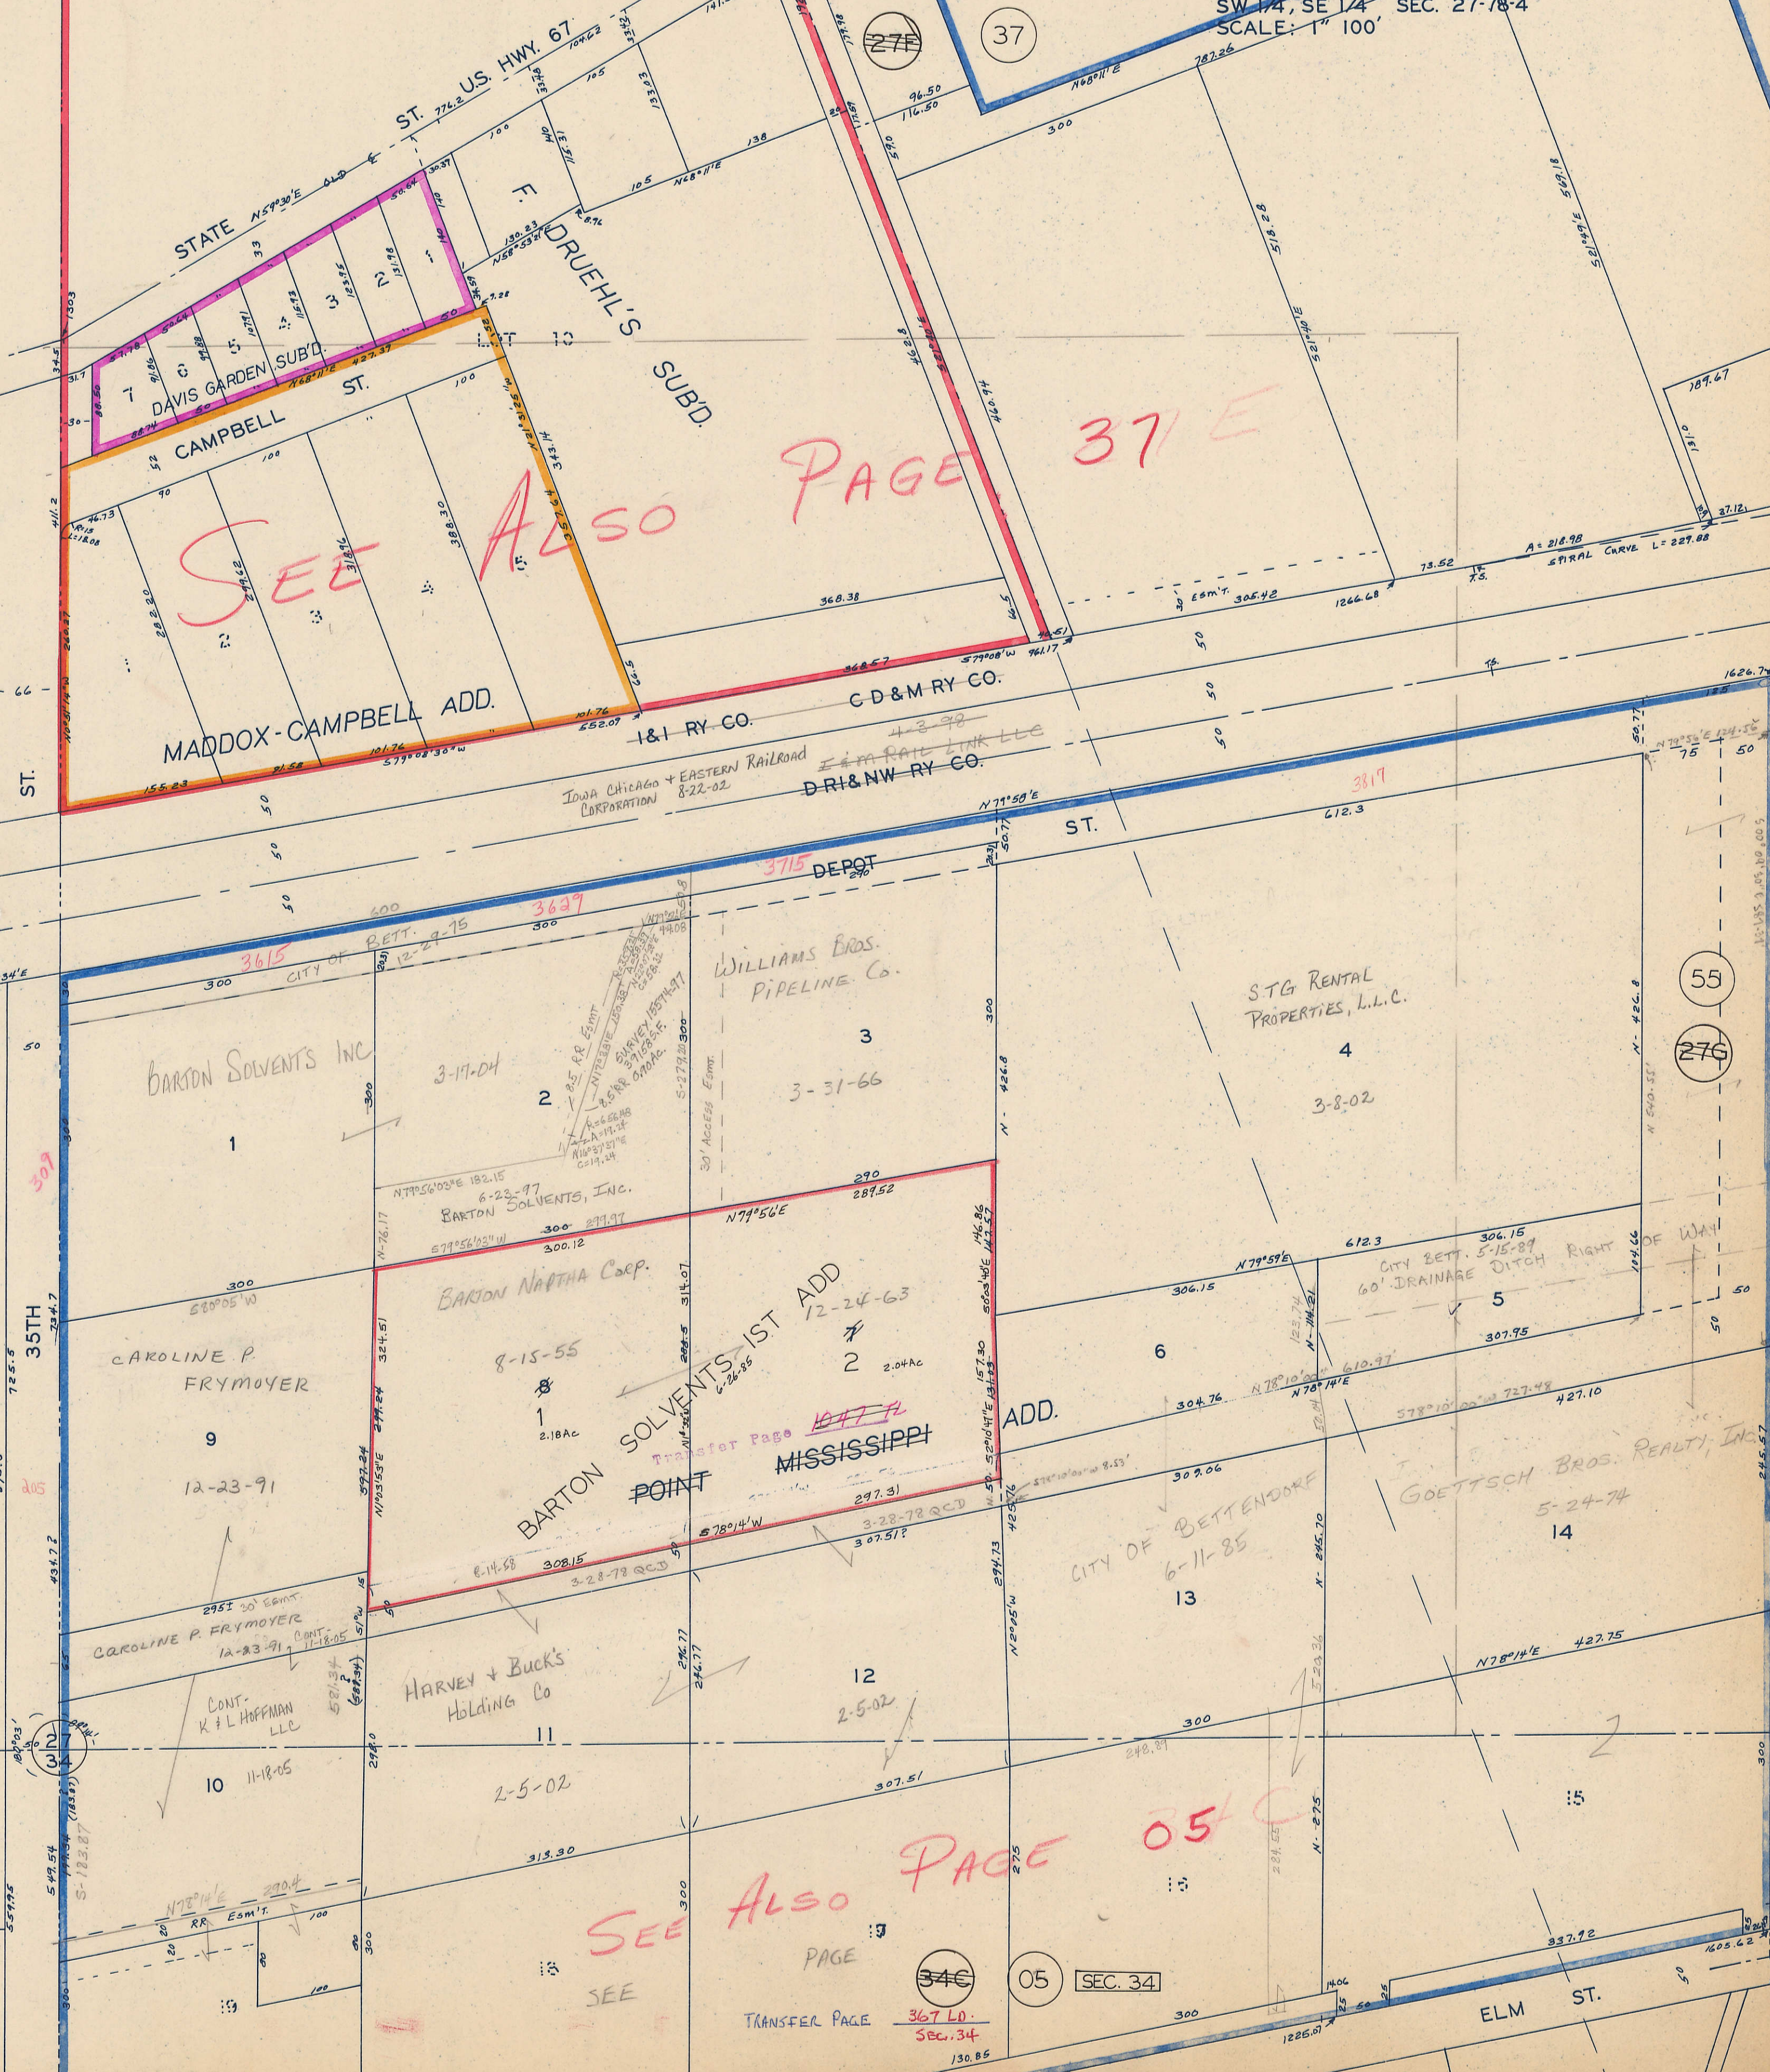

SEE ALSO PAGE 37 E

3715 DEPOT

BARTON SOLVENTS INC

WILLIAMS BROS. PIPELINE CO.

STG RENTAL PROPERTIES, L.L.C.

CAROLINE P. FRYMOYER

BARTON NATHA CORP.

BARTON SOLVENTS 1ST ADD  
MISSISSIPPI POINT

CITY OF BETTENDORF

GOETTSCH BROS. REALTY, INC.

HARVEY + BUCK'S HOLDING CO

SEE ALSO PAGE 05 C

TRANSFER PAGE 367 LD. SEC. 34

51

27C

35TH

32

34C

05

SEC. 34

55

27G

15

14

13

12

11

10

9

8

7

6

5

4

3

2

1