



BLANK LOTS: 10-9-74
CENTURY OAKS, LTD.

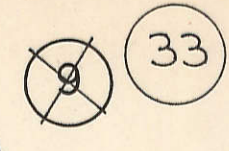

SEC. 12-78-4

SCALE: 1"=100'

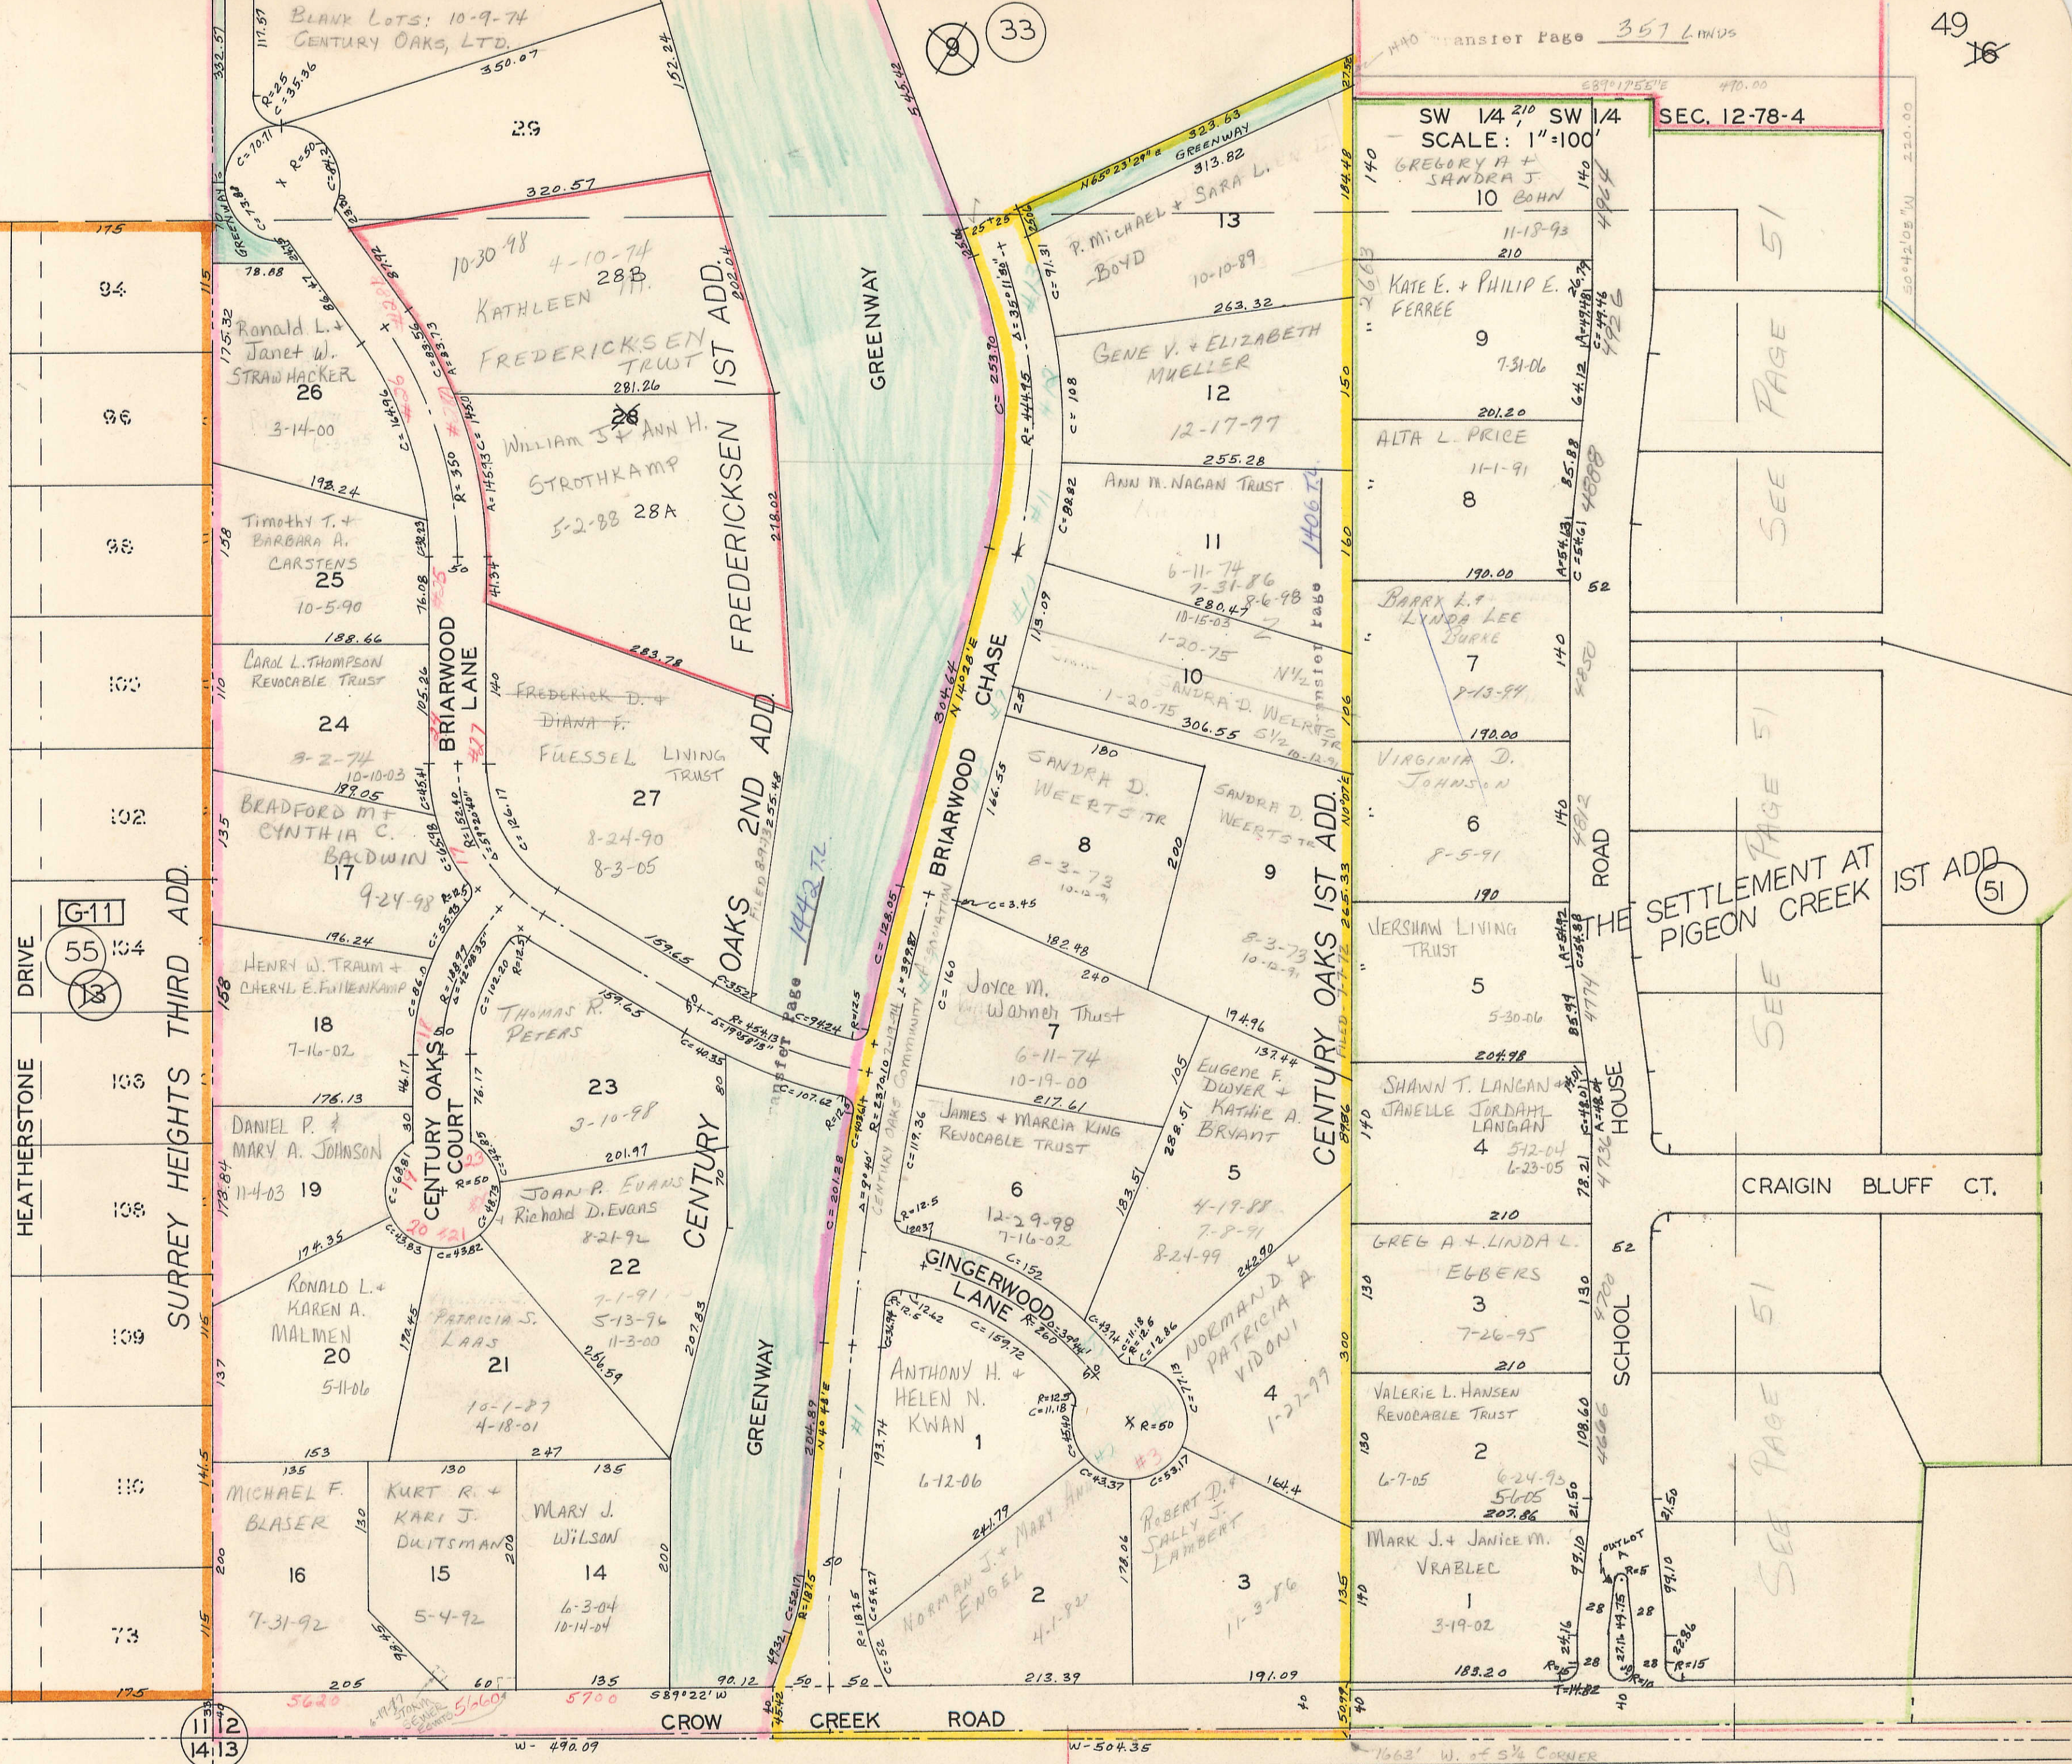

PAGE 51

SEE PAGE 51

PAGE 51

SEE PAGE 51

SEE PAGE 51

SEE PAGE 51

SEE PAGE 51

THE SETTLEMENT AT
PIGEON CREEK IST ADD (51)

CRAIGIN BLUFF CT.

G-11
55
18

E-13

1

11
12
14
13


w-490.09

w-504.35

7662' W. of 5/4 CORNER