


30 SEC.-30
BLUEGRASS TWP.

Transfer Page 62

CORPORATE LIMITS 1330.2 LINE

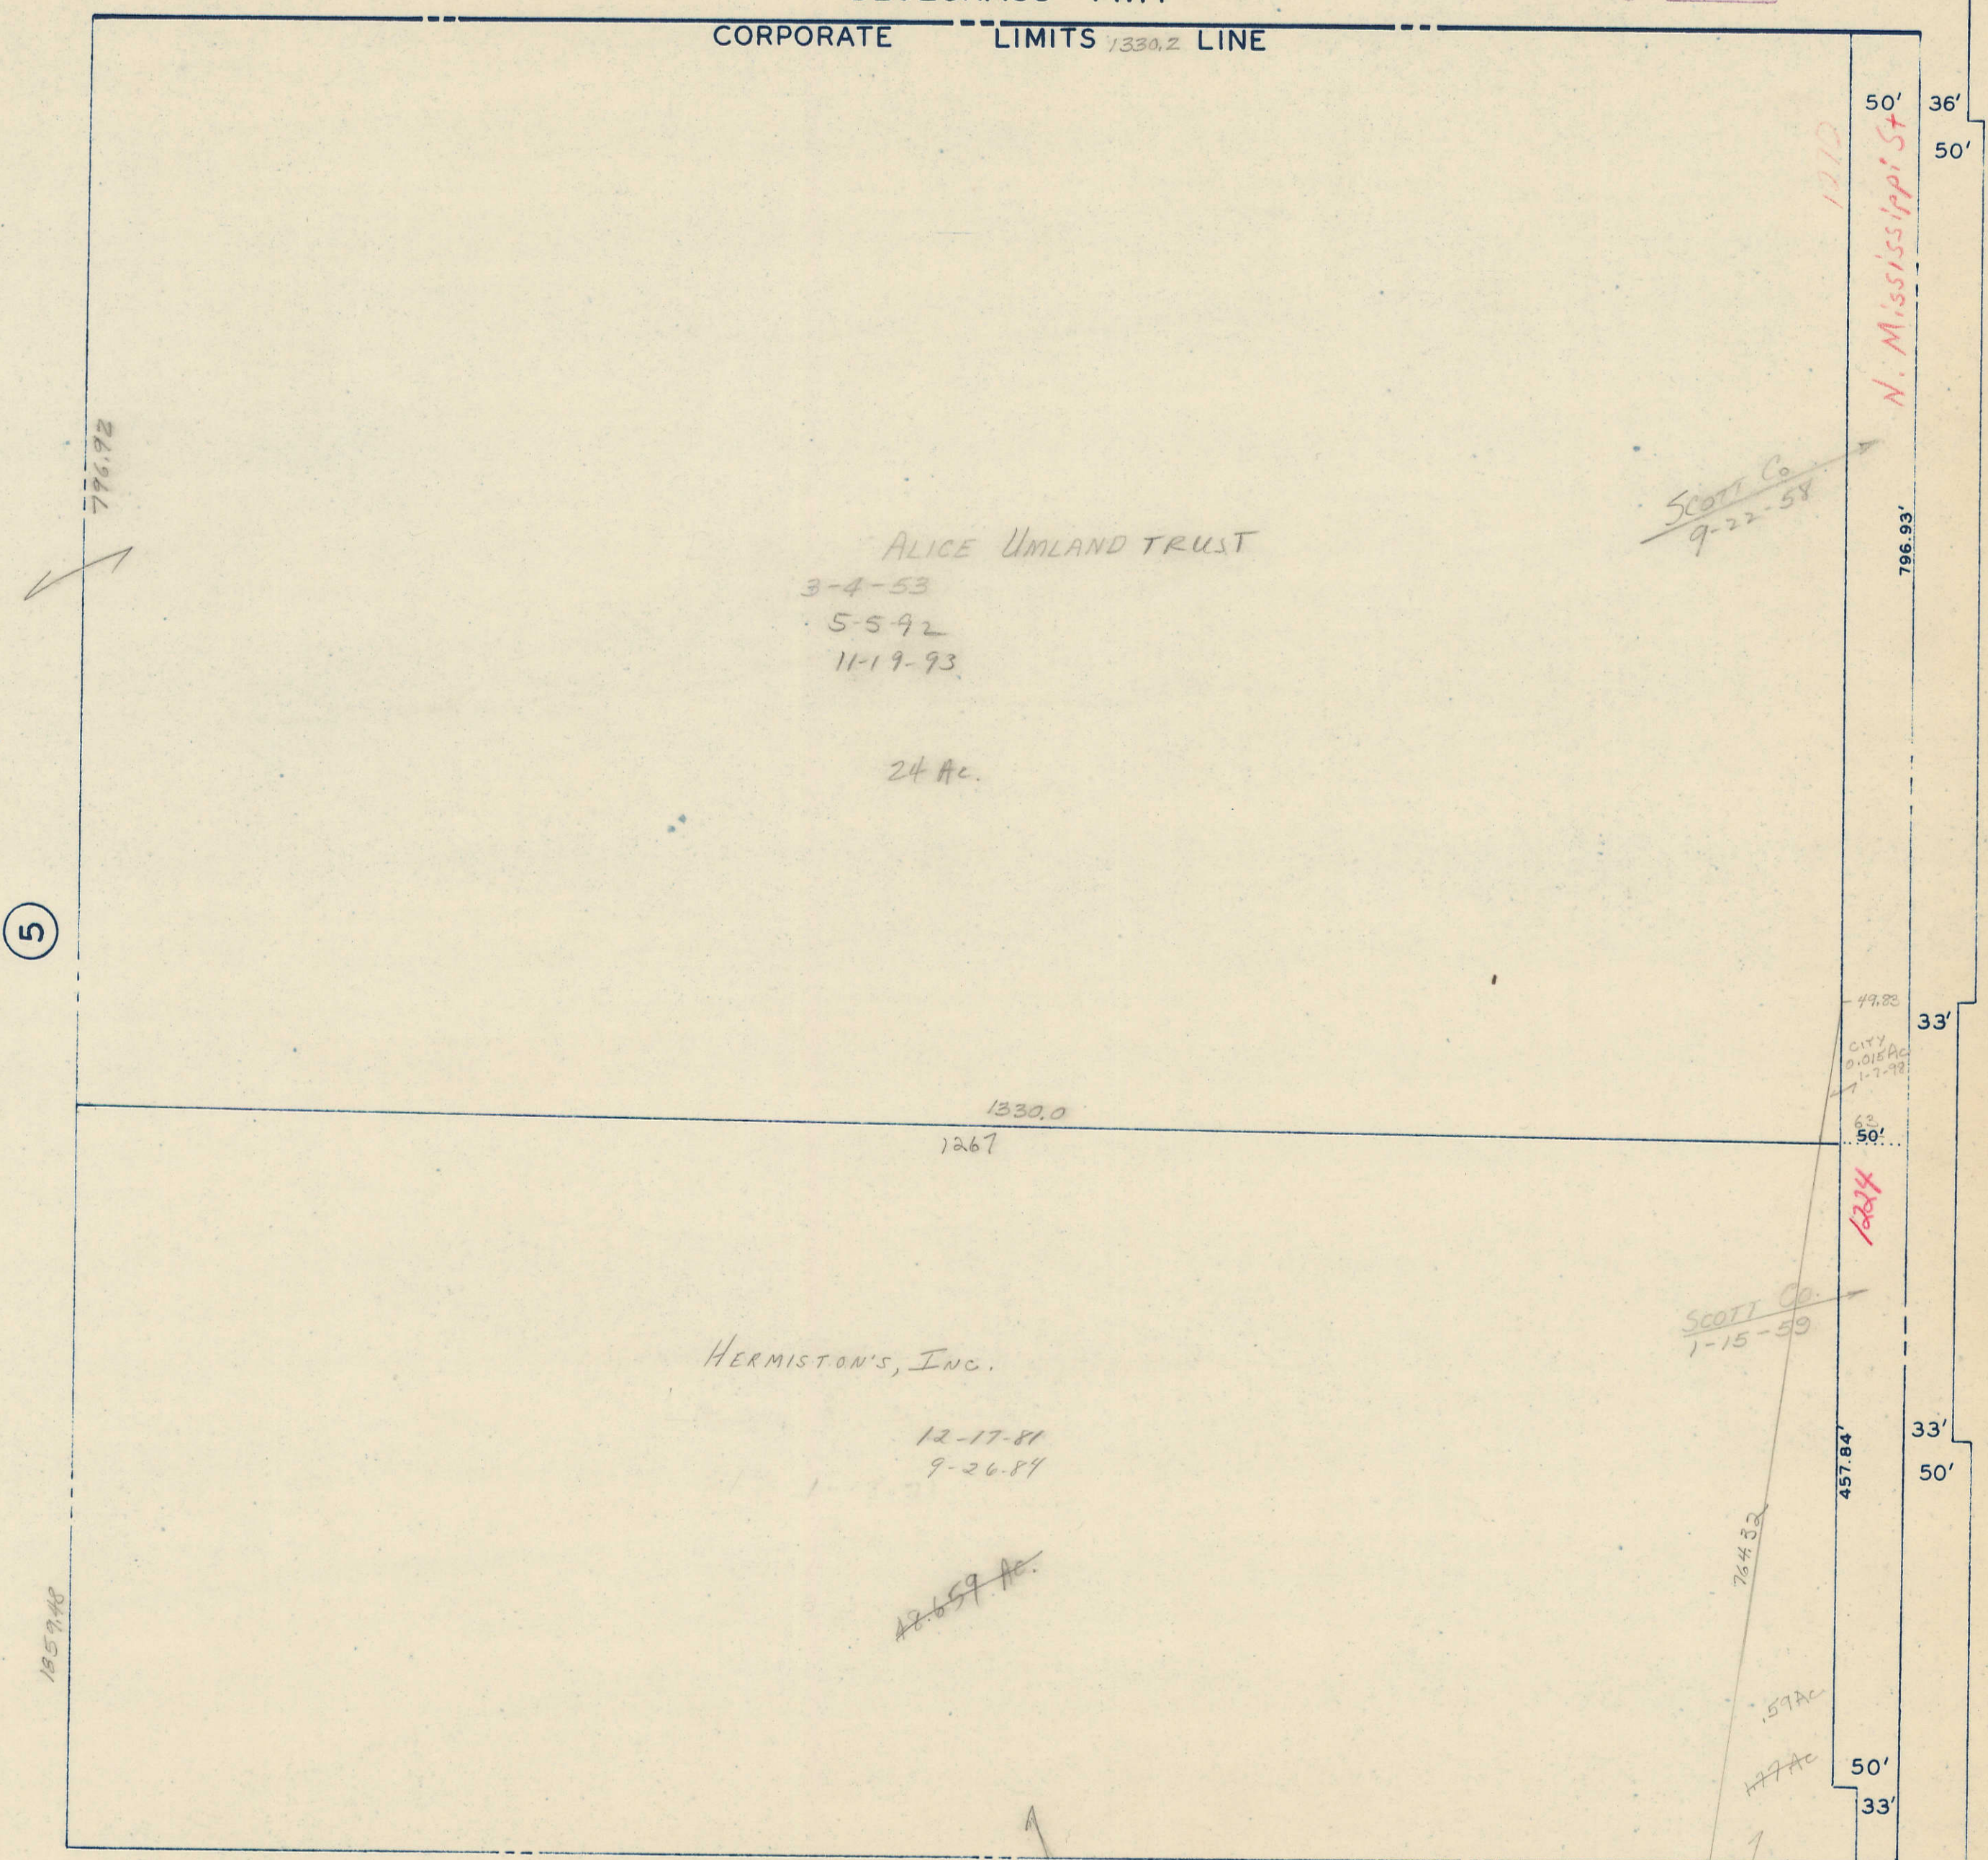

5

23

1 SEC.-32