


(30) SEC - 30

CORPORATE BLUEGRASS TWP. LIMITS LINE

Transfer Page 62

(31) SEC.-31
BLUEGRASS TWP.

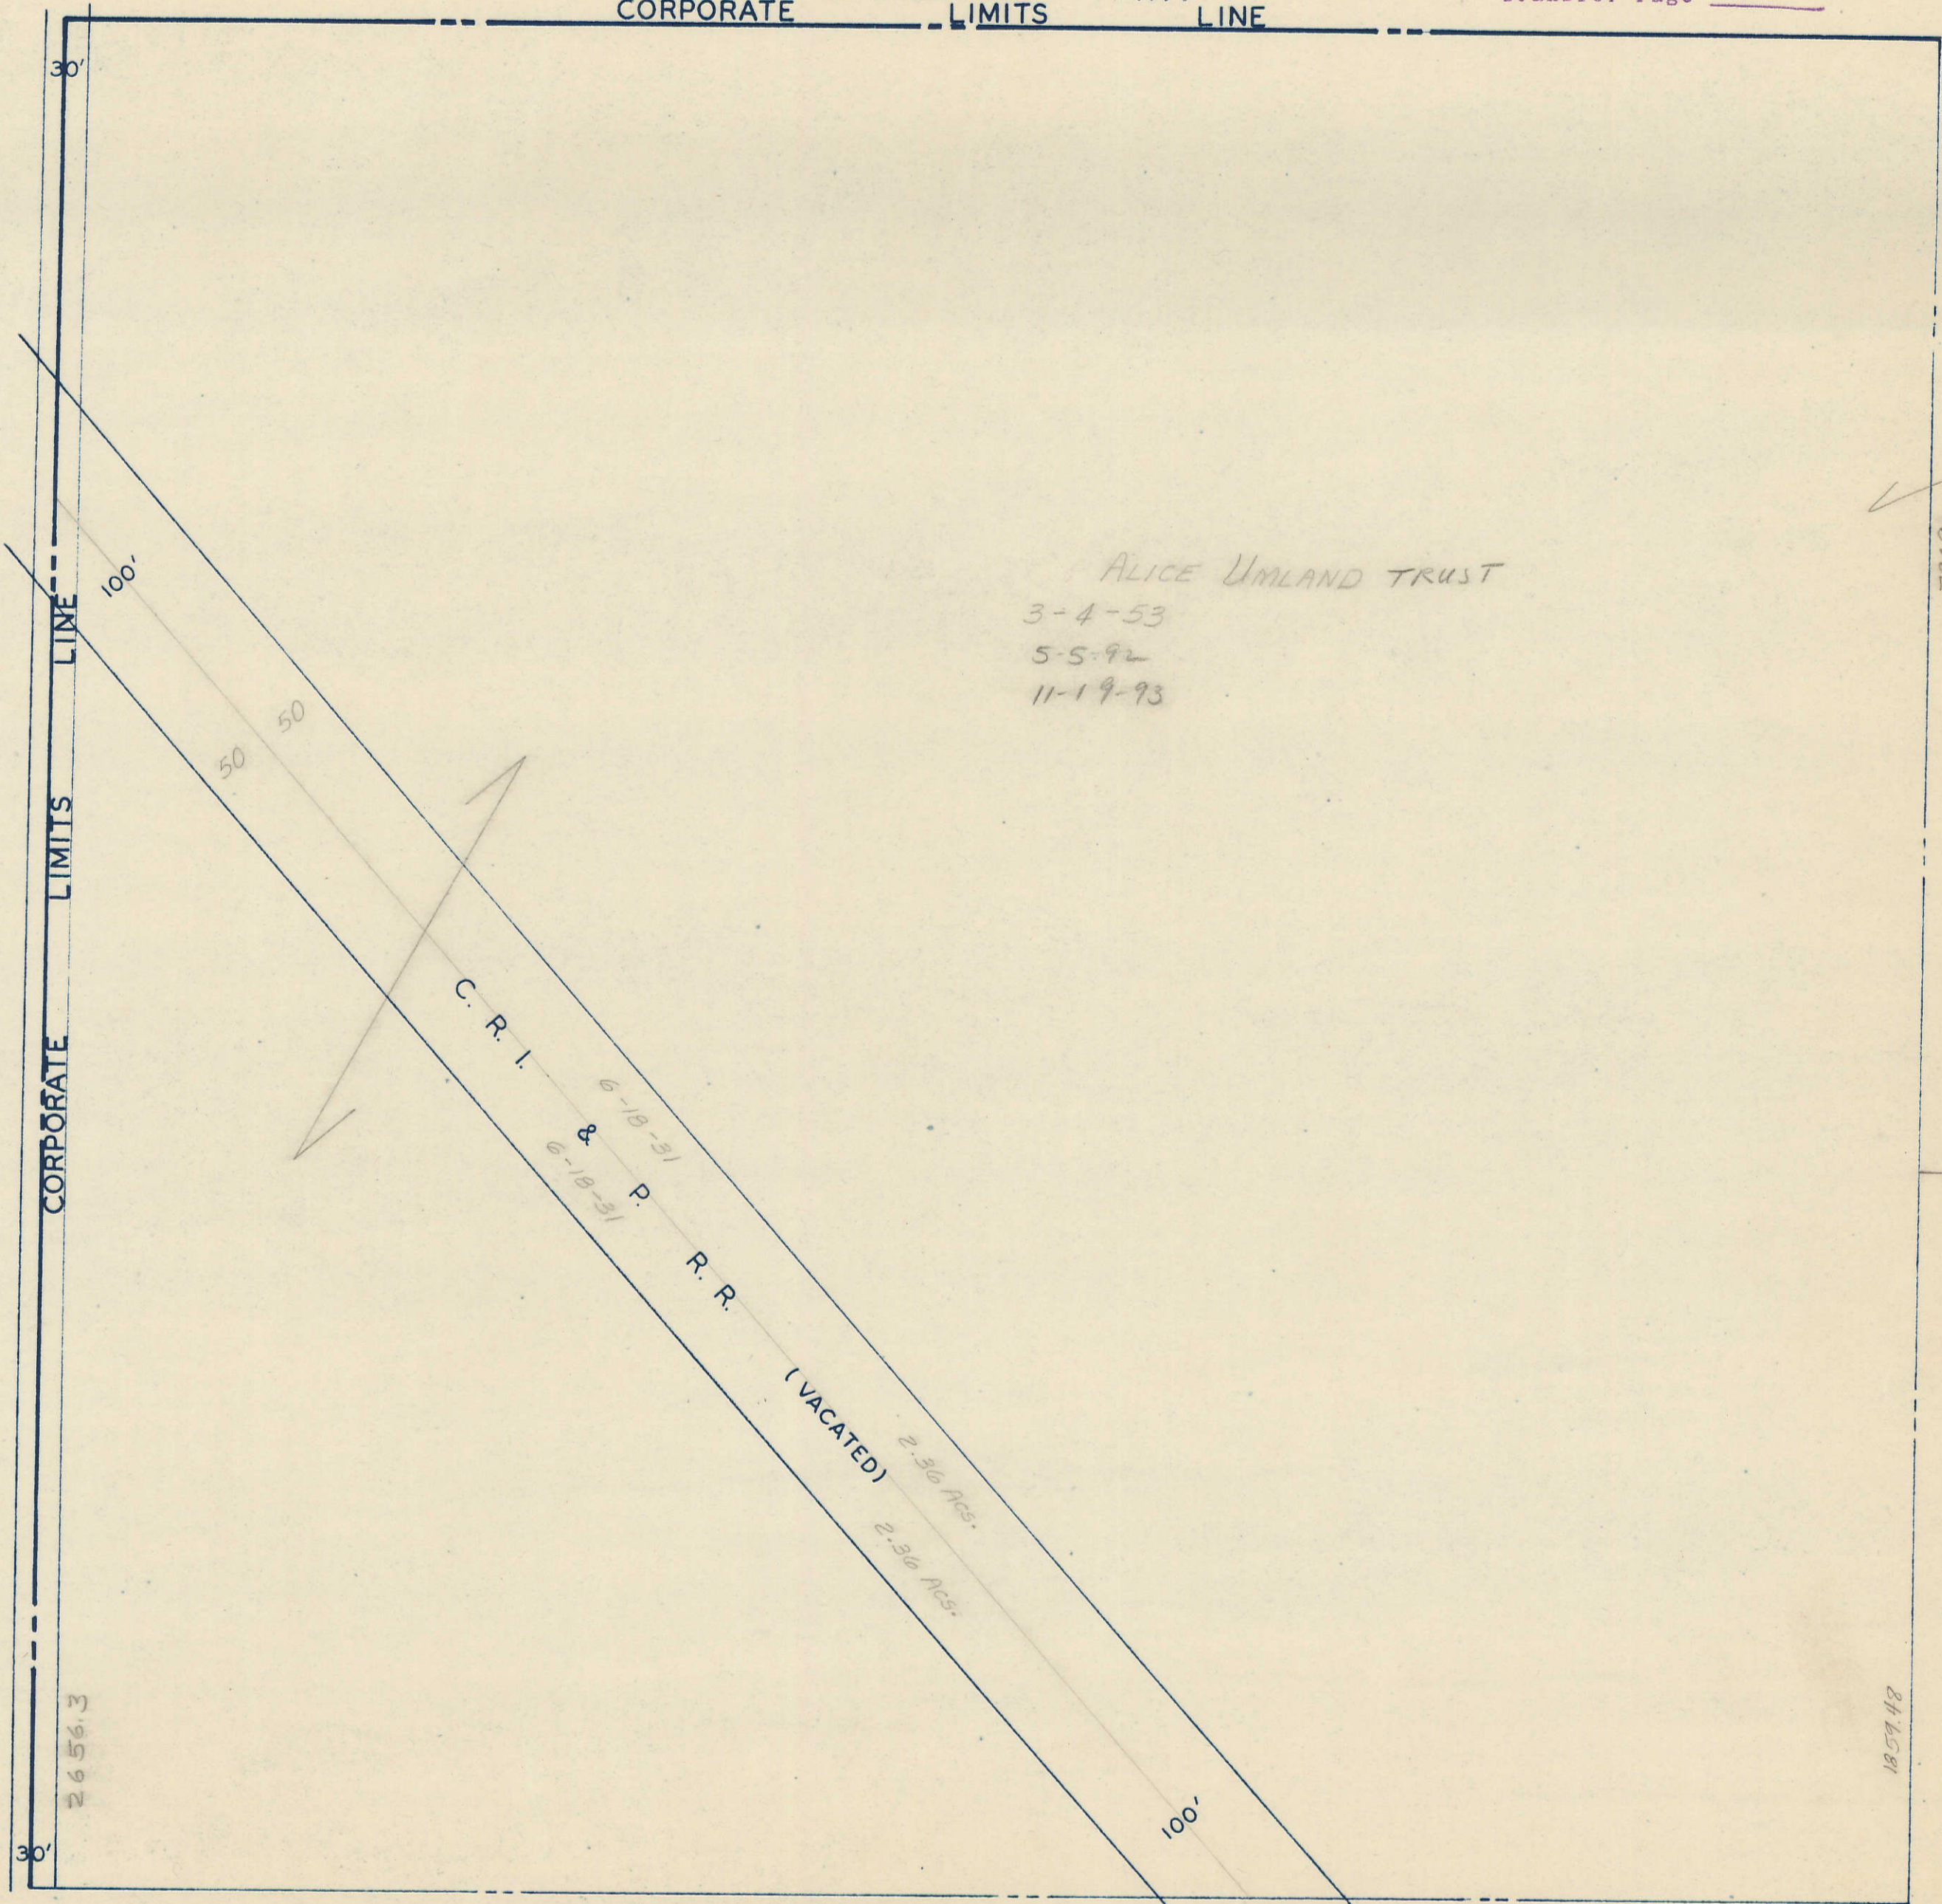

ALICE UMLAND TRUST
3-4-53
5-5-92
11-19-93

(21)

Sec 31-78-2