


10

9

Transfer Page 74

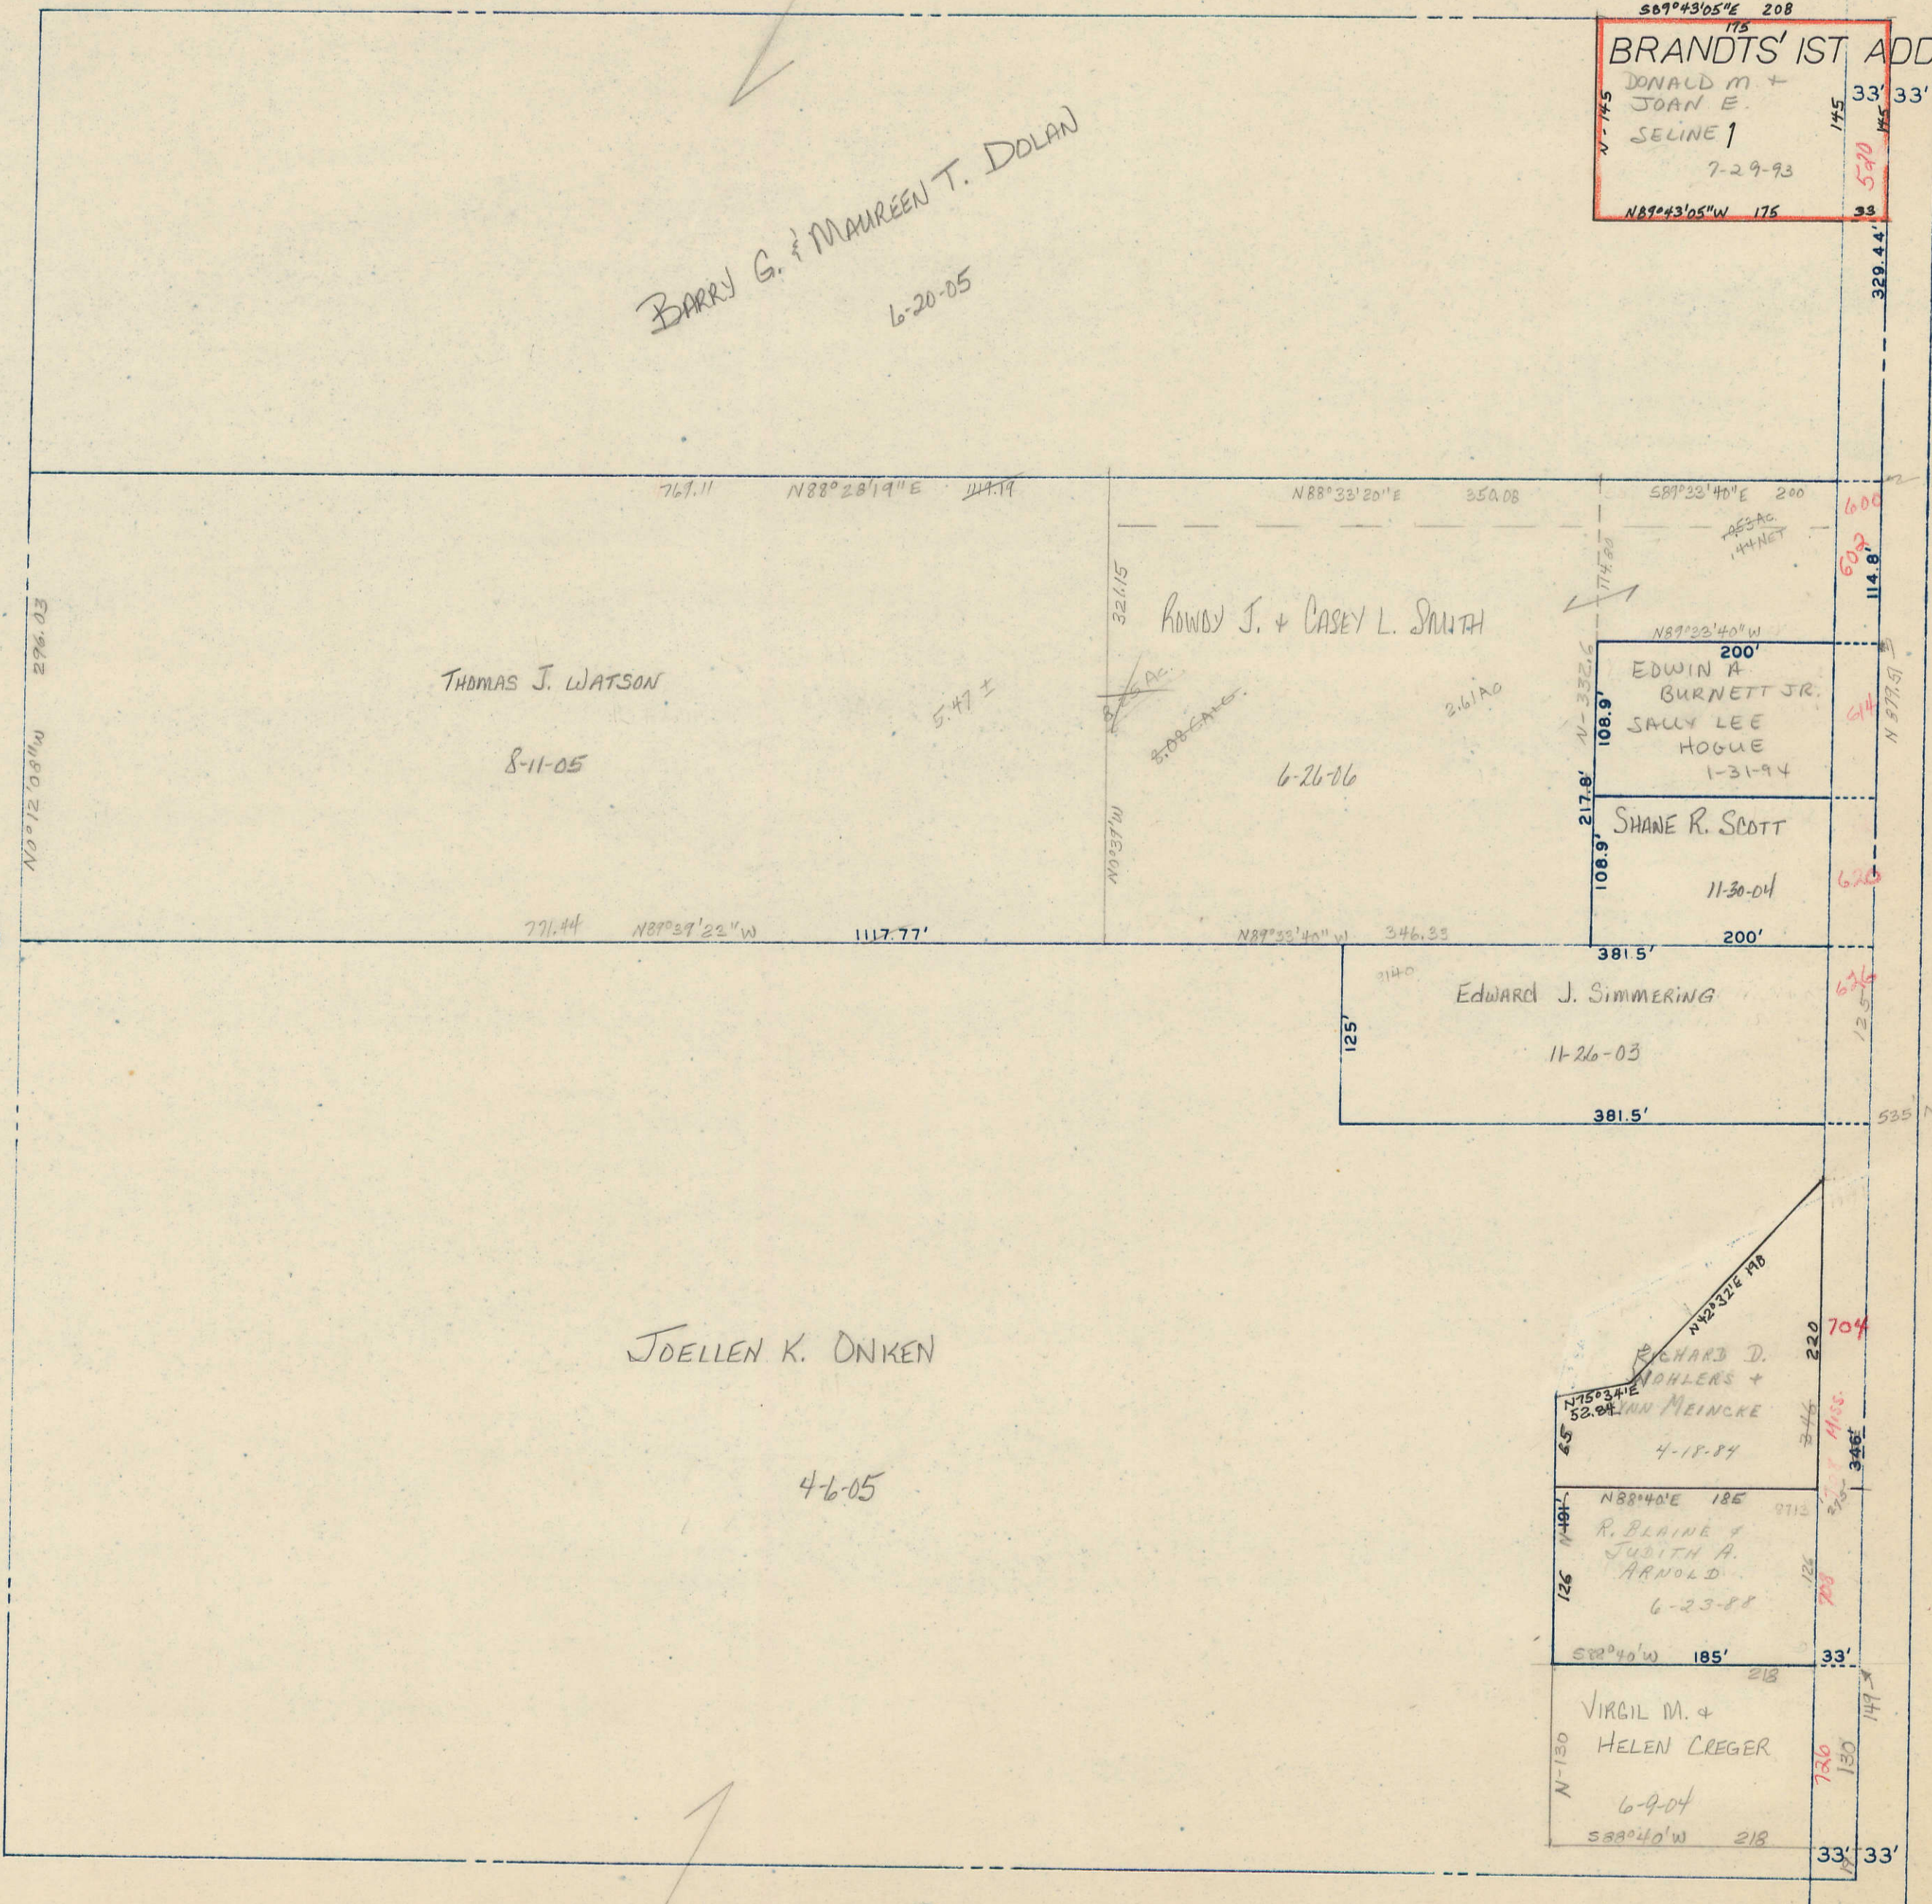

17 SEC.-5

39