


Transfer Page 73

(39)

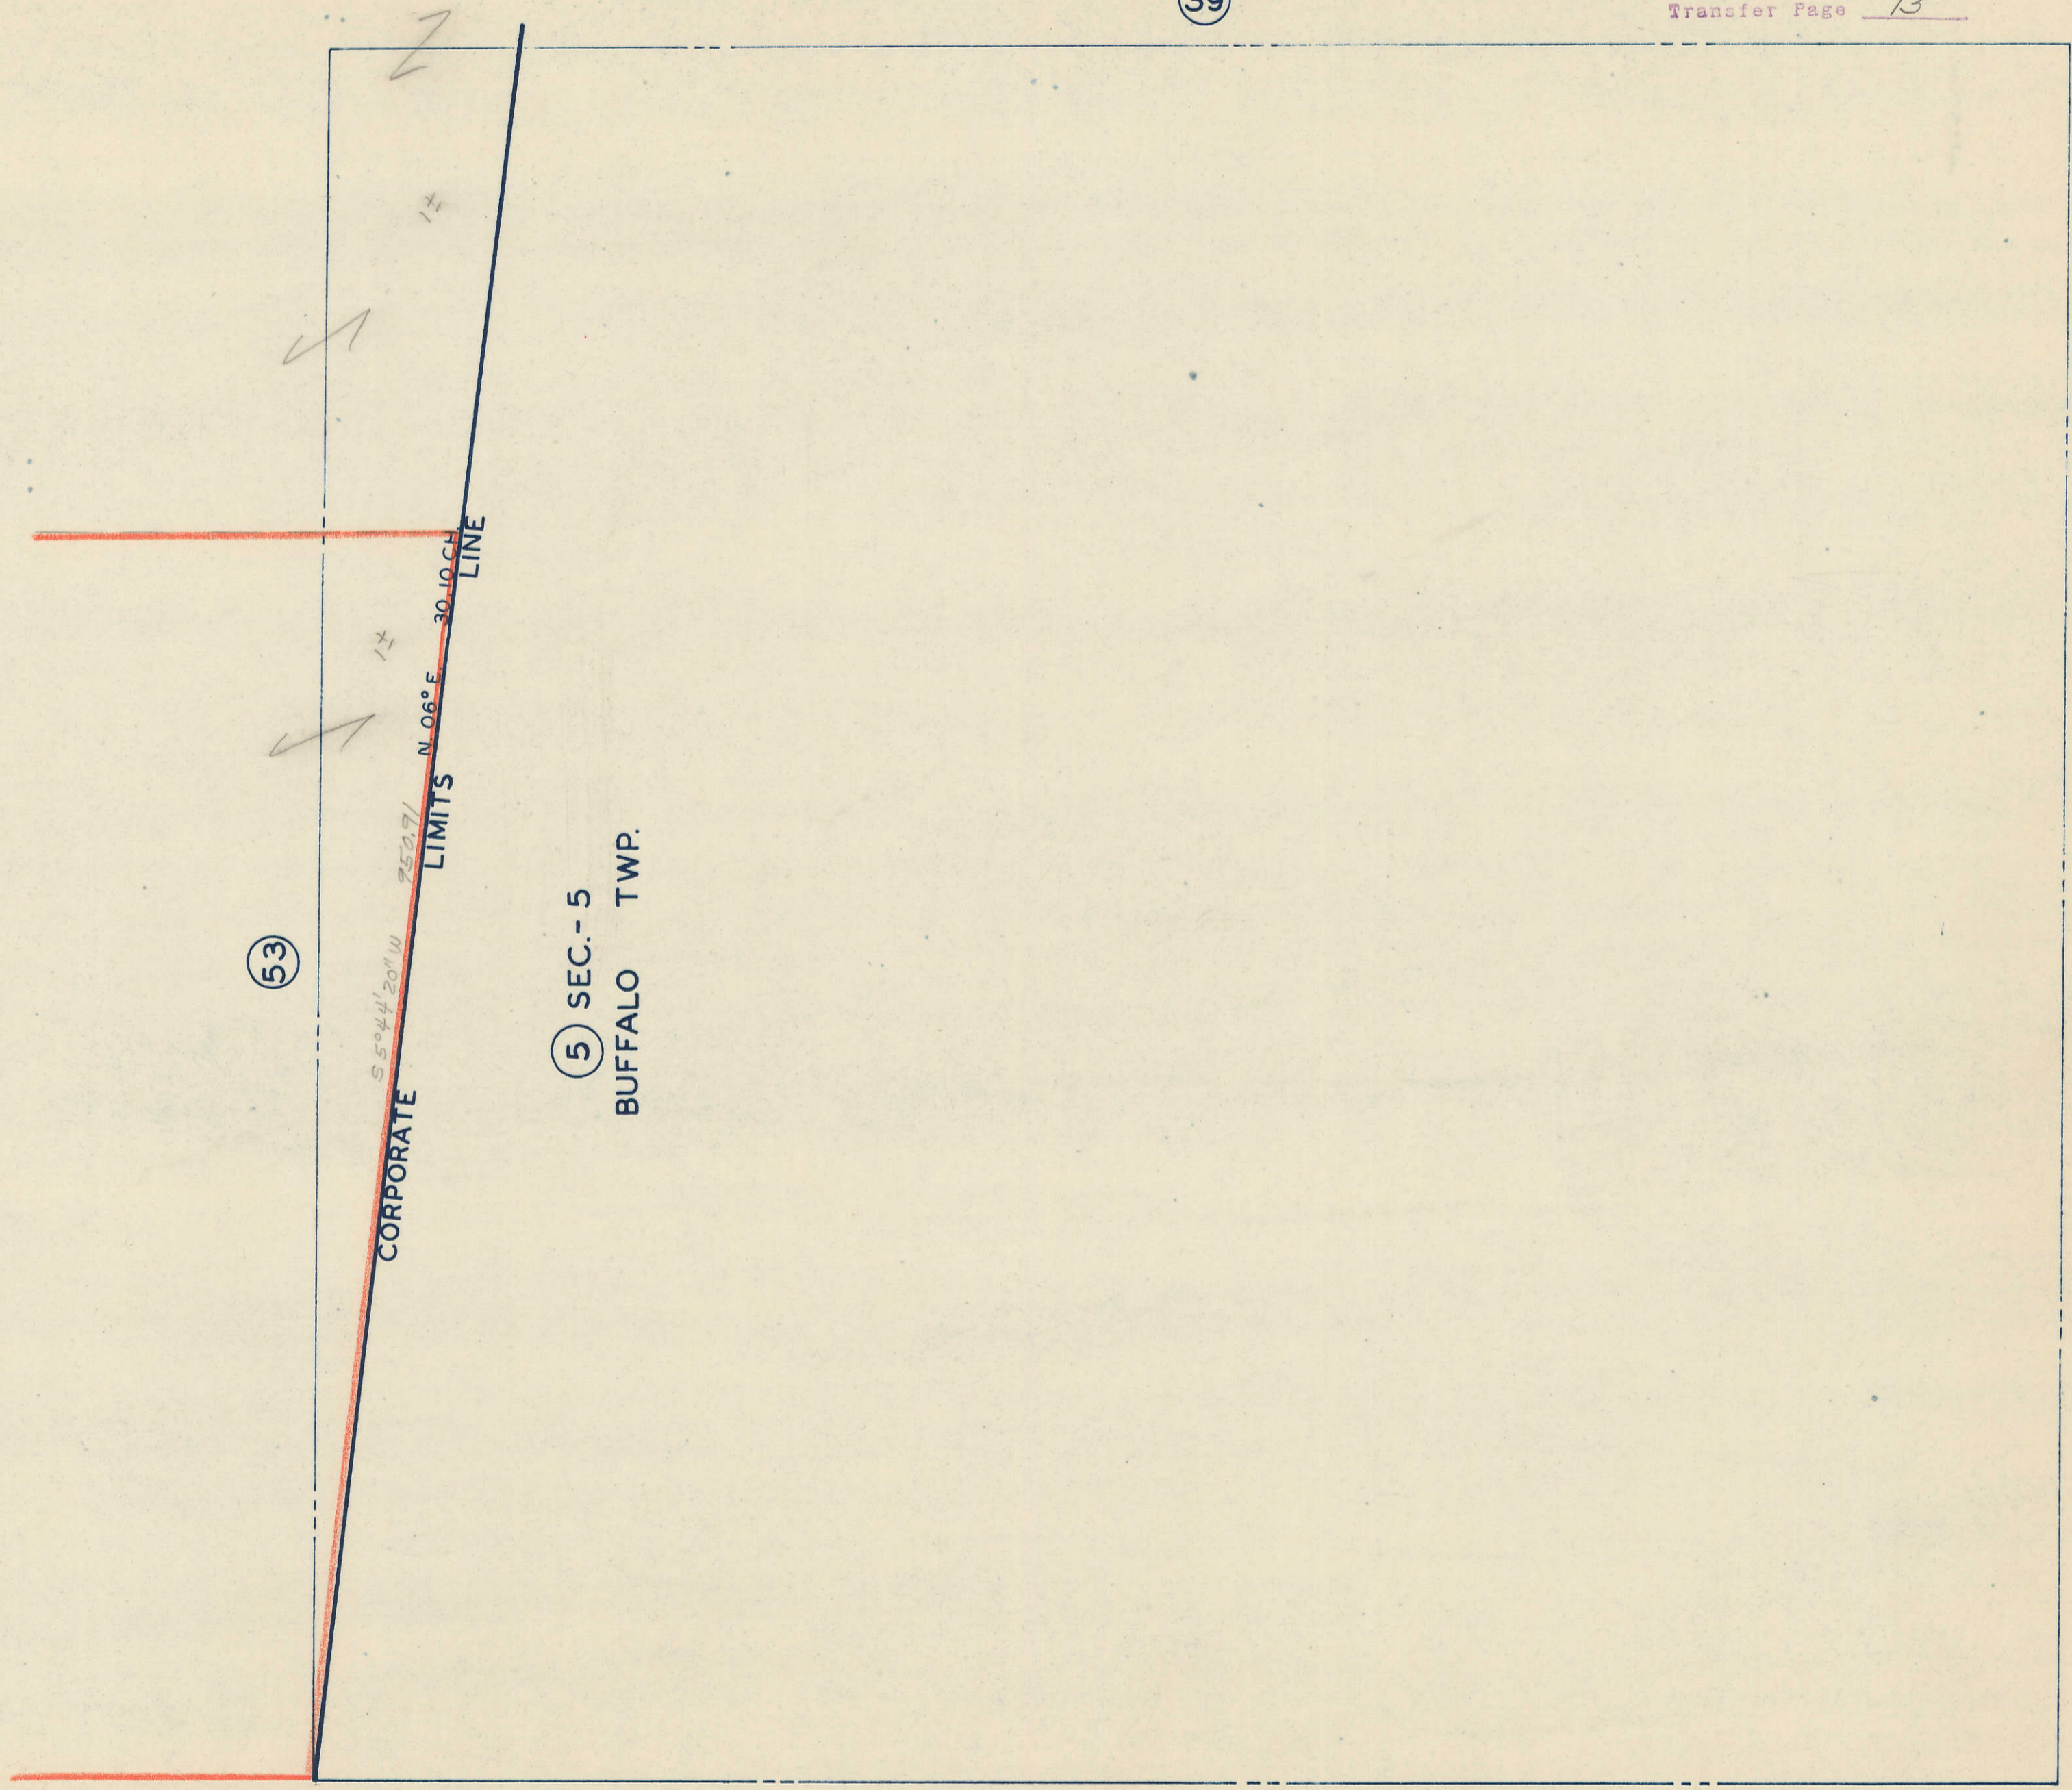

(53)

(5) SEC. - 5
BUFFALO TWP.