


39

Transfer Page 74

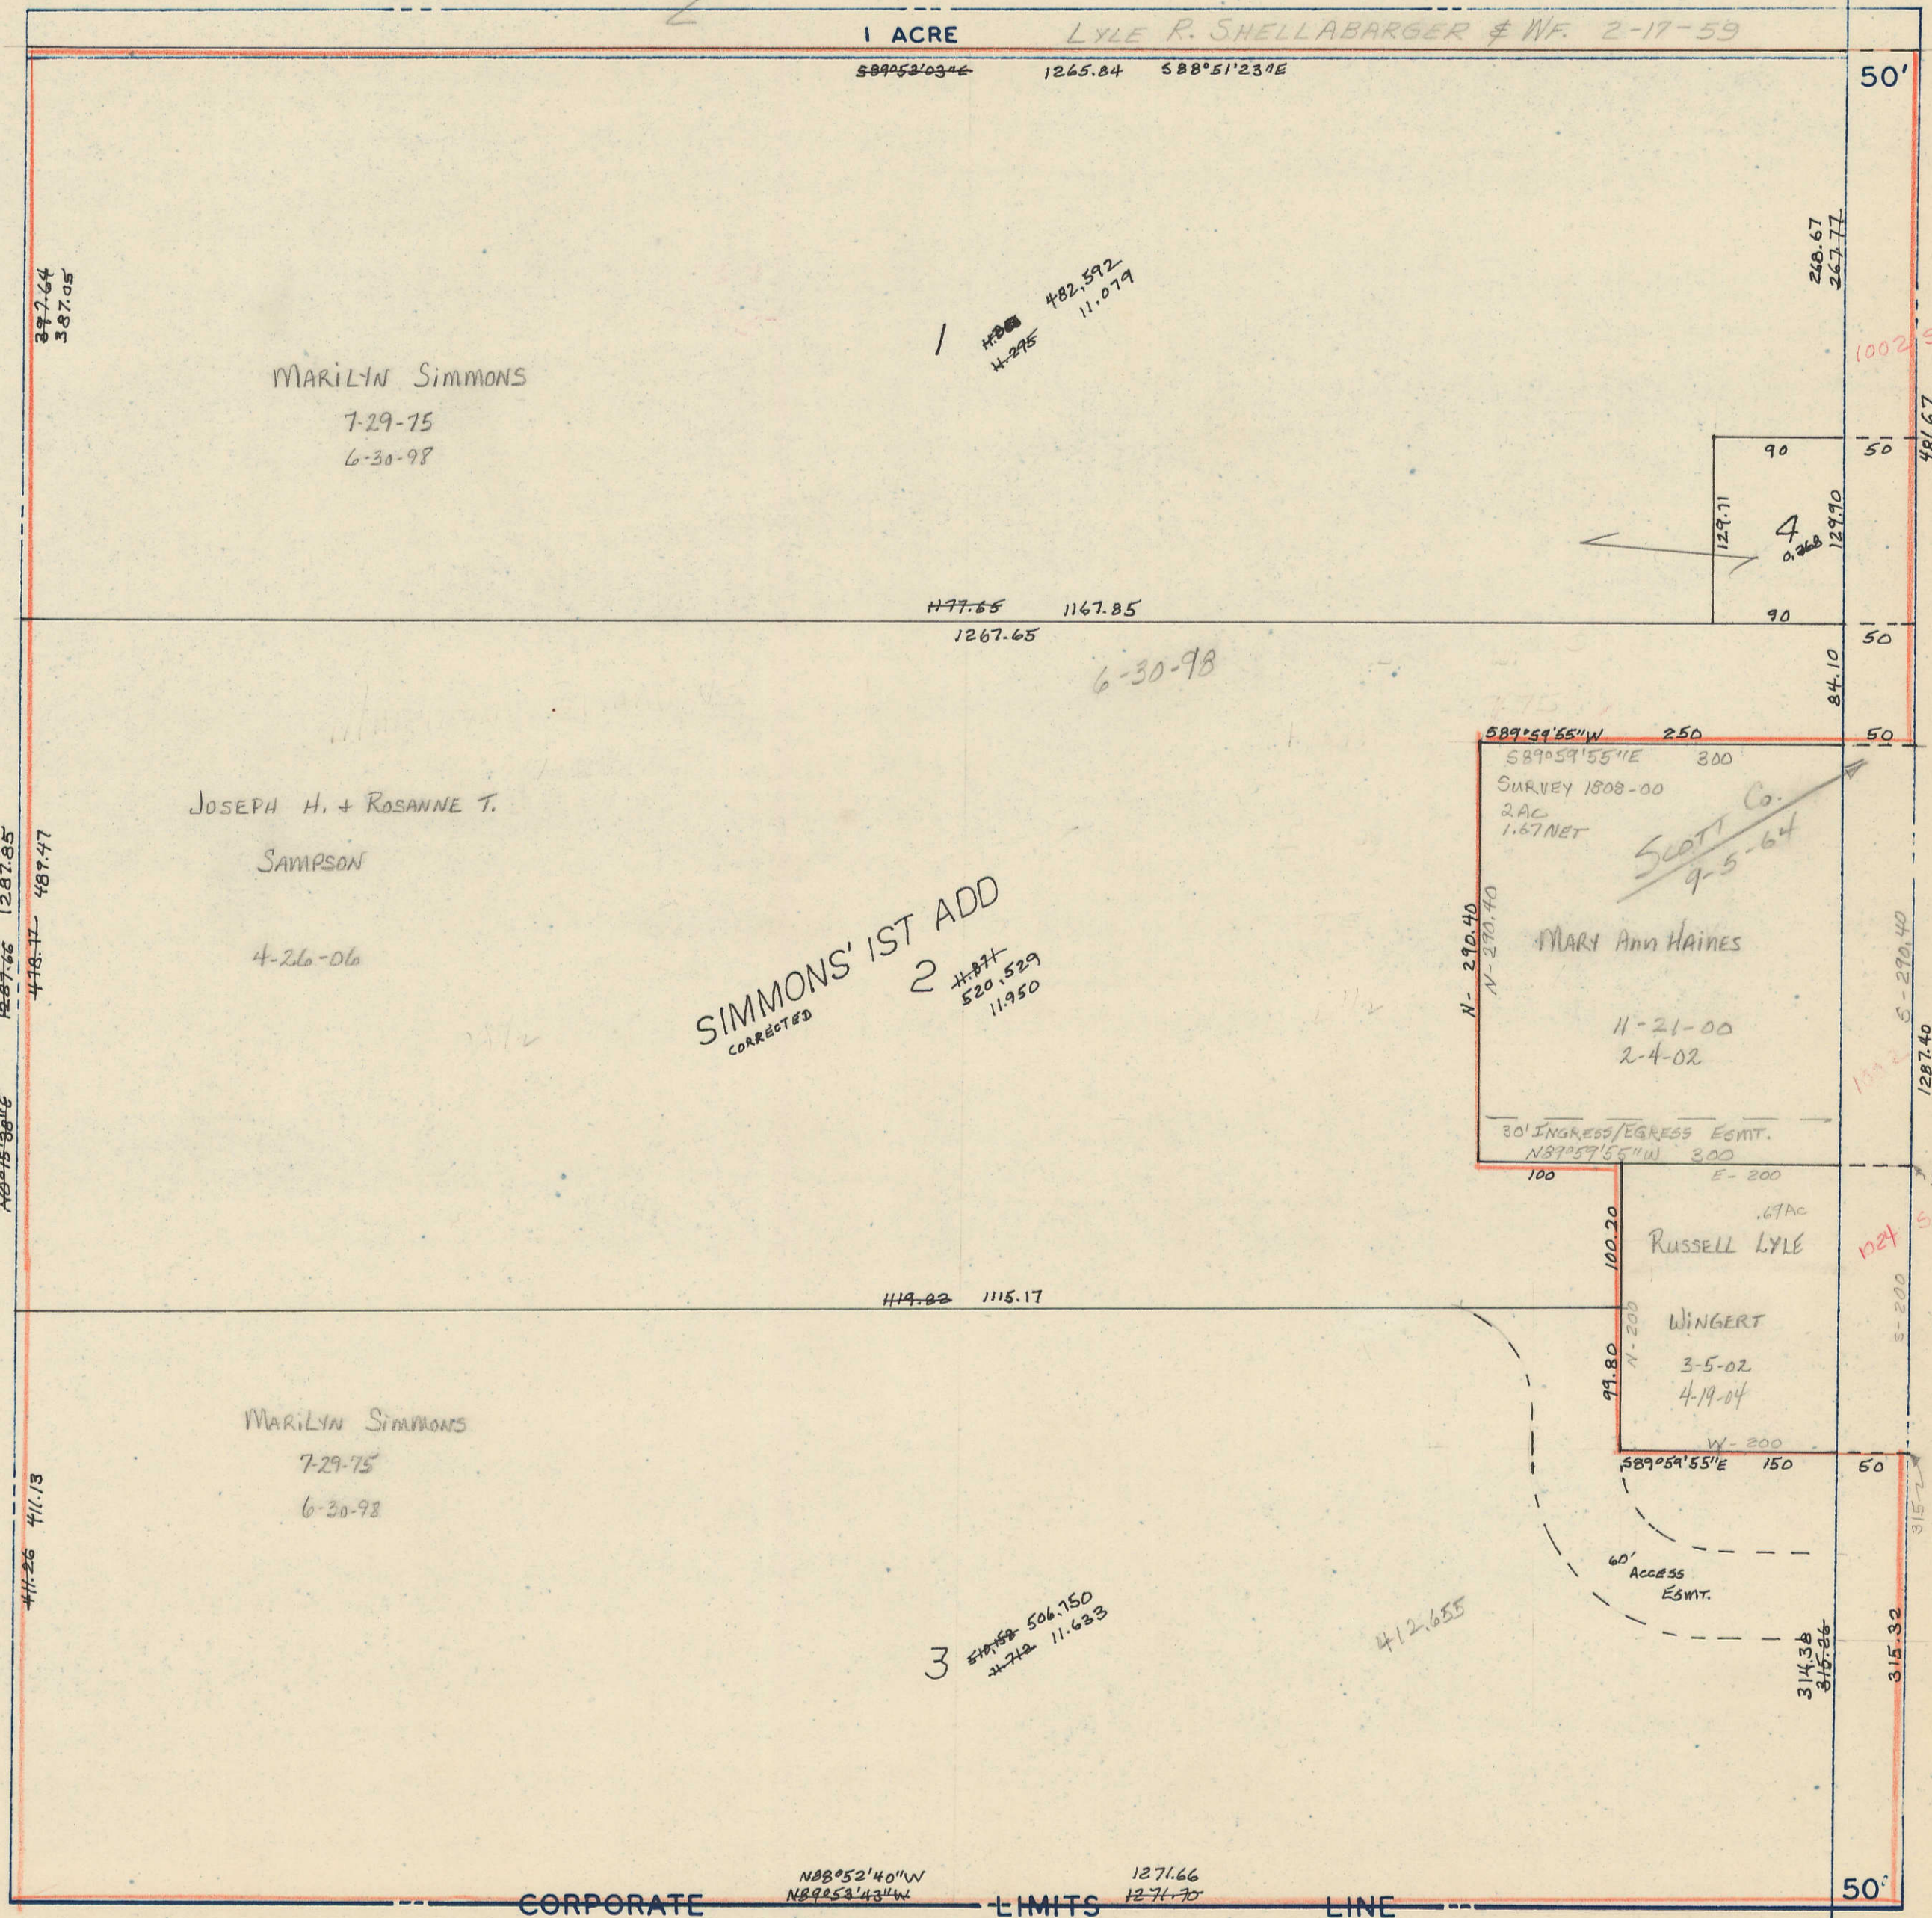

SIMMONS' 1ST ADD
CORRECTED

2

3

7 SEC.-7
BUFFALO TWP.

49 SEC.-5

53