


Transfer Page 63.

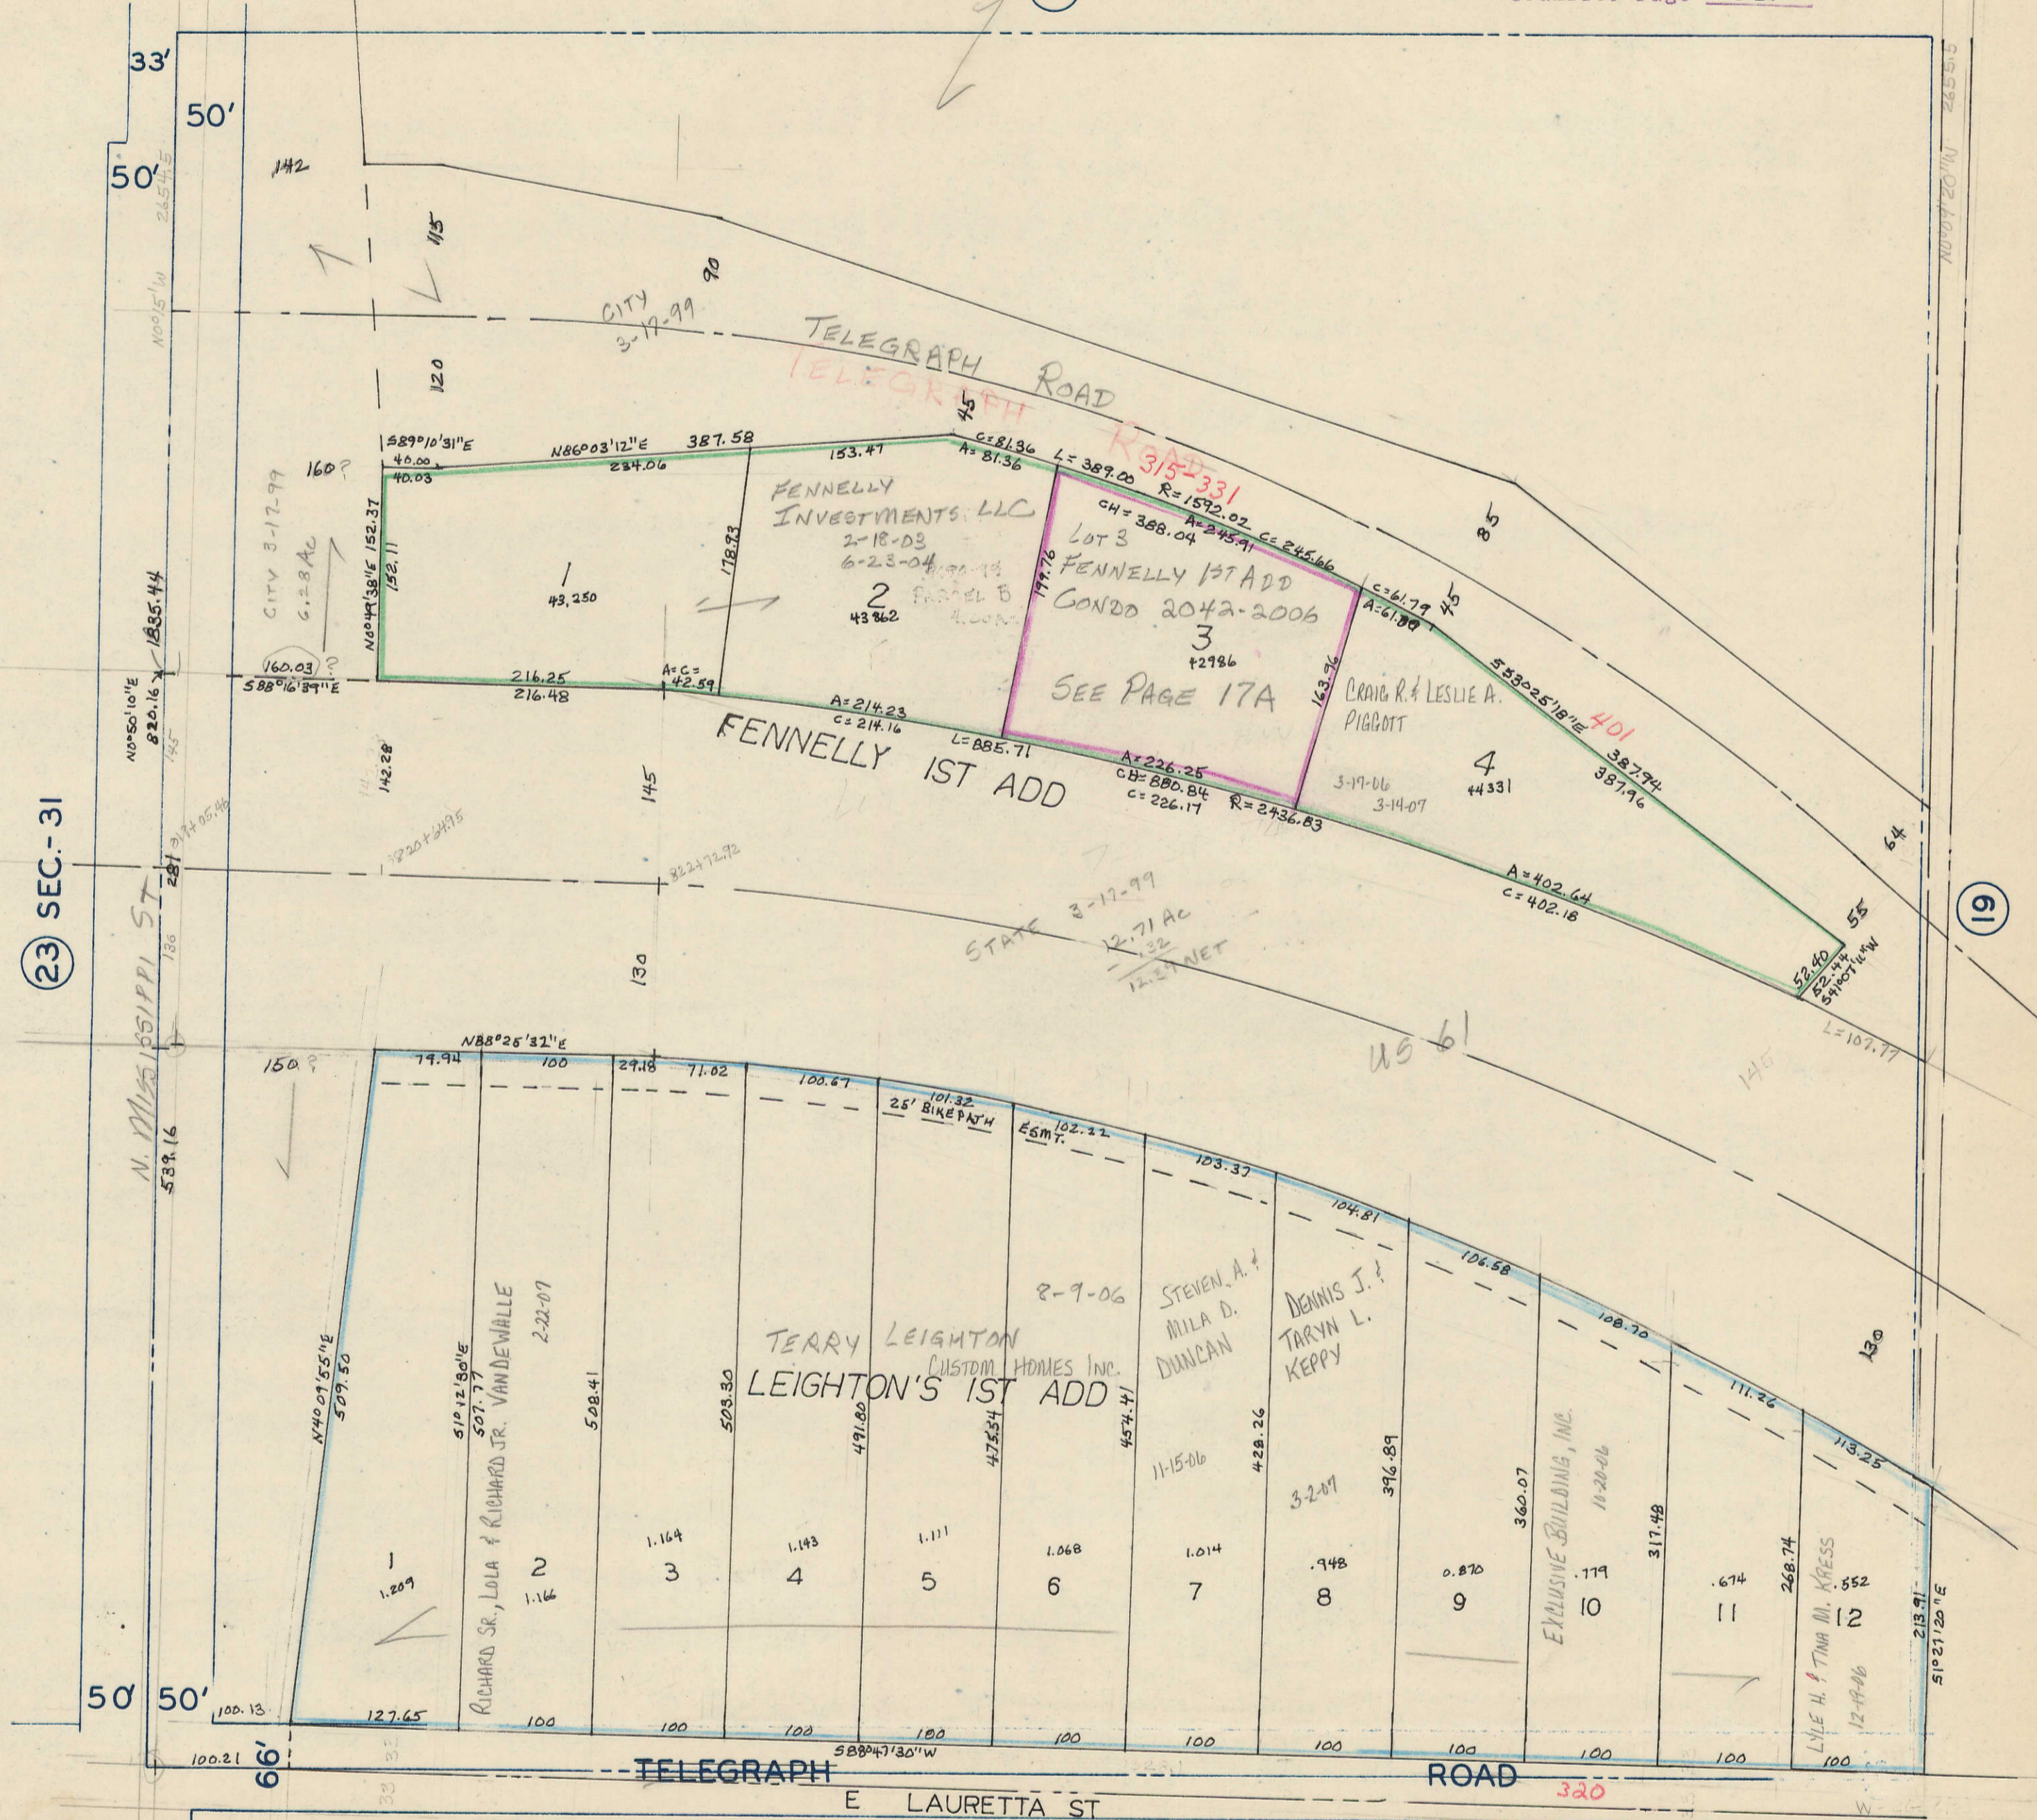

23 SEC.-31

33

34

19

LOT 3 FENNELLY 1ST ADD CONDO
2042-2006
ON LOT 3 FENNELLY 1ST ADD
FENNELLY INVESTMENTS LLC
2-18-03
6-23-04

17A

315A
315B
315C
315D
315E
331A
331B
331C
331D