


(37)

Transfer Page 63

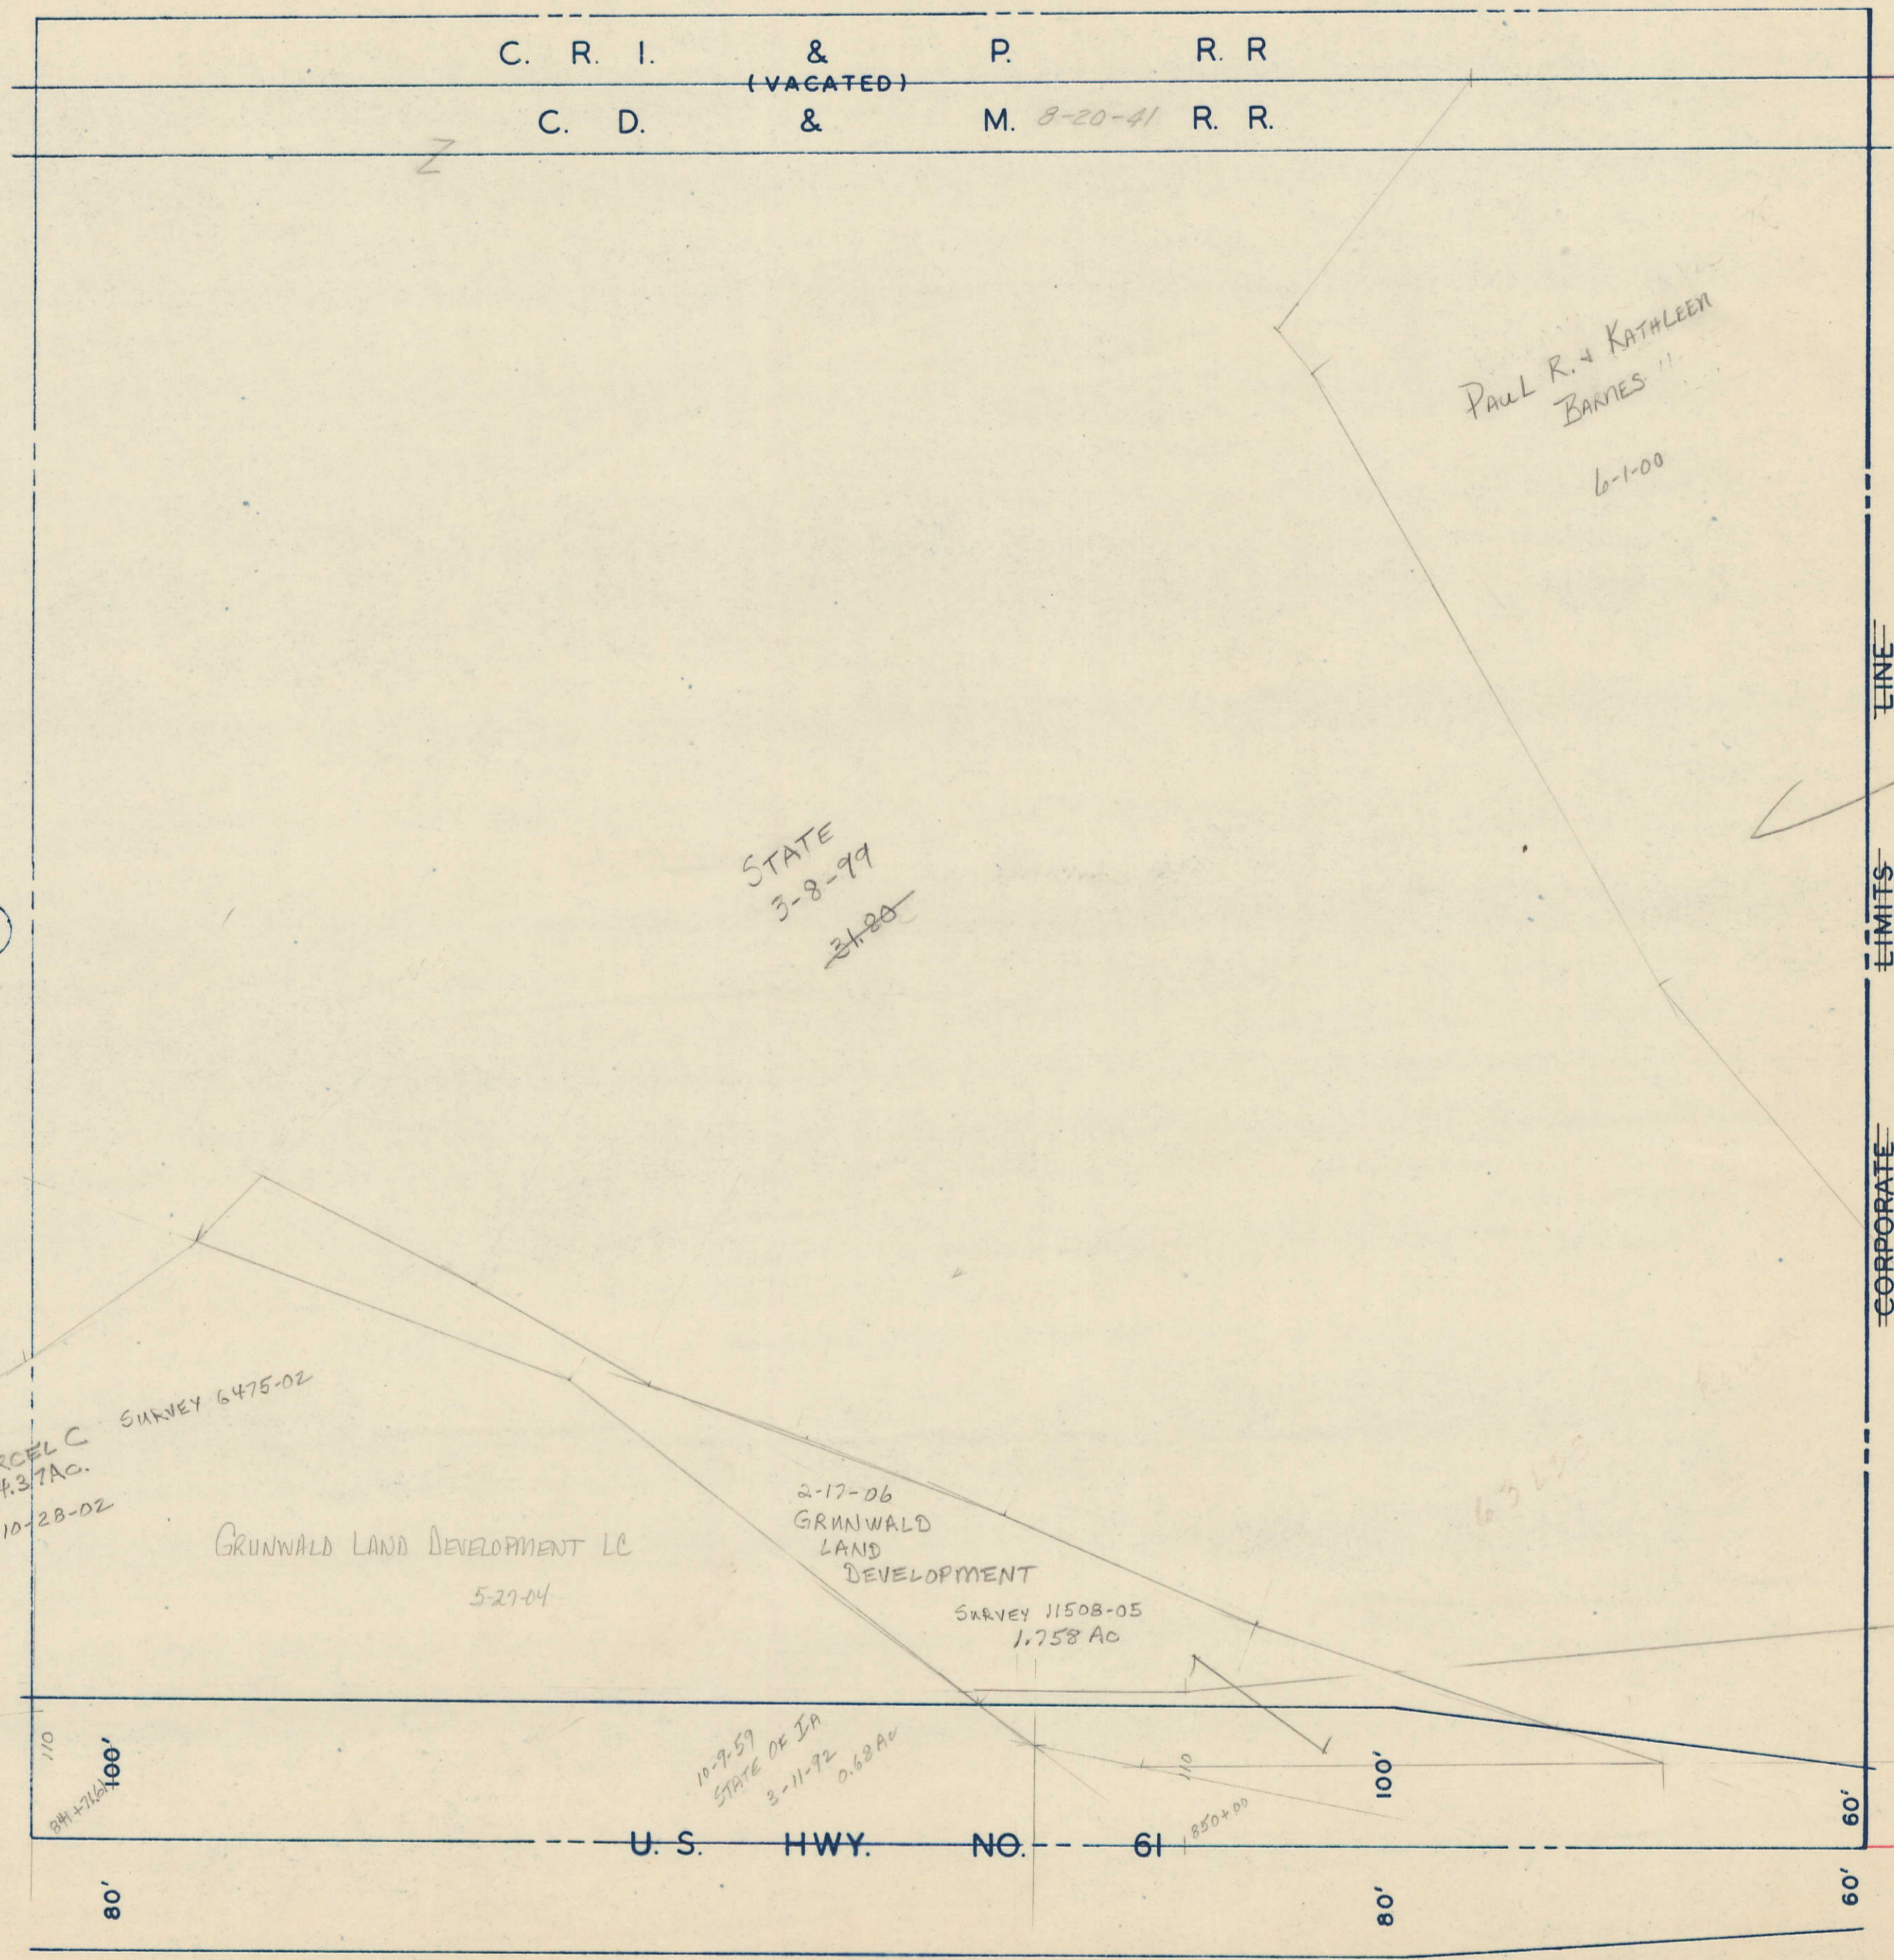

(51)

CORPORATE LIMITS LINE

(32) SEC. - 32

BLUEGRASS TWP. 55

(5) SEC. 5