

US HWY 61


SCOTT COUNTY WEST BUSINESS PARK

732 AC  
STATE  
6-21-99

157.85 AC

N80°42'50"E  
206.08

N79°56'56"E  
800.33

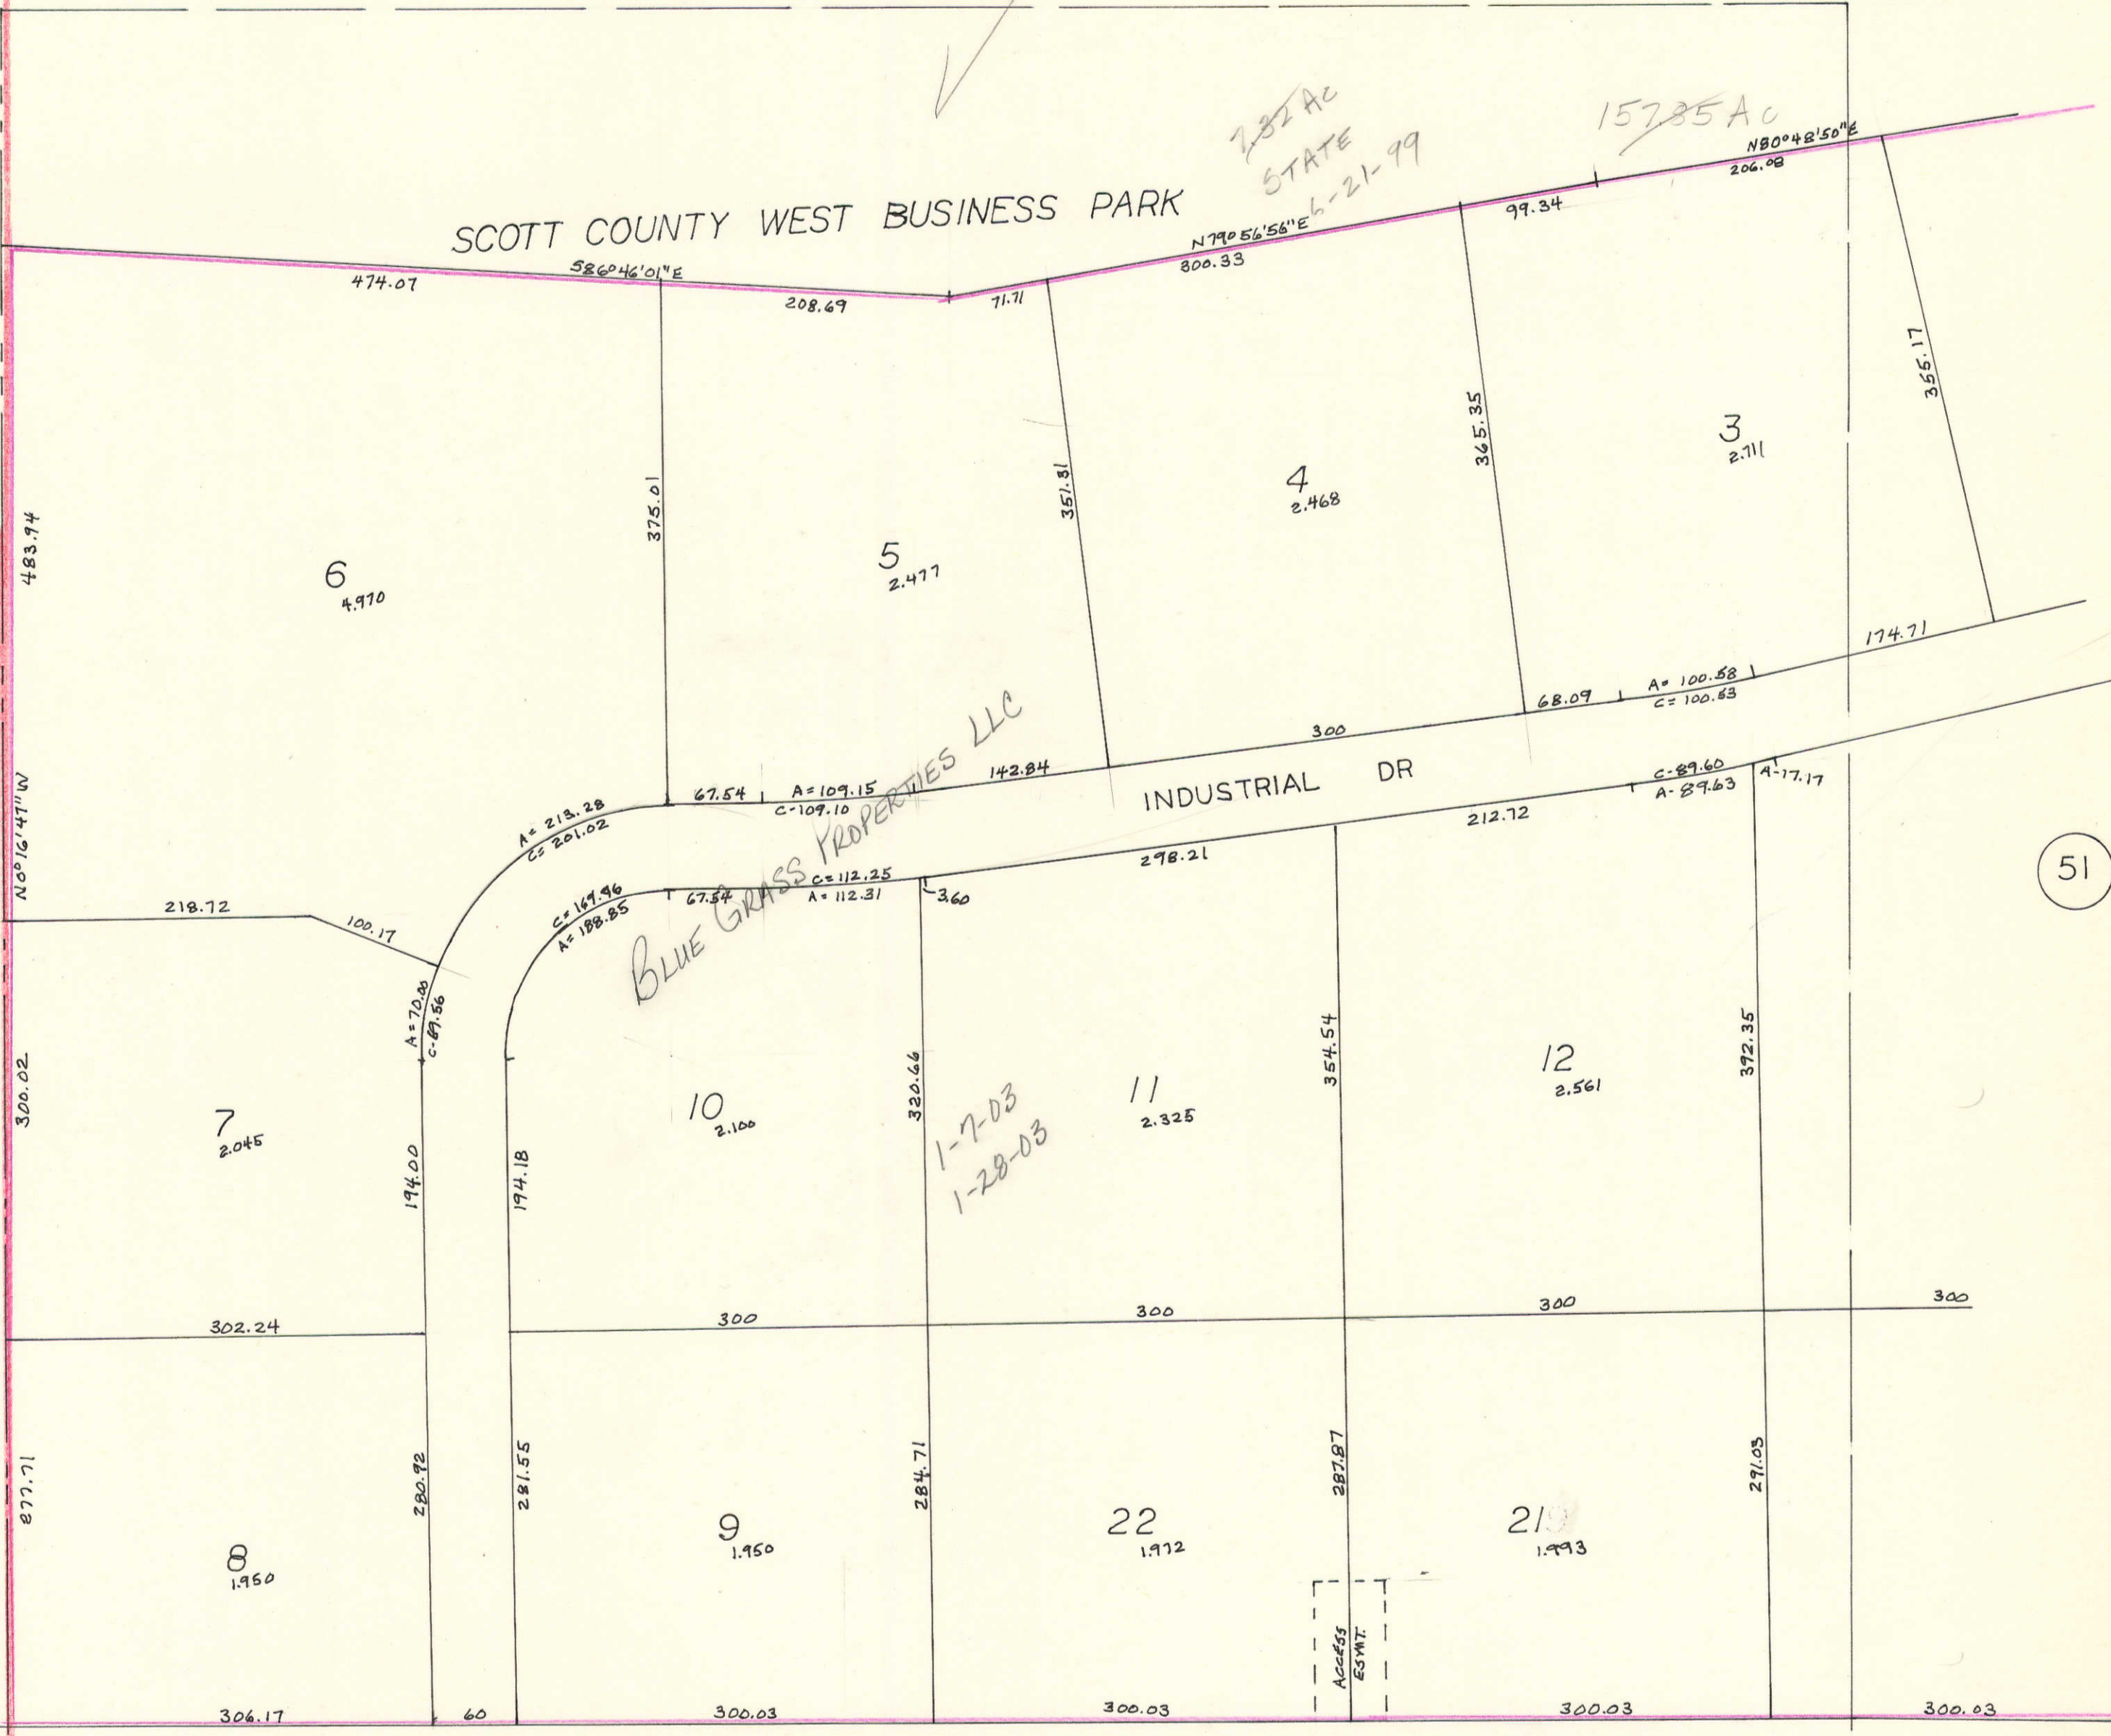

SEC. 36-78-1

MUSCATINE COUNTY

39.90 AC

N6°16'47"W

300.02

877.71

36 31 13.65  
1 6 60

