




NE 1/4, SE 1/4 SEC 25-78-2
SCALE: 1"=100'

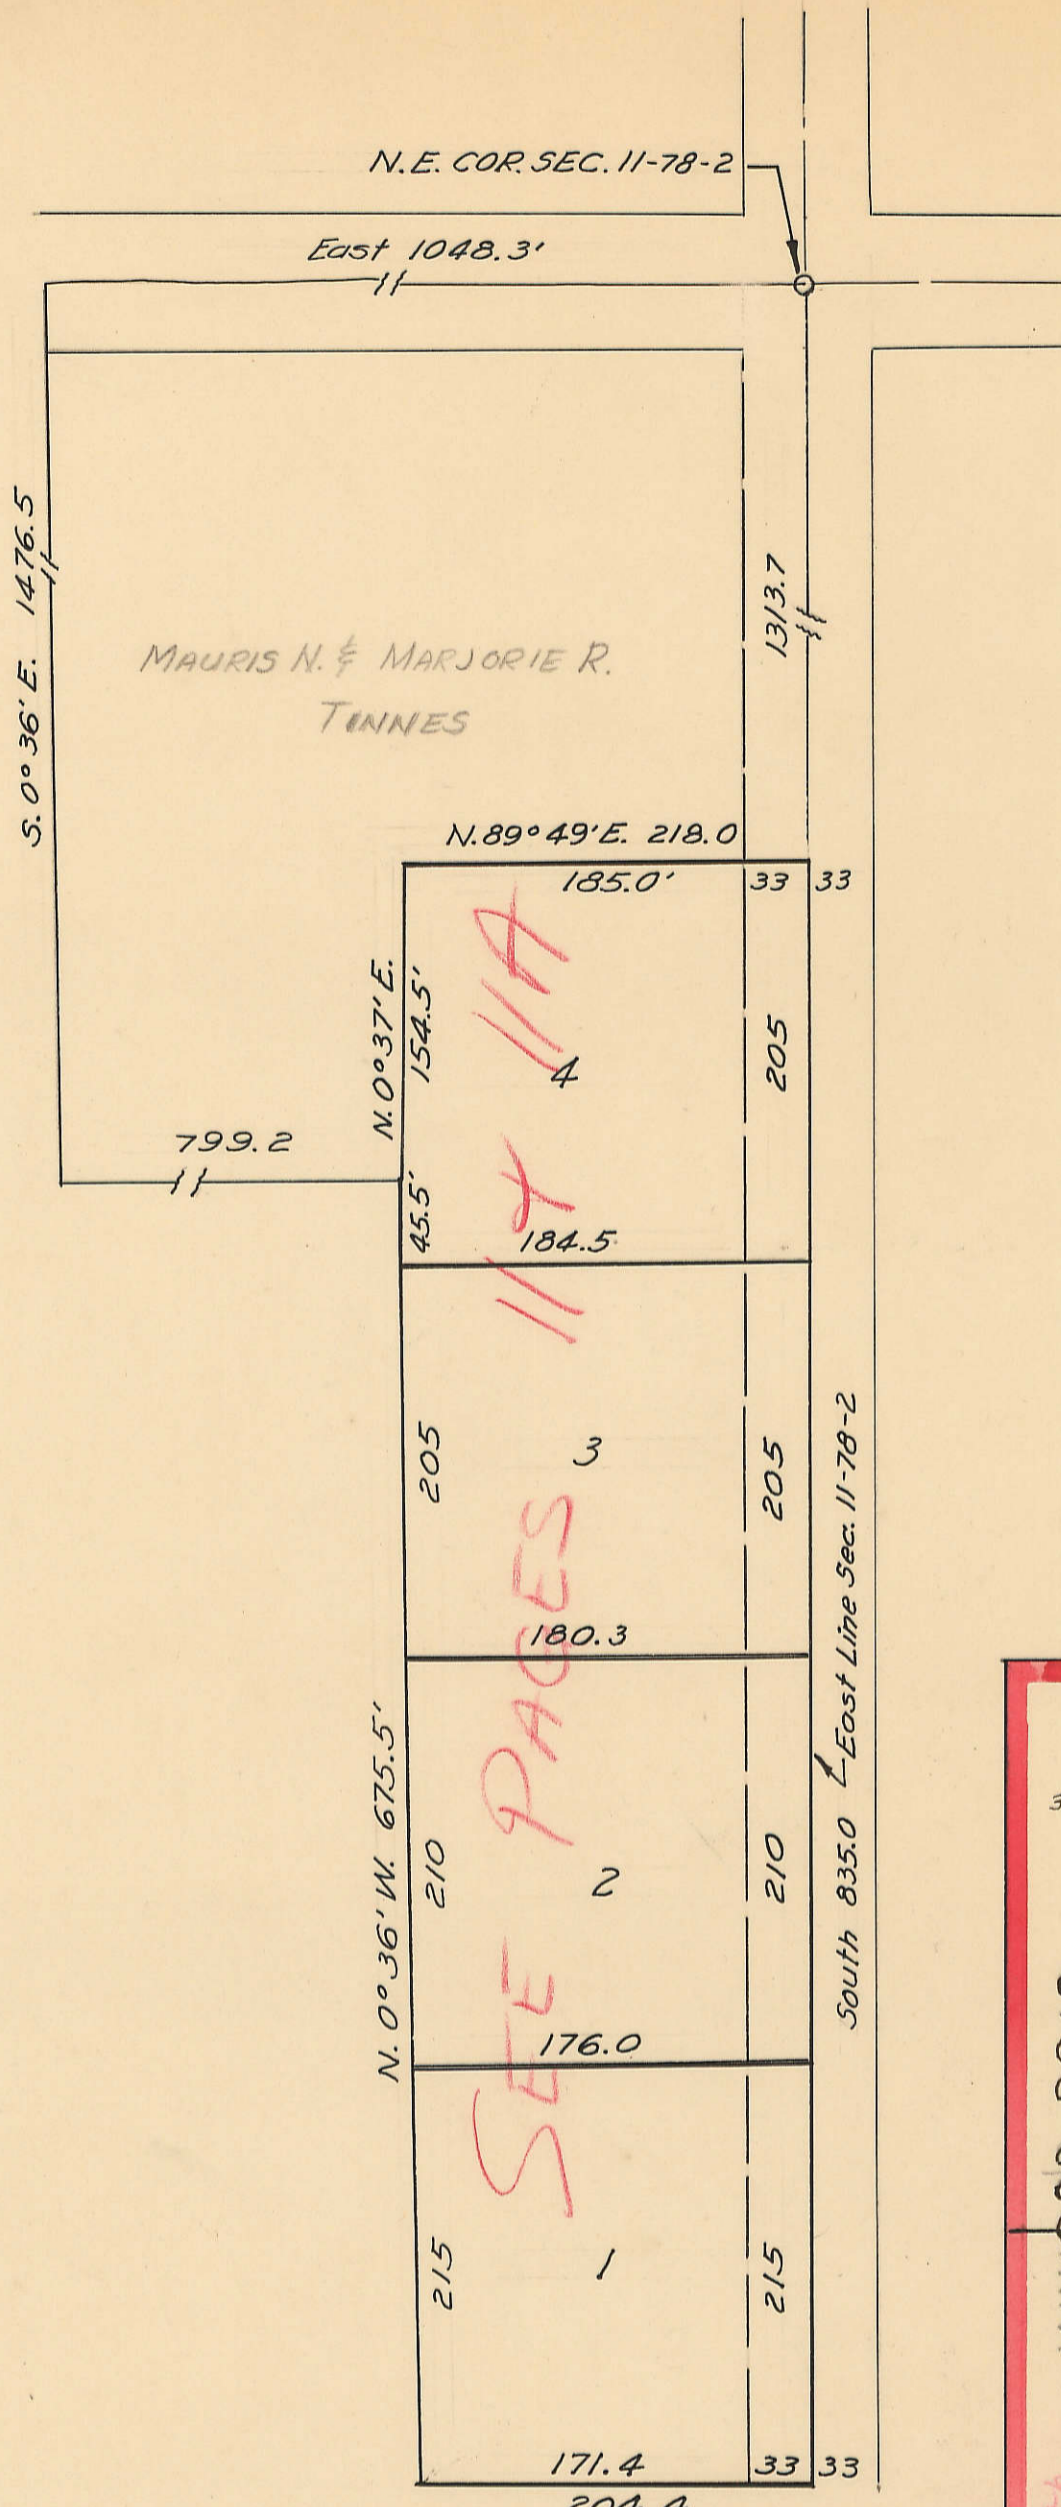


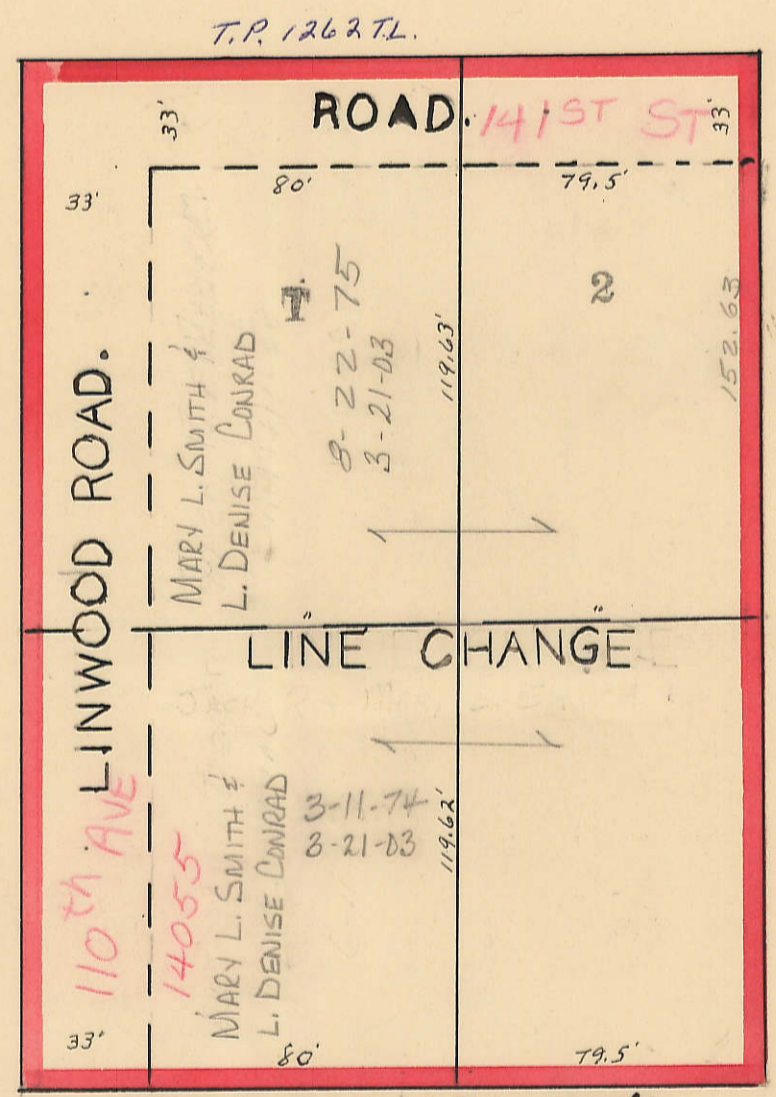

FASHIONABLE MEADOWS 1ST SUBDIVISION

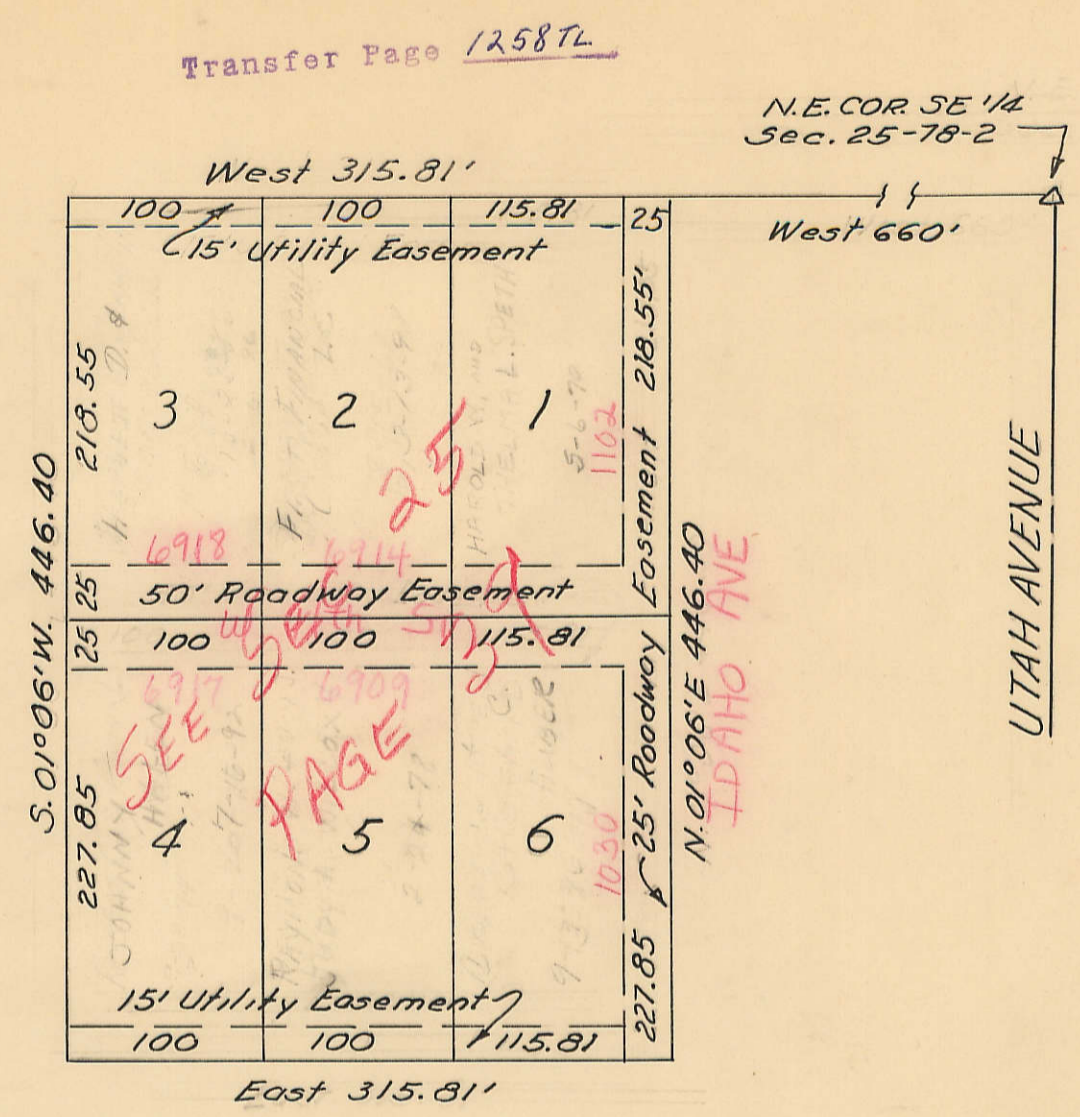

B. J. MAHONEY'S THIRD SUBD. REPLAT LOT 1+2

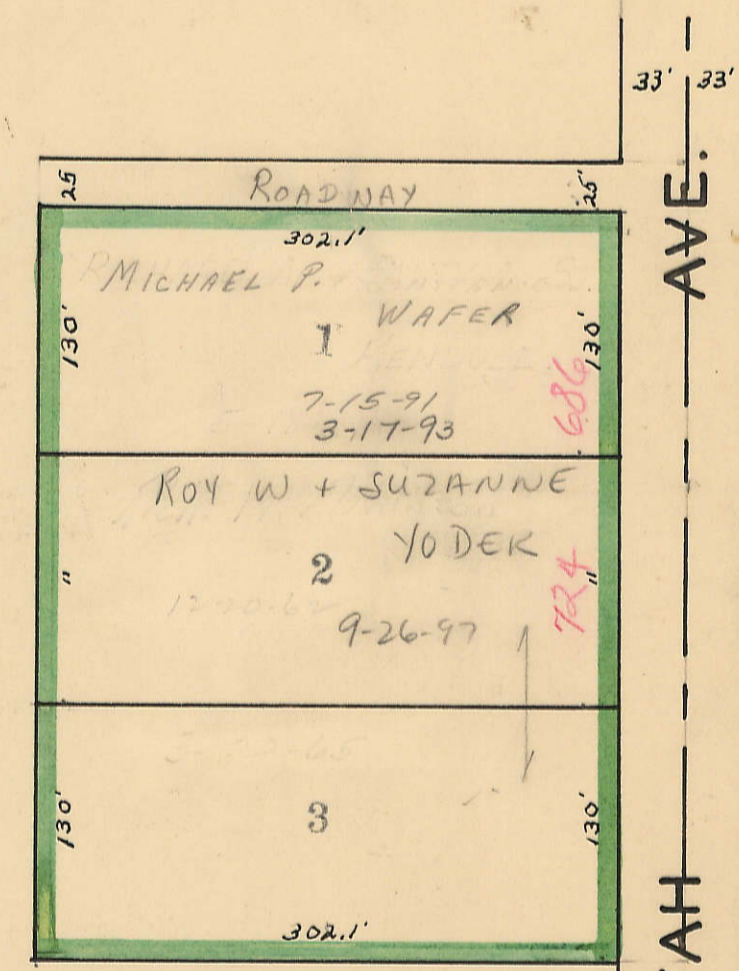

KIRKPATRICKS 1ST ADD.