

SECTION 17

Township 78-North; Range 2

EAST OF THE FIFTH PRINCIPAL MERIDIAN


SCOTT COUNTY, IOWA

BLUE GRASS TOWNSHIP

NORTH

Transfer Page 48

SCALE IN CHAINS

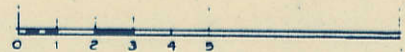

SCALE IN FEET




WEST

170th AVE

EAST

80th AVE

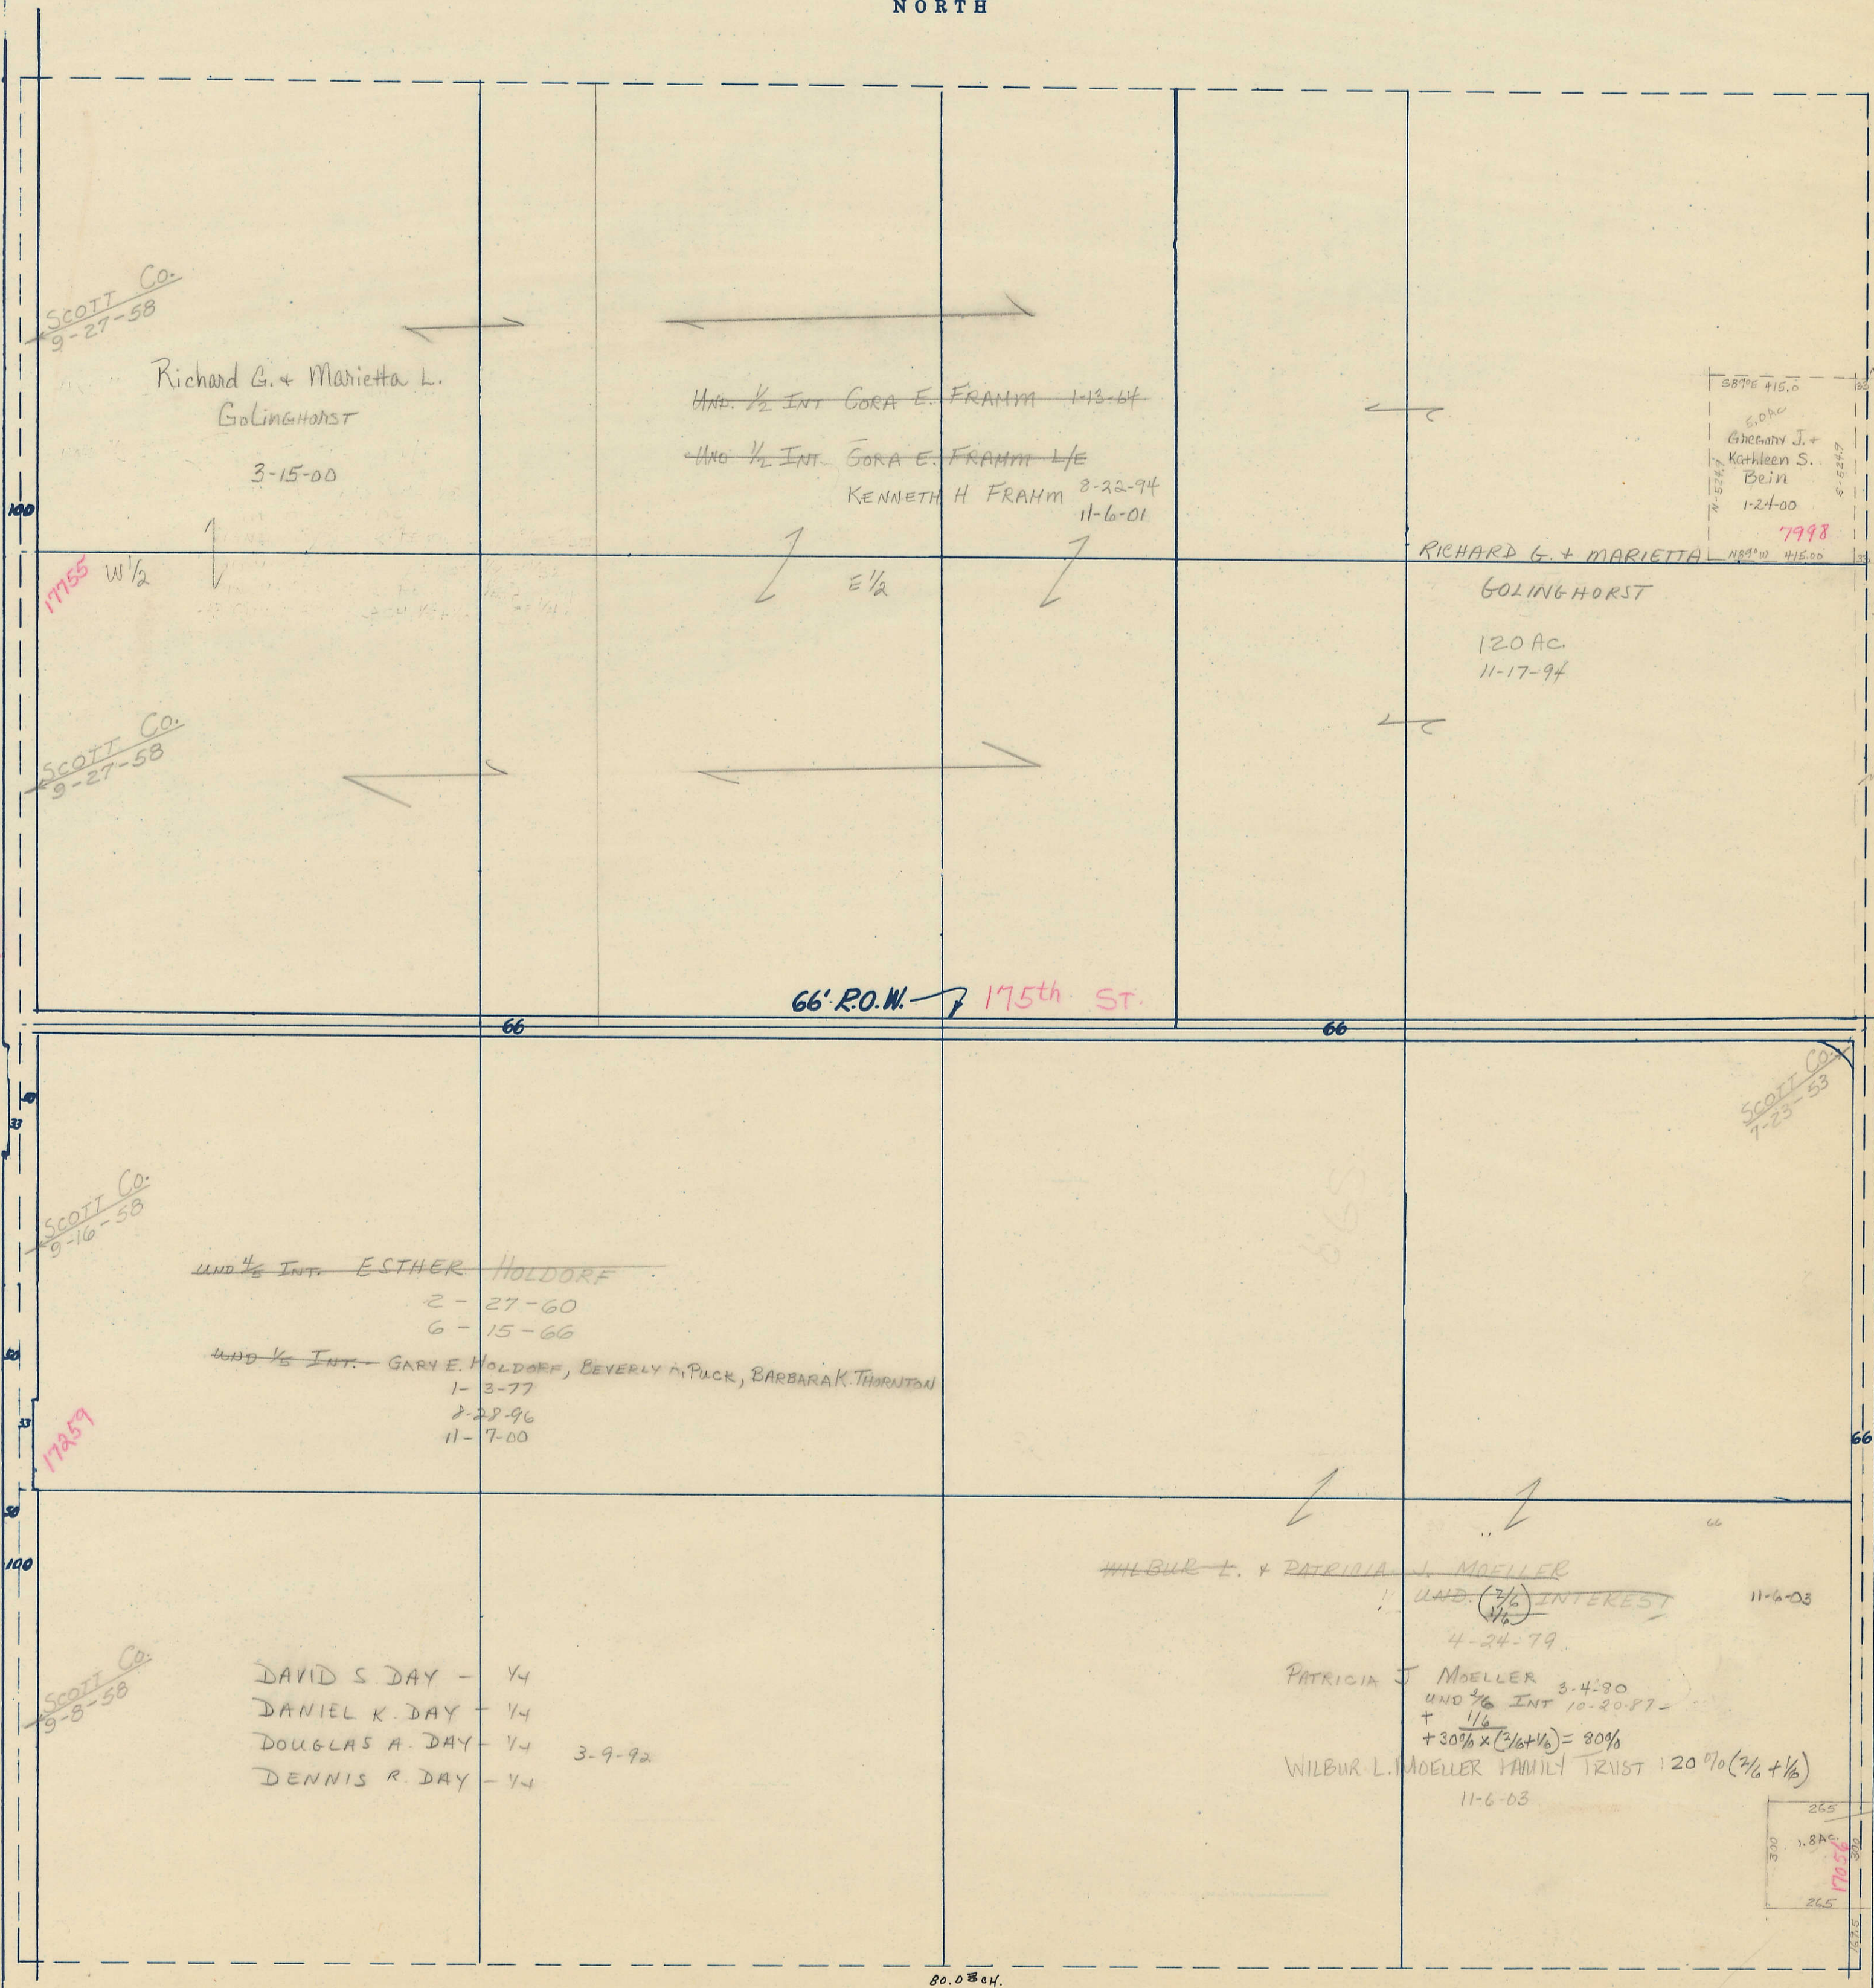

SOUTH

SCOTT Co. 9-27-58

Richard G. + Marietta L. Golinghorst 3-15-00

UND. 1/2 INT. CORA E. FRAMM 1-13-04
UND. 1/2 INT. CORA E. FRAMM 1/2
KENNETH H. FRAMM 8-22-94 11-6-01

6.0 AC. GEORGE J. + KATHLEEN S. BEIN 1-24-00 7998

RICHARD G. + MARIETTA GOLINGHORST 120 AC. 11-17-94

SCOTT Co. 9-27-58

17755 W 1/2

66' R.O.W. 175th ST.

SCOTT Co. 9-16-58

UND. 1/2 INT. ESTHER HOLDORF 2-27-60 6-15-66
UND. 1/2 INT. GARY E. HOLDORF, BEVERLY M. PUCK, BARBARA K. THORNTON 1-3-77 8-28-96 11-7-00

SCOTT Co. 9-8-58

DAVID S. DAY - 1/4
DANIEL K. DAY - 1/4
DOUGLAS A. DAY - 1/4 3-9-92
DENNIS R. DAY - 1/4

SCOTT Co. 7-23-53

WILBUR L. + PATRICIA J. MOELLER
UND. (3/4) INTEREST 11-6-03
4-24-79
PATRICIA J. MOELLER 3-4-80
11-6-03

265 1.8 AC. 265 17055
