


NE 1/4, SE 1/4 SEC. 16-77-2  
TOWN OF BUFFALO  
SCALE: 1" = 100'

Transfer Page 84 LDC

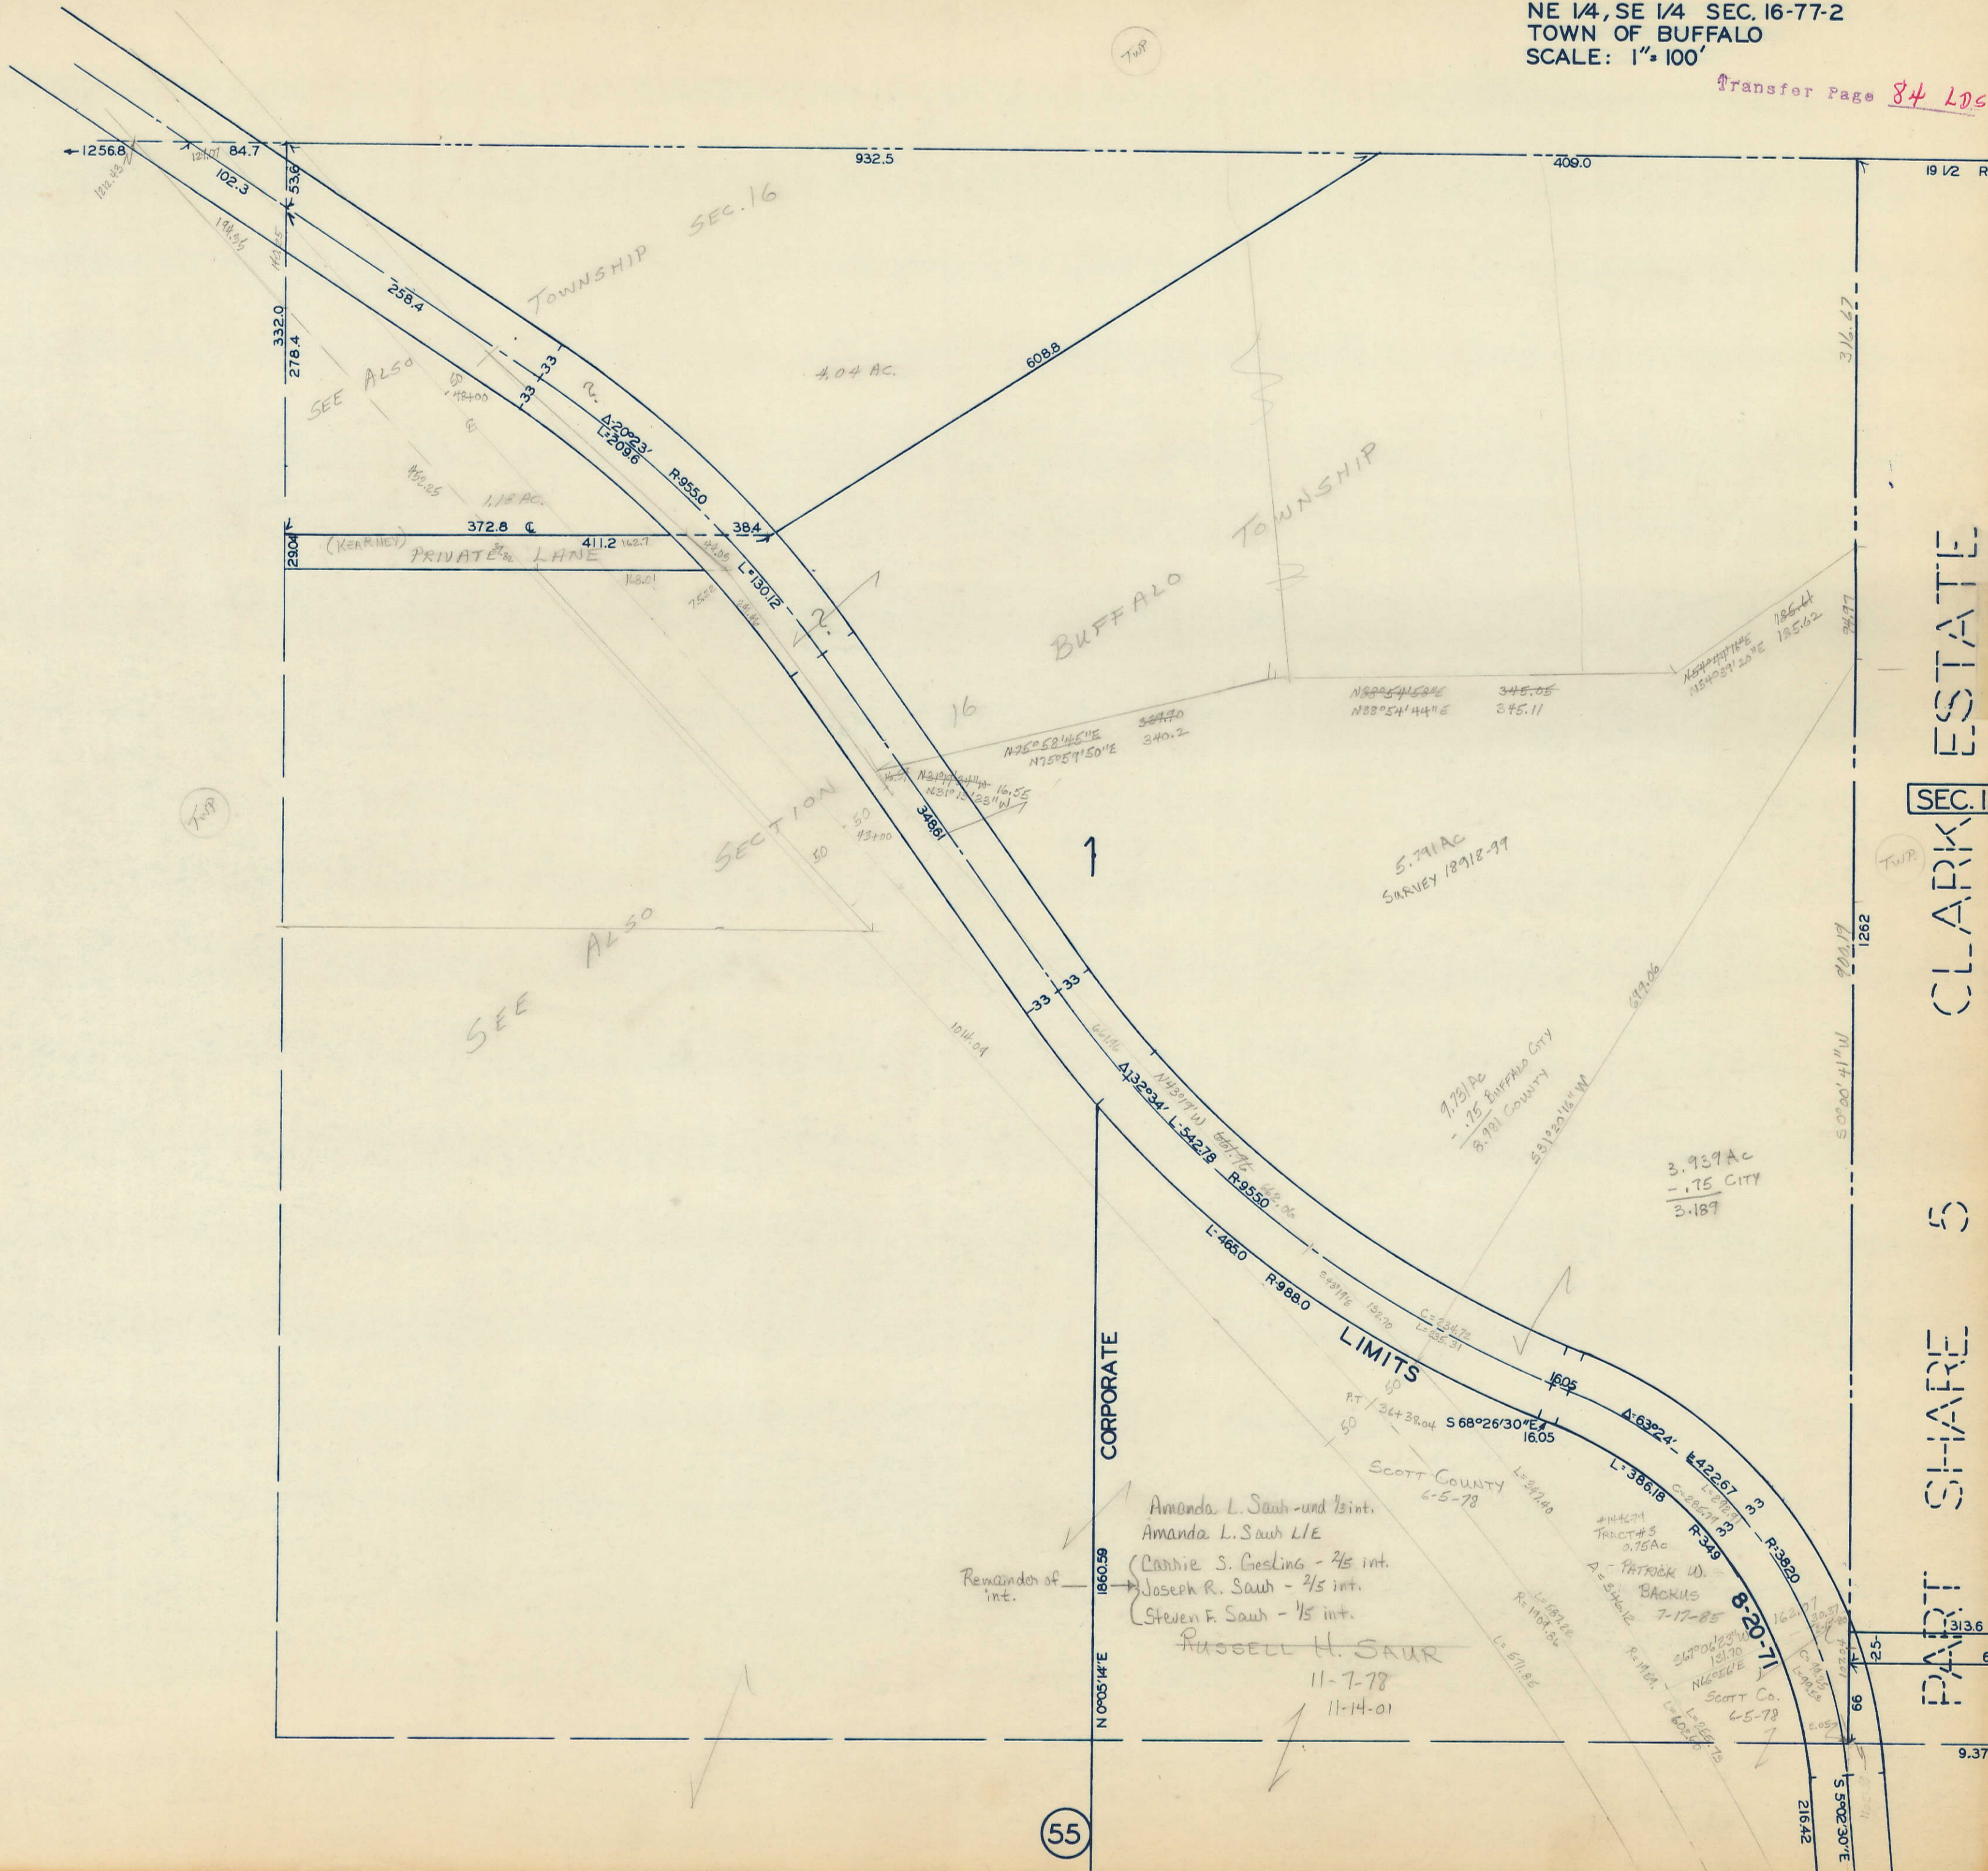

CLARK ESTATE

SEC. 16

TWP

5S

SHARE

PART

Sec 16-77-2

Remainder of int.

Amanda L. Saur - und 1/3 int.  
Amanda L. Saur LIE  
Carnie S. Gosling - 2/5 int.  
Joseph R. Saur - 2/5 int.  
Steven F. Saur - 1/5 int.

**RUSSELL H. SAUR**  
11-7-78  
11-14-01