


Transfer Page 81 LANDS

Sec 13-77-2

7 SEC. 14

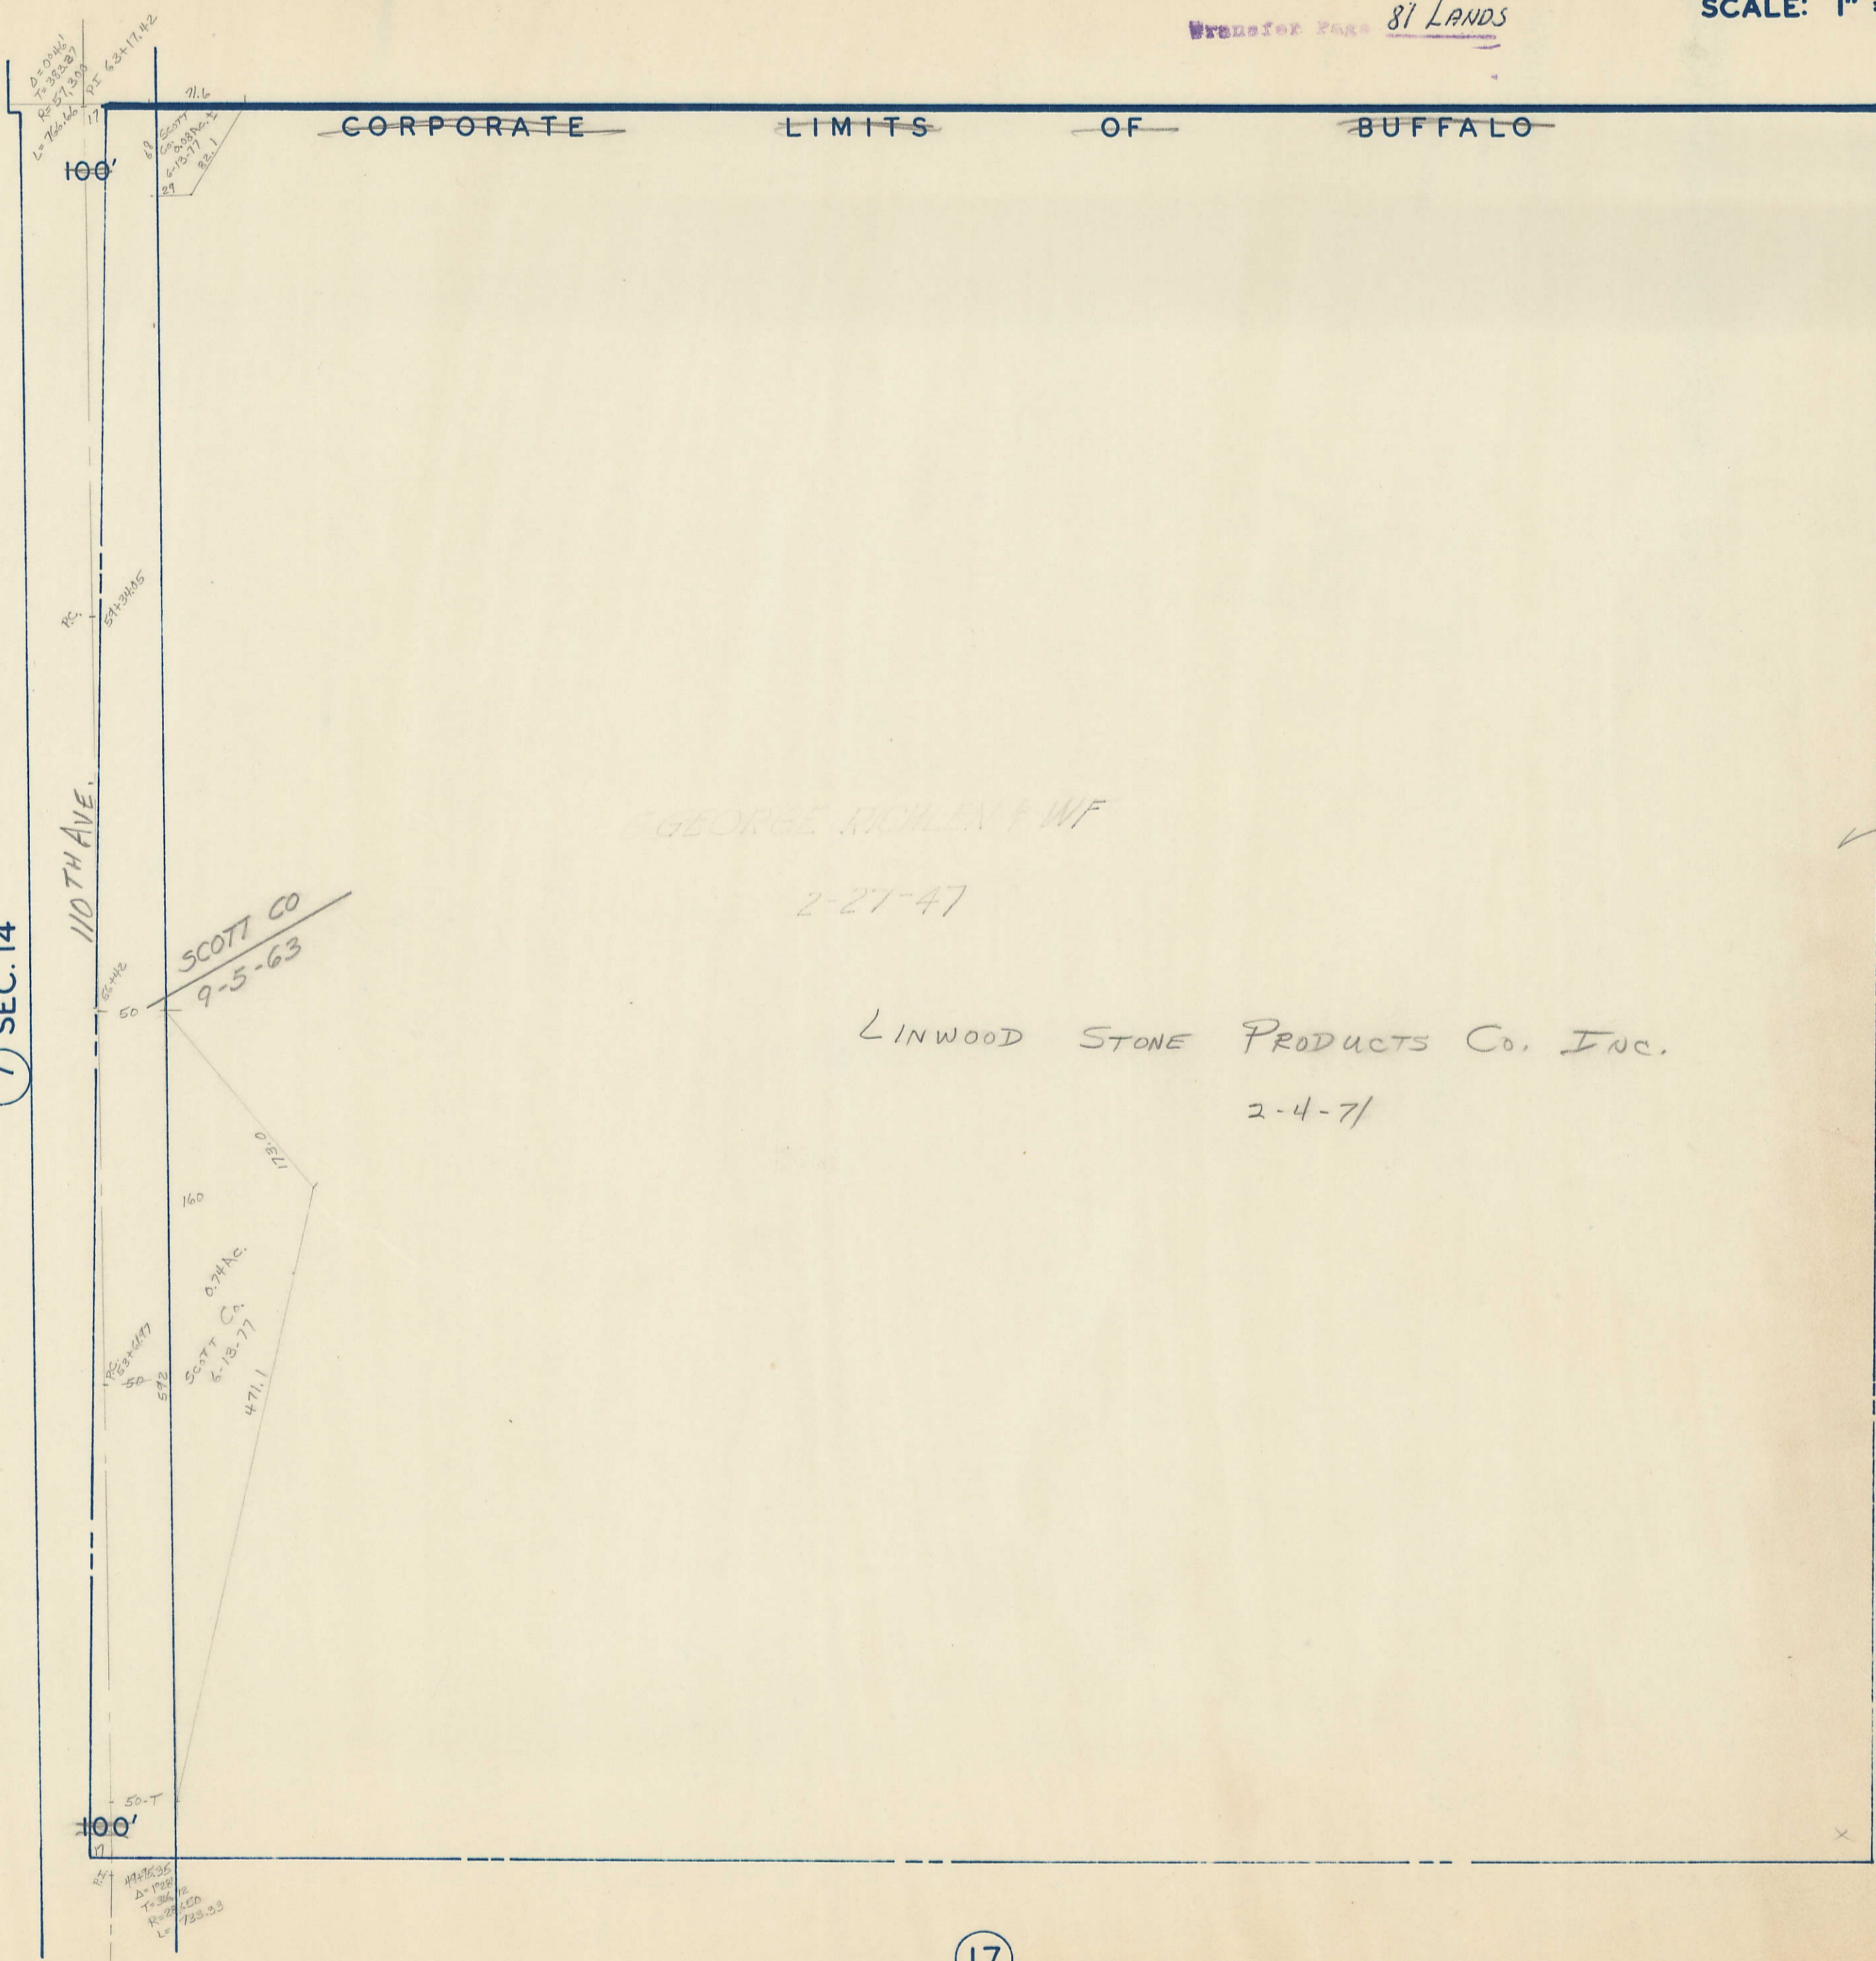

3

17