


Transfer Page 81 LANDS

SEE BUFFALO TOWNSHIP BOOK PAGE 13

53

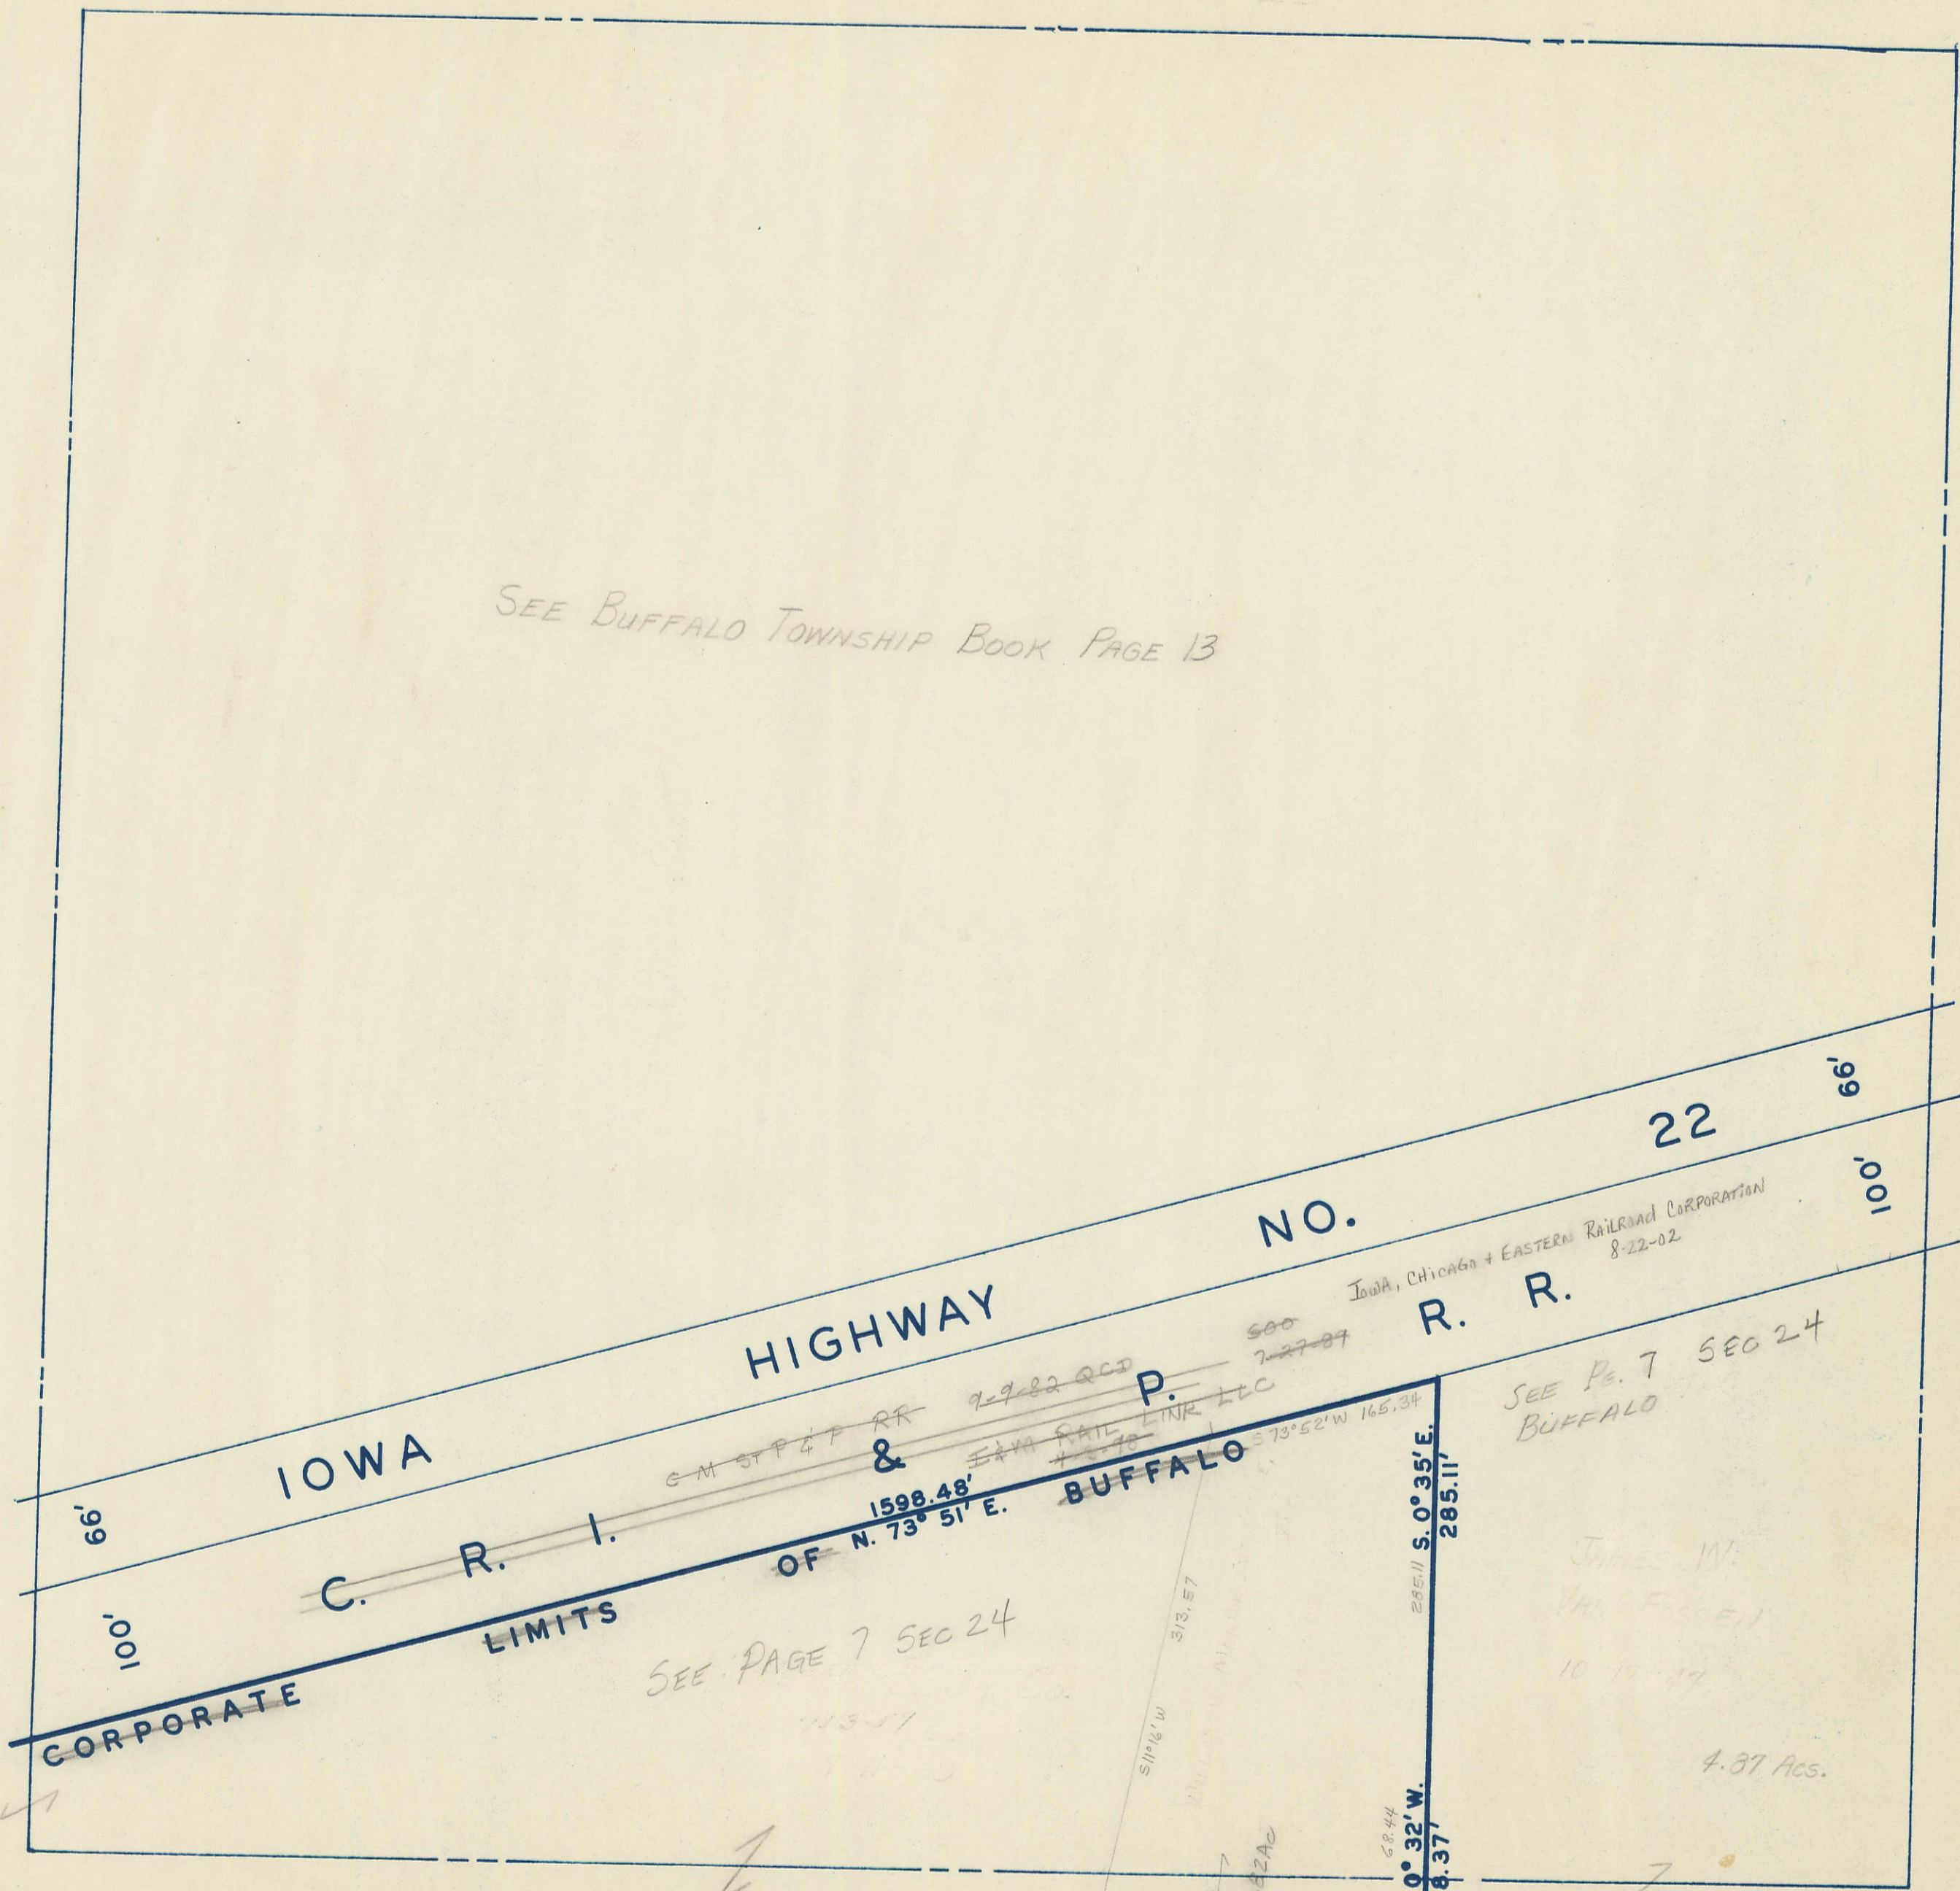

7 SEC. 24