


SE 1/4, SE 1/4 SEC. 16-77-2
TOWN OF BUFFALO
SCALE: 1" = 100'

(39)

Transfer Page 84 L.D.S.

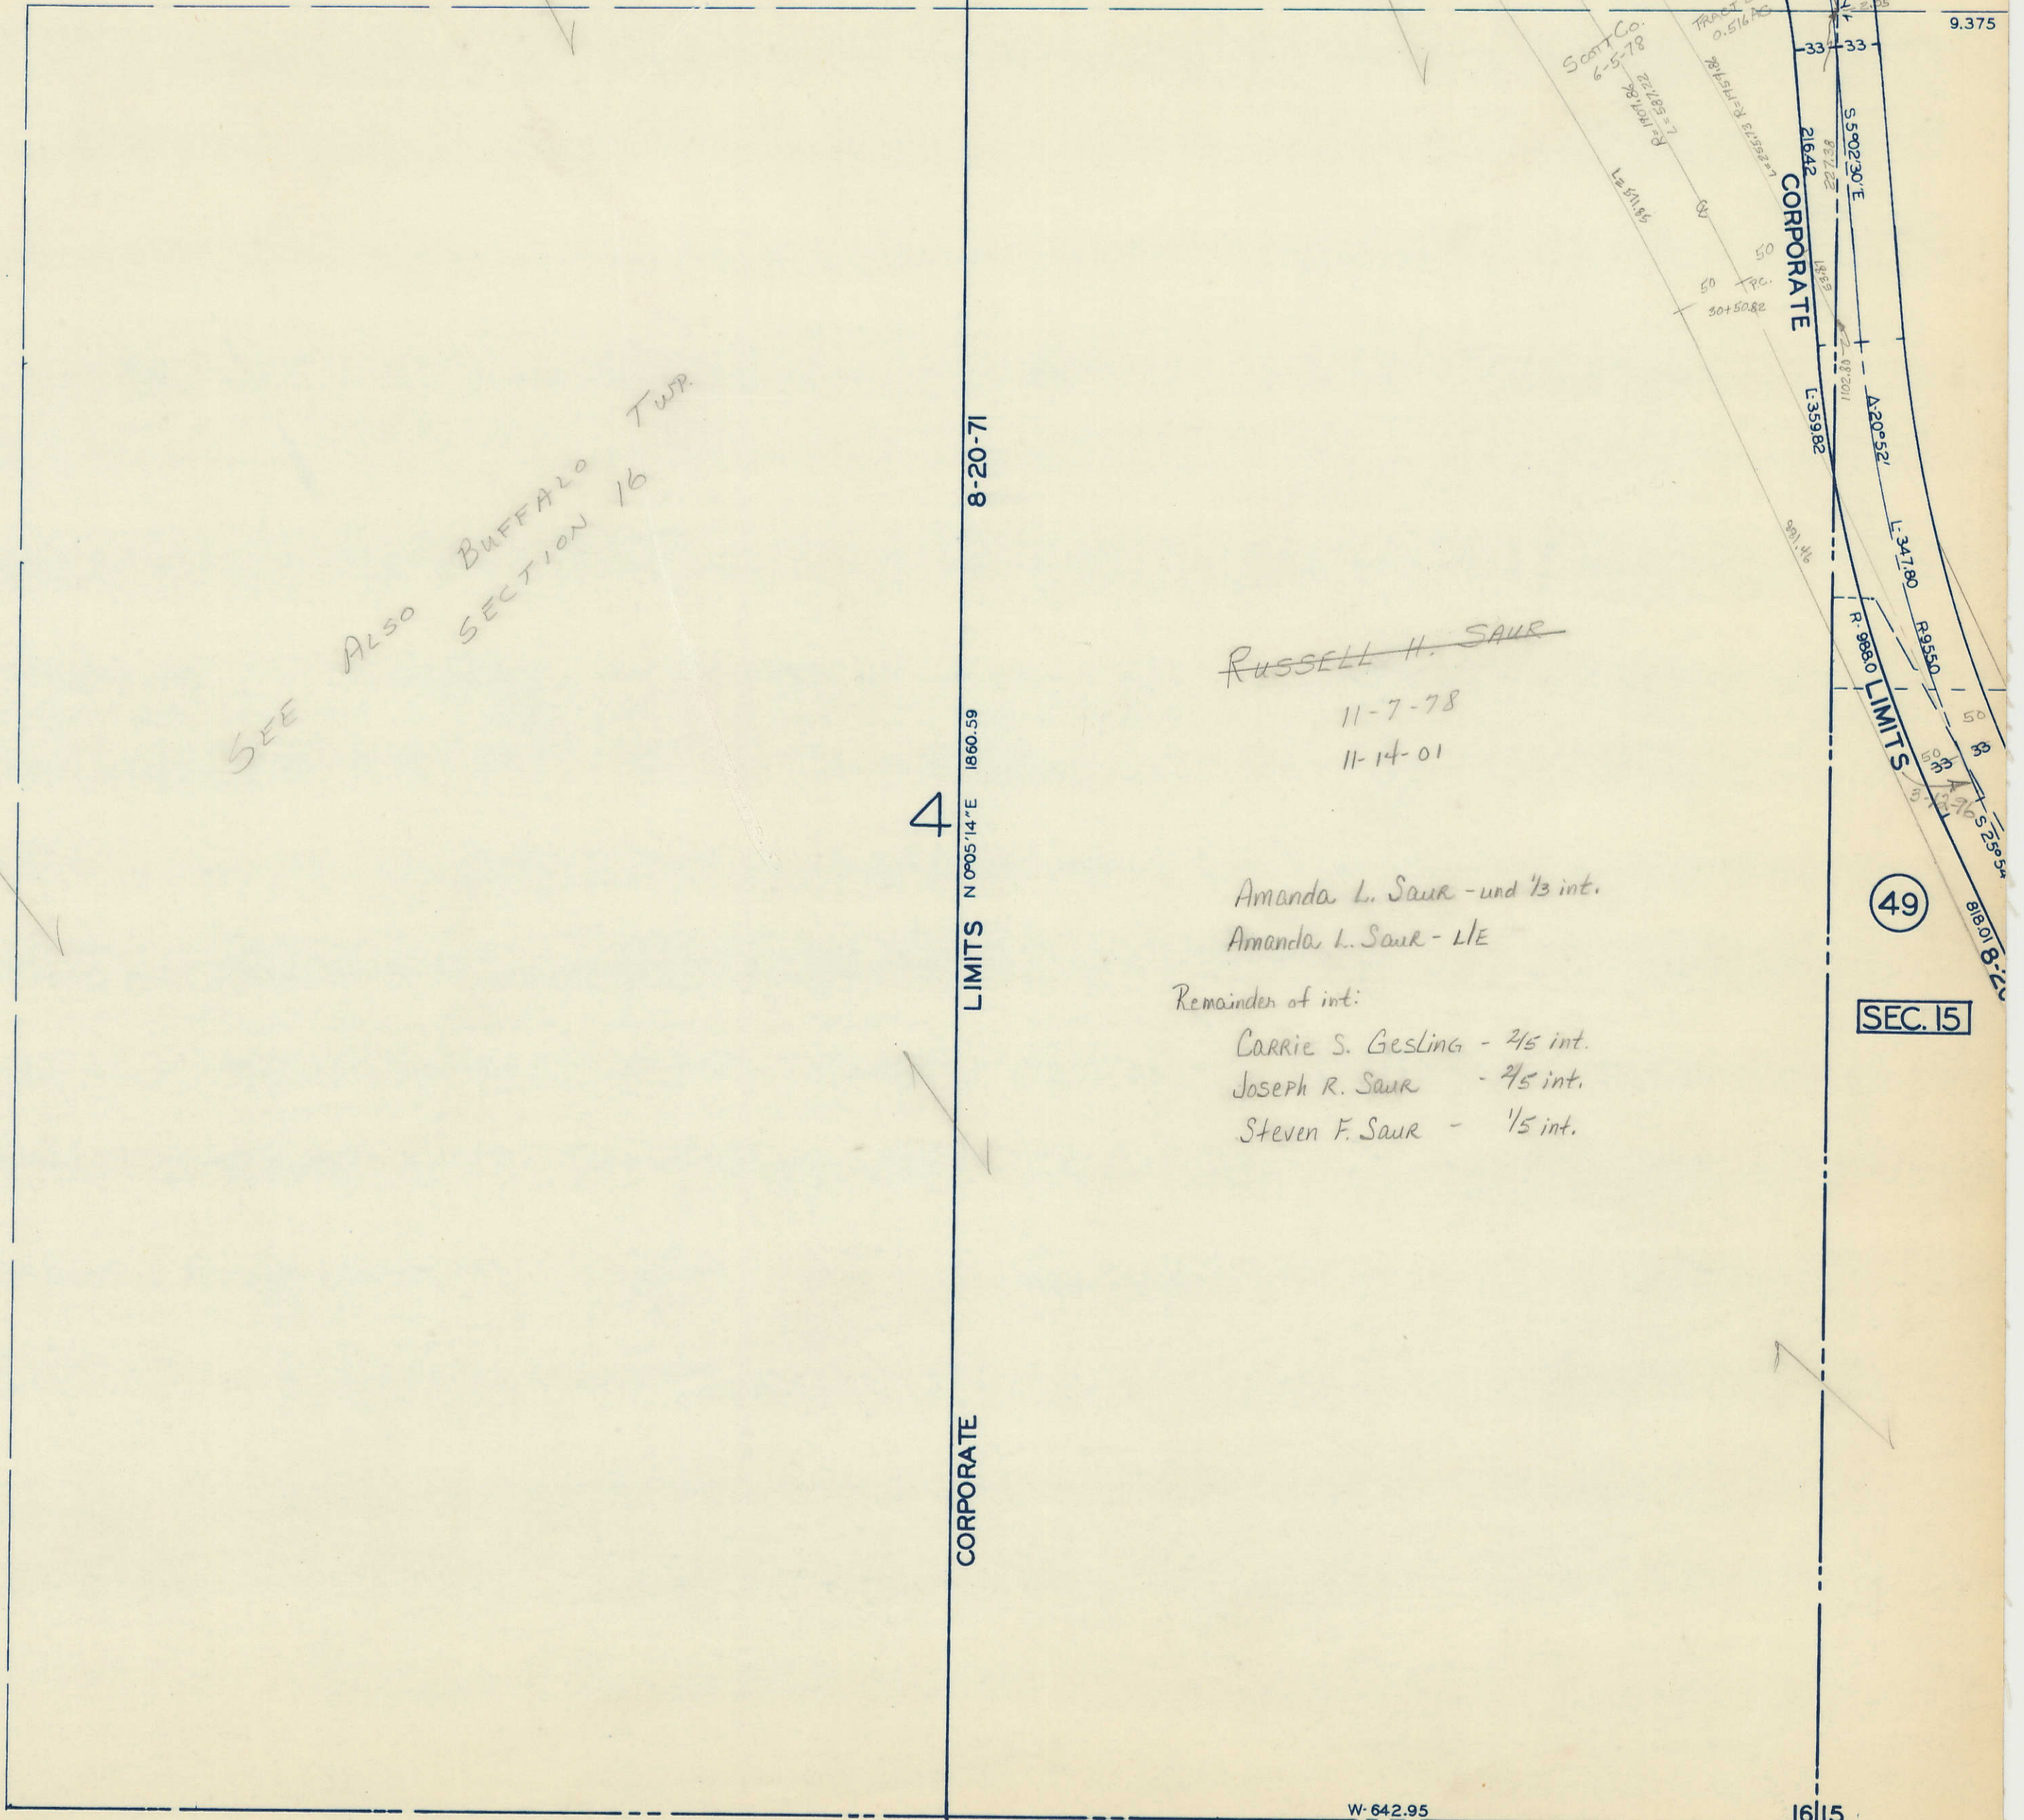

SEE ALSO BUFFALO TWP
SECTION 16

Twp.

8-20-71
4
LIMITS N 09°05'14"E 1860.59
CORPORATE

~~RUSSELL H. SAUR~~
11-7-78
11-14-01

Amanda L. Saur - und 1/3 int.
Remainder of int:
Carrie S. Gesling - 2/5 int.
Joseph R. Saur - 2/5 int.
Steven F. Saur - 1/5 int.

(49)

SEC. 15

SEC. 21

LOCUST GROVE ADD.
8 OUTLOT 24

W 642.95
396'
1615
2122

40
250'

N 3°33'09"E
198.50
196'