


35

Transfer Page 81 LANDS

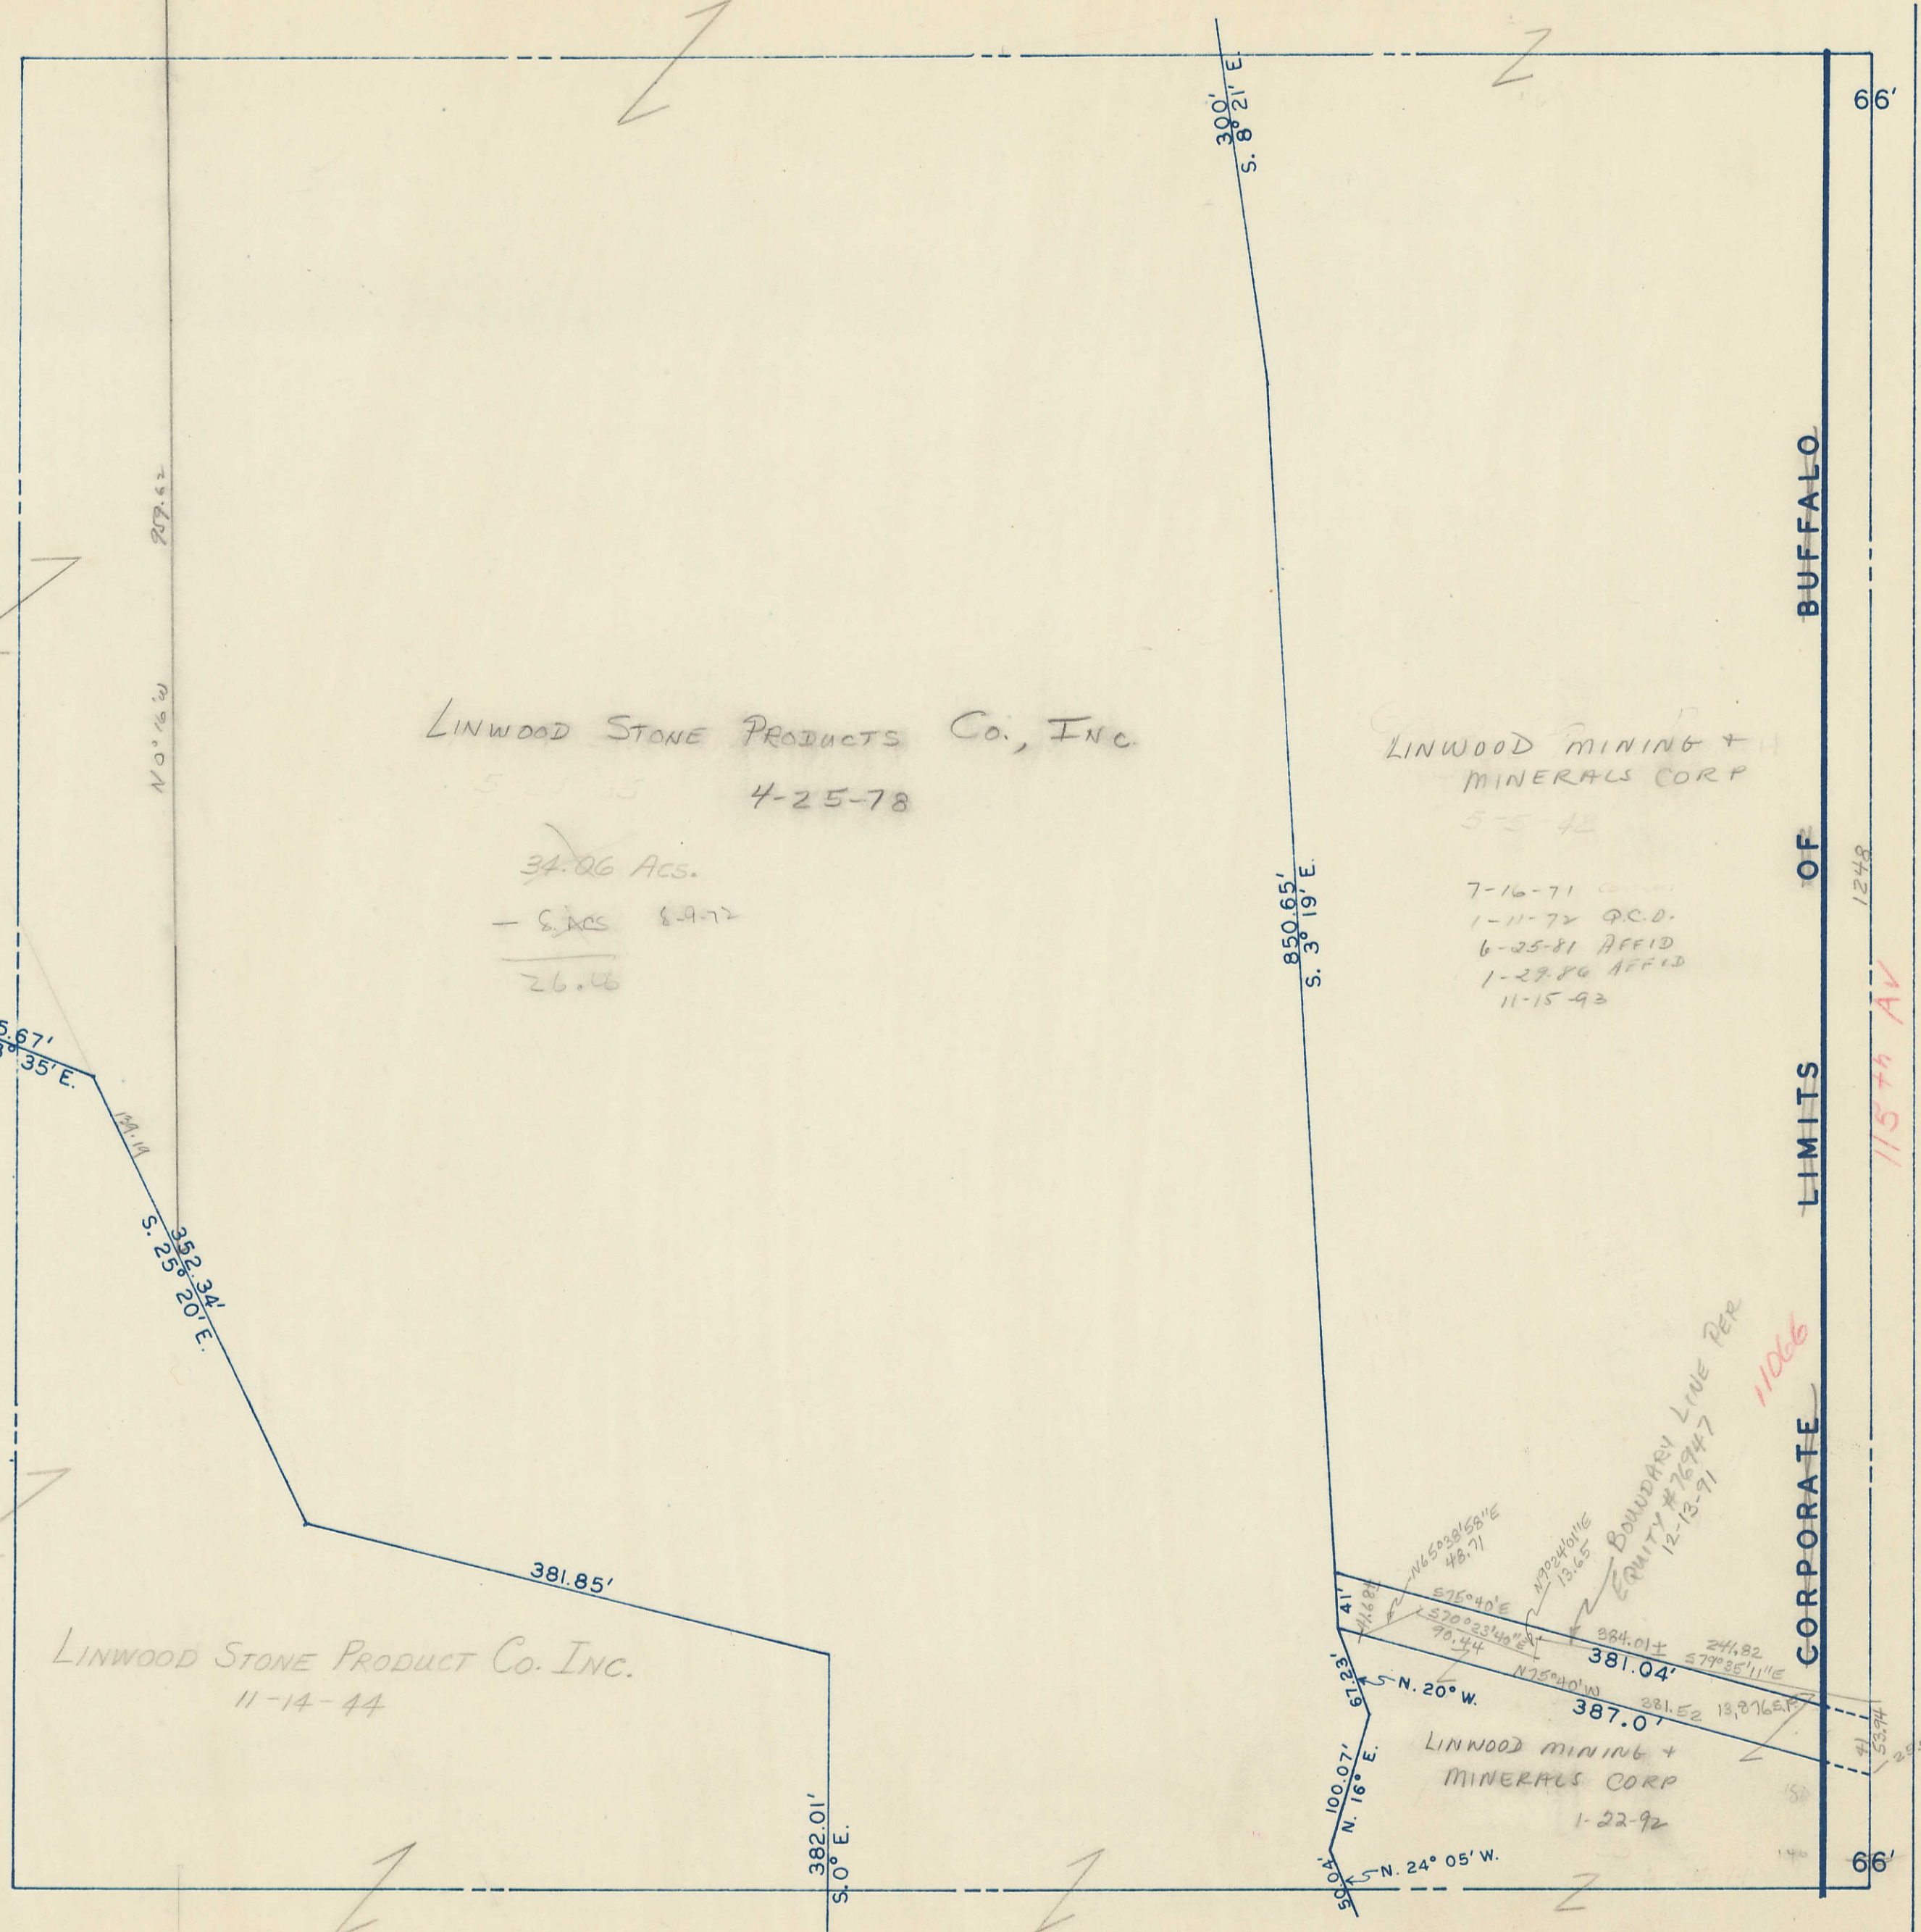

LINWOOD STONE PRODUCTS Co., Inc.

5-23-75 4-25-78

34.06 ACS.

- 8.1 ACS 8-9-72

26.06

LINWOOD MINING + MINERALS CORP

5-5-78

7-16-71  
1-11-72 Q.C.O.  
6-25-81 AFFID  
1-29-86 AFFID  
11-15-93

LINWOOD STONE PRODUCT Co. INC.

11-14-44

LINWOOD MINING + MINERALS CORP

1-22-92

CORPORATE LIMITS OF BUFFALO

1248

115th AV

49

53

3 SEC. 24