


SEC. 18-77-2

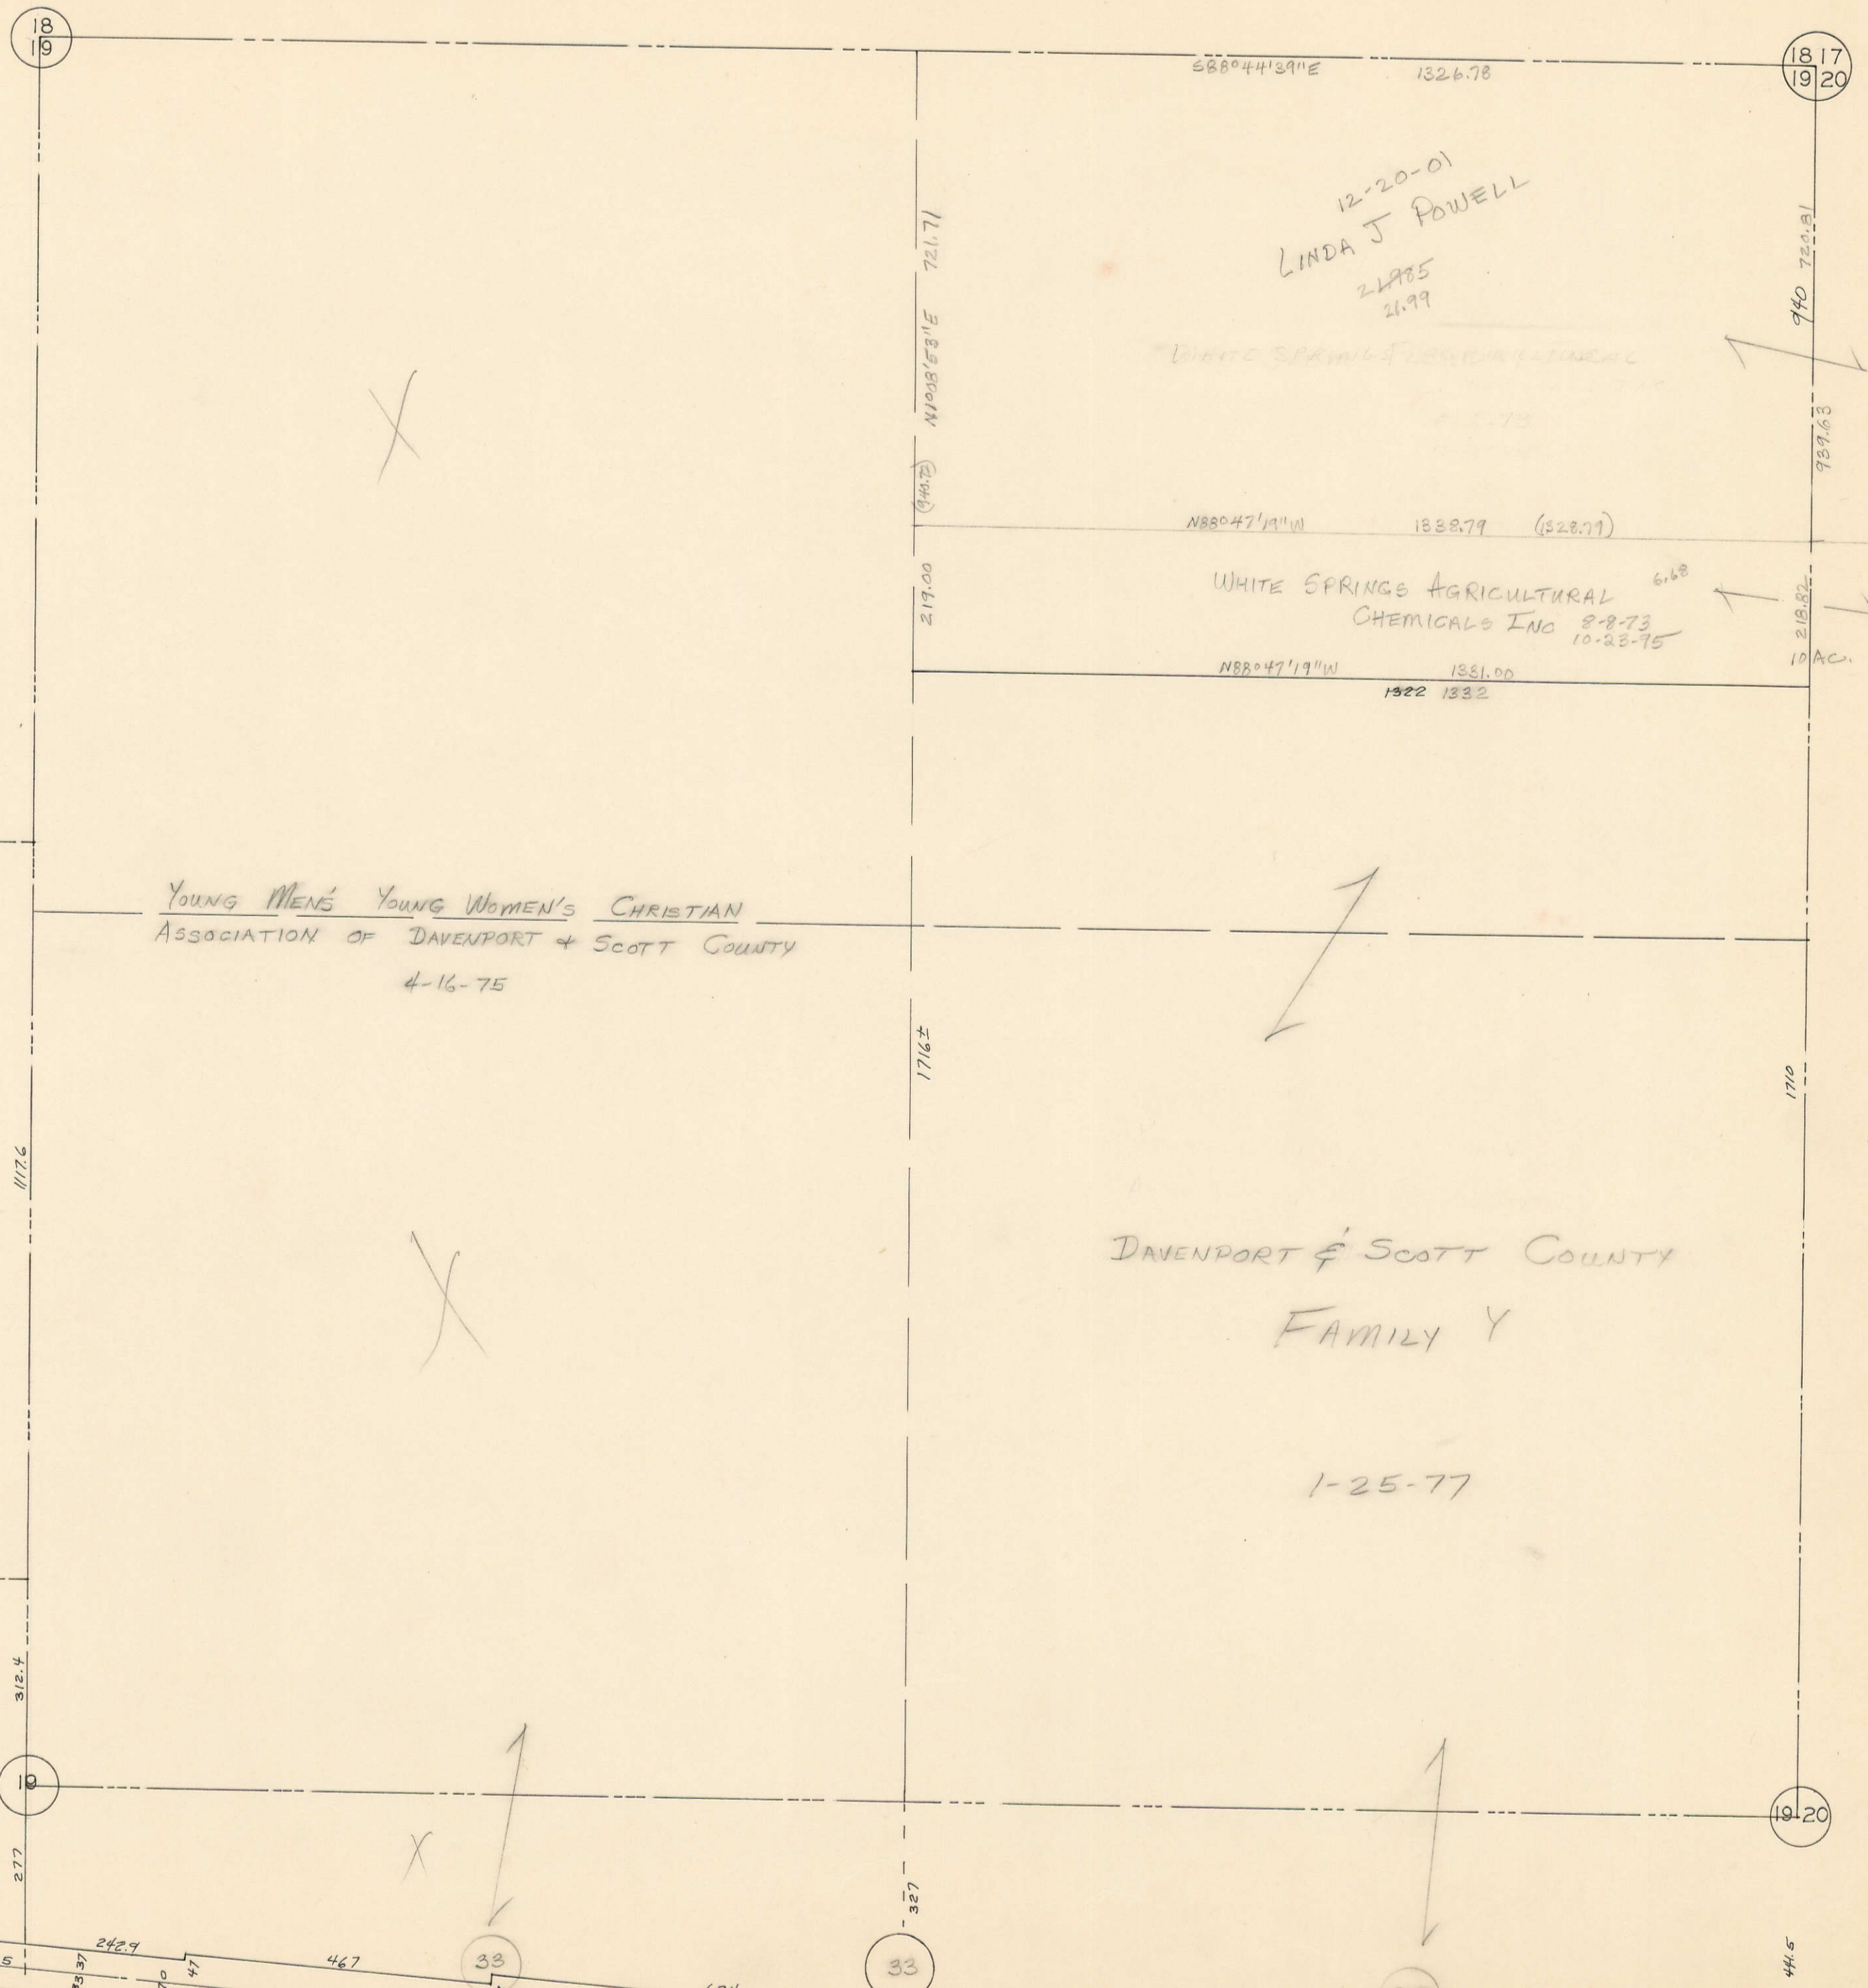

12-20-01
LINDA J POWELL
2-19-85
21.99

WHITE SPRINGS AGRICULTURAL
CHEMICALS INC

N88°47'19\"W 1838.79 (1828.79)

WHITE SPRINGS AGRICULTURAL
CHEMICALS INC 2-8-73
10-23-75
6.68
19 AC.

N88°47'19\"W 1331.00
1322 1332

YOUNG MEN'S YOUNG WOMEN'S CHRISTIAN
ASSOCIATION OF DAVENPORT & SCOTT COUNTY
4-16-75

DAVENPORT & SCOTT COUNTY
FAMILY Y
1-25-77

C.R.I. & P. RR.
Iowa Chicago & Eastern Railroad Car. 82202

IOWA HWY. 22

RIVER ROAD