


NW 1/4 SEC. 24-77-2  
SCALE: 1" = 200'

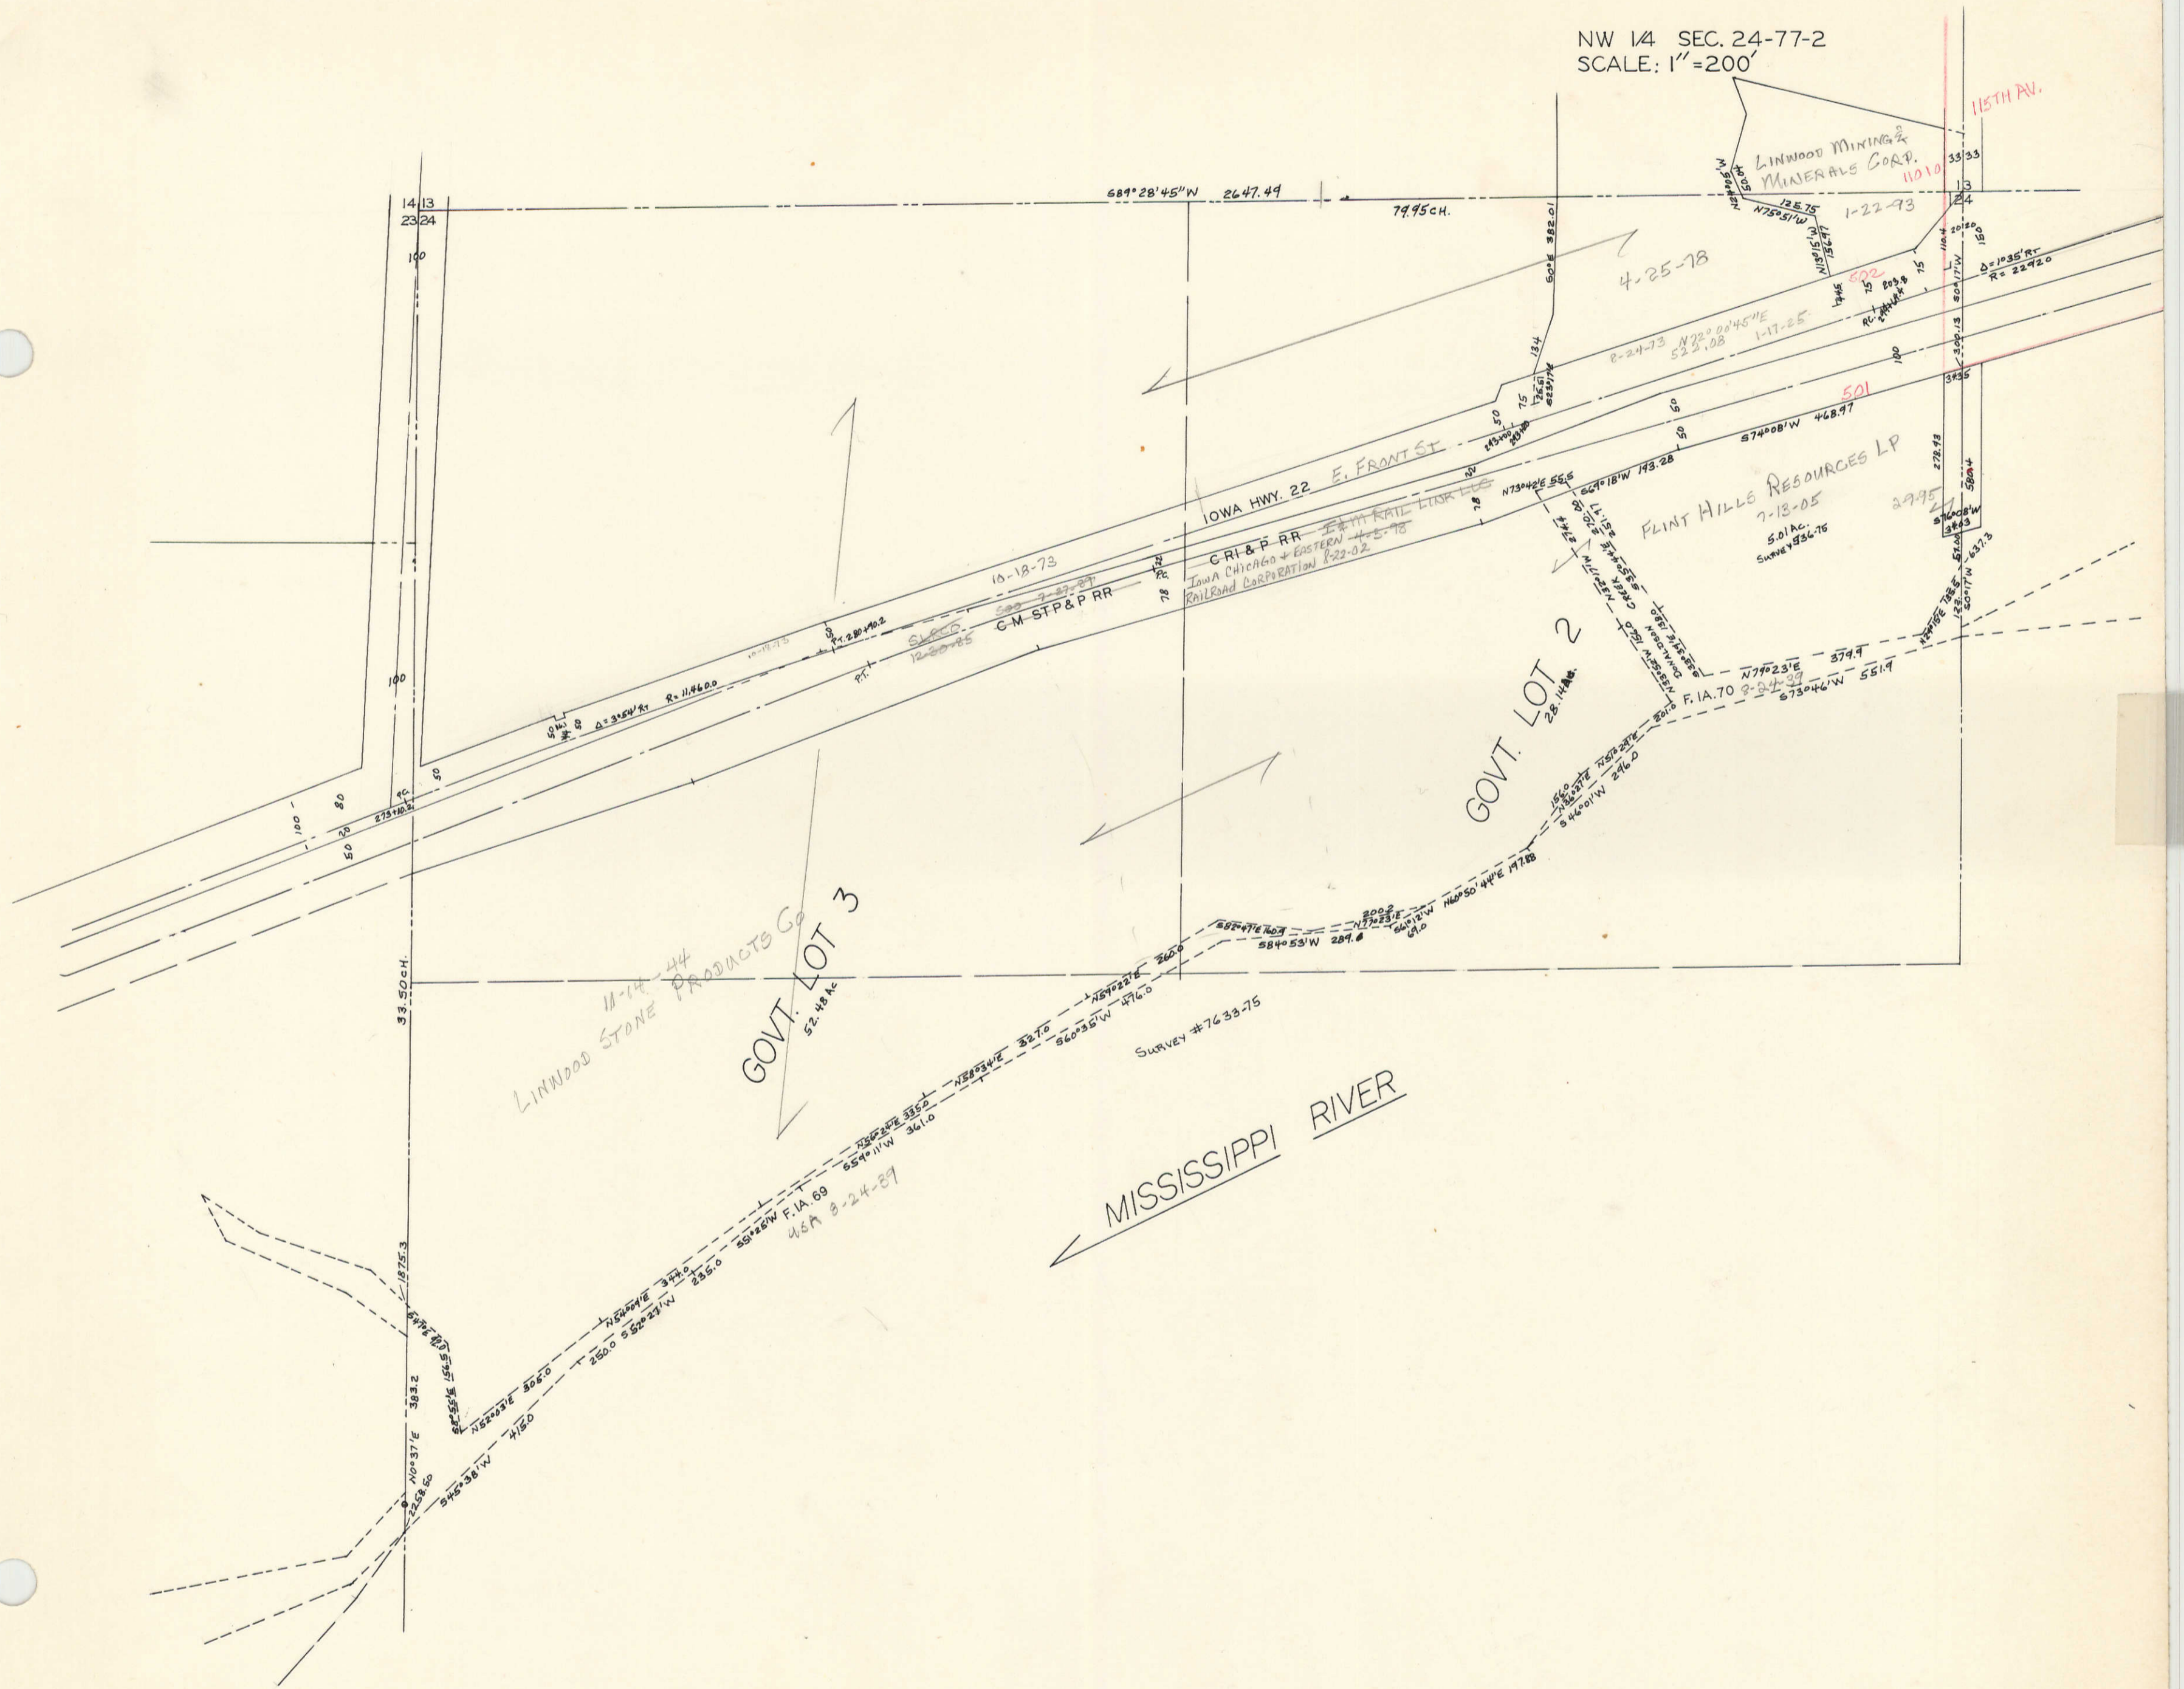

Sec 24-77-2