


Transfer Page 87 LANDS

SE 1/4 SEC. 19-77-2  
SCALE: 1" = 200'

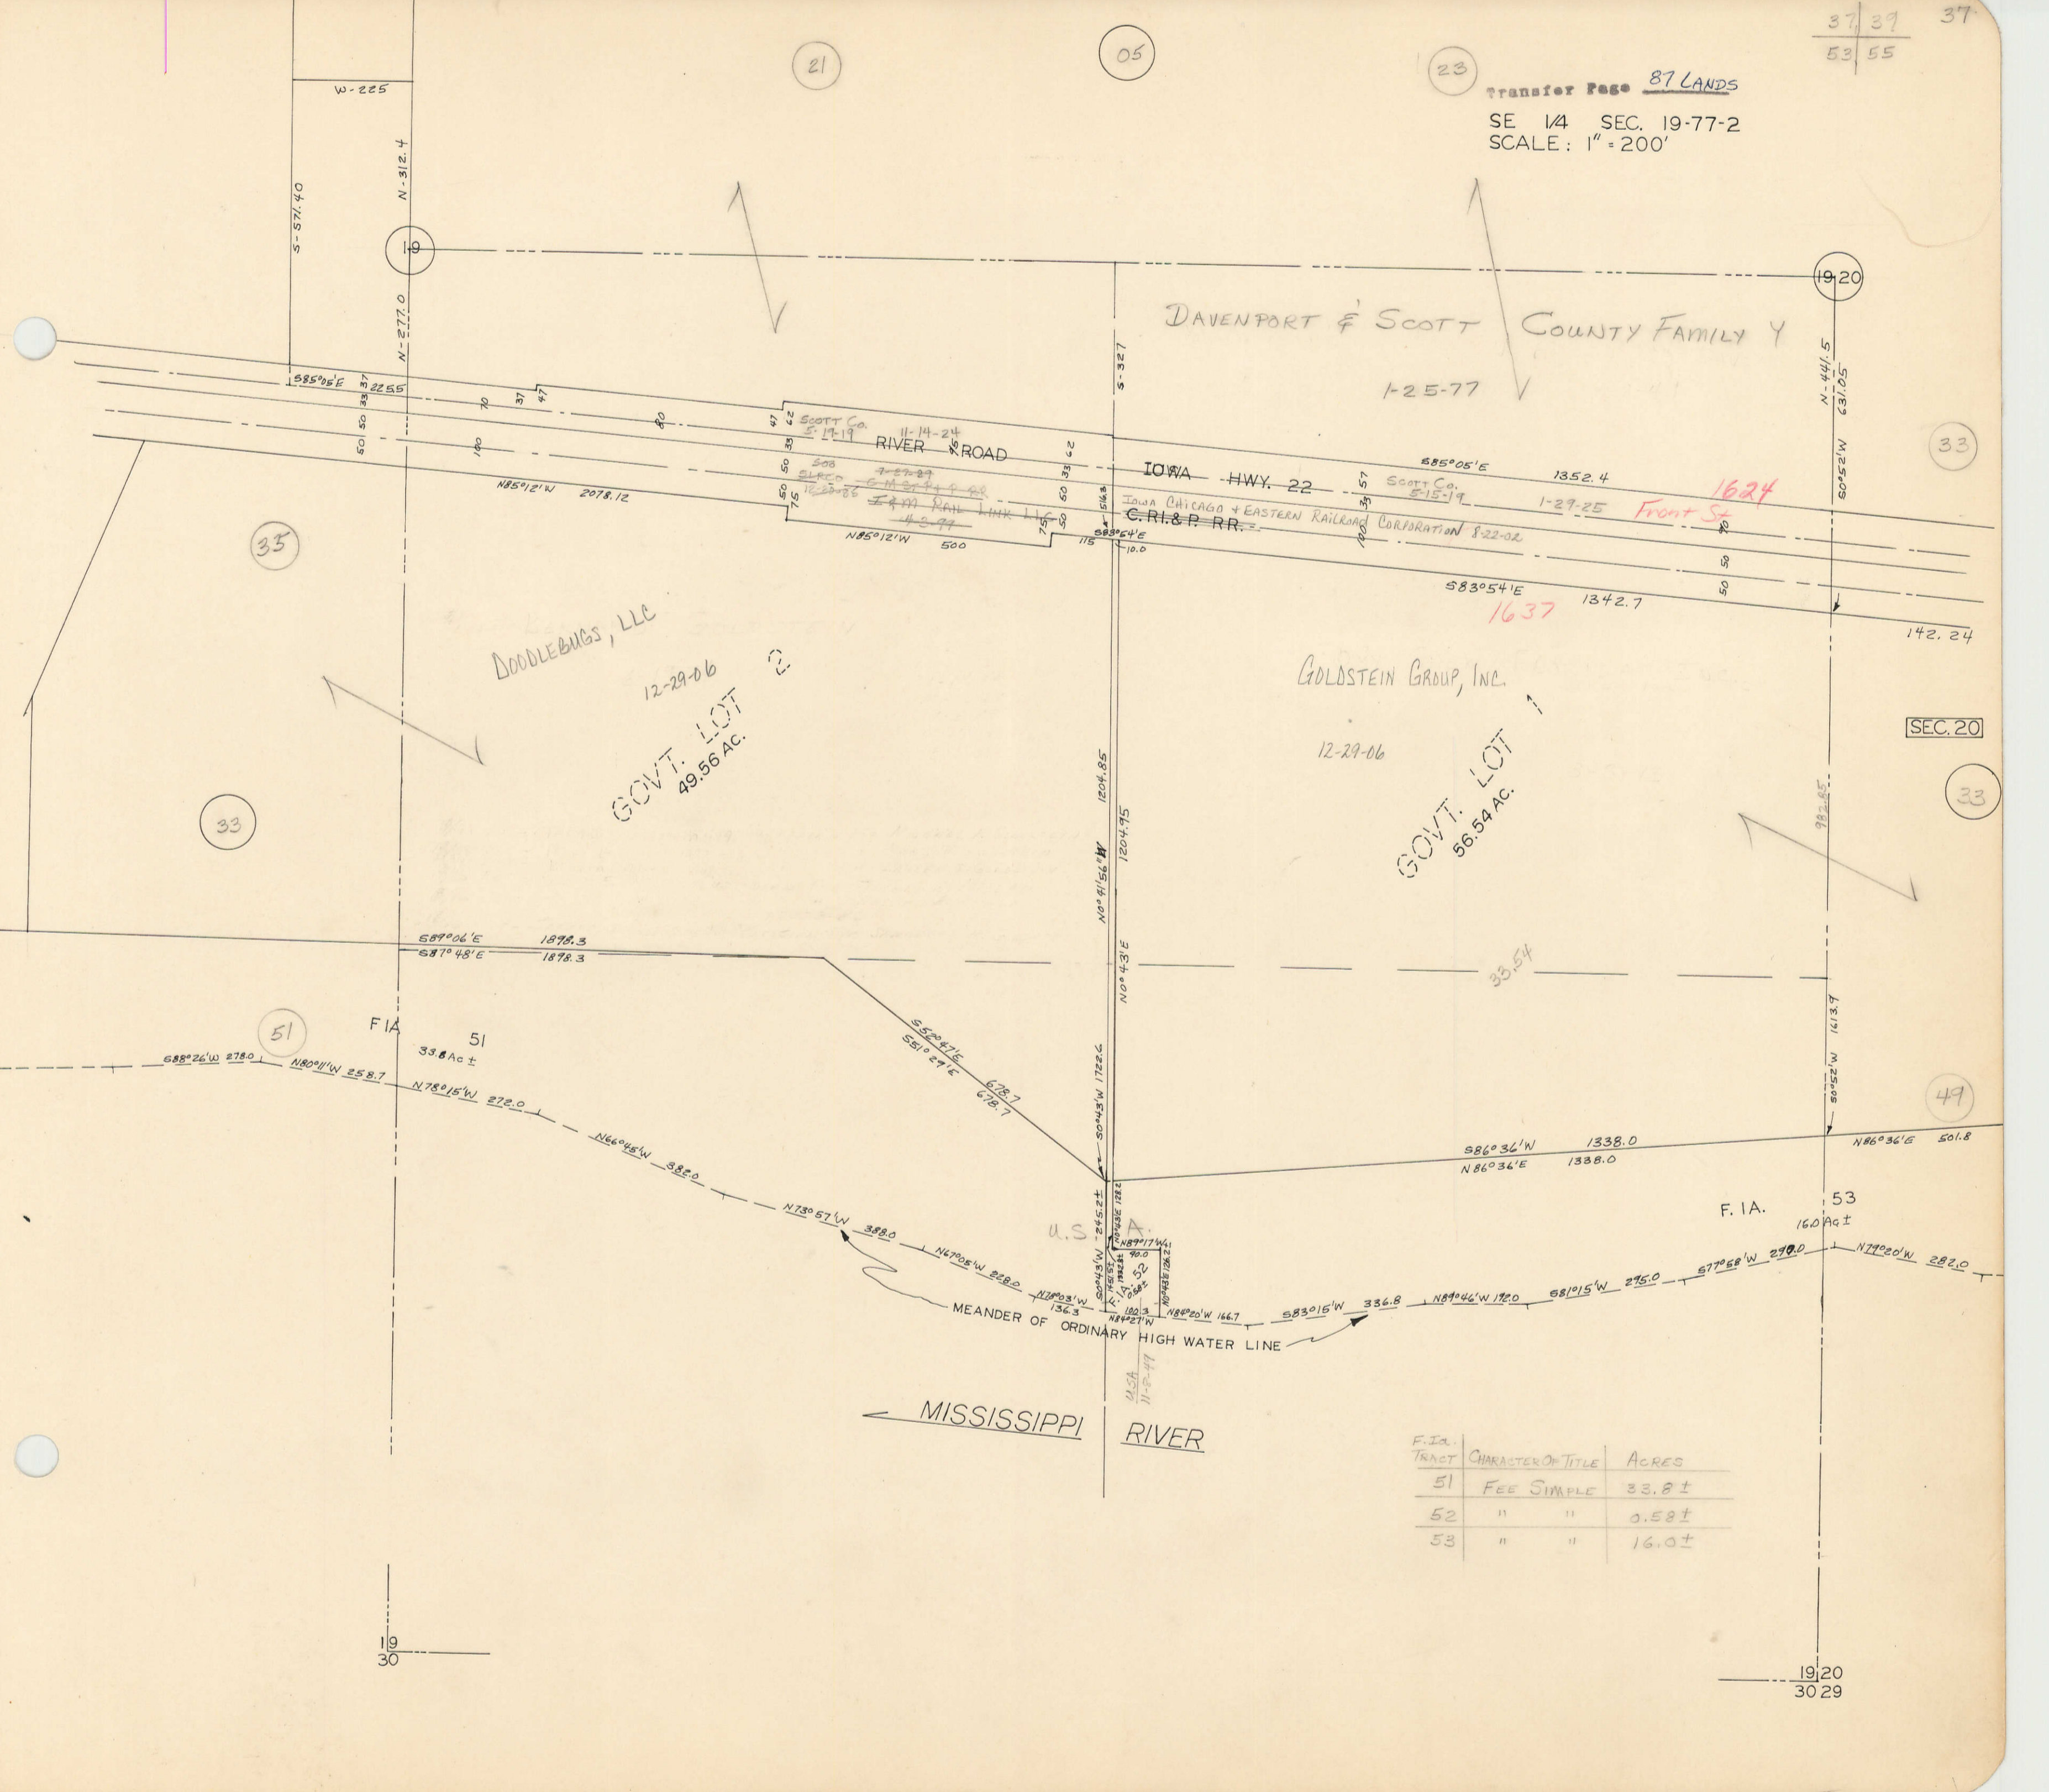

F.I.A. TRACT	CHARACTER OF TITLE	ACRES
51	FEE SIMPLE	33.8 ±
52	" "	0.58 ±
53	" "	16.0 ±